



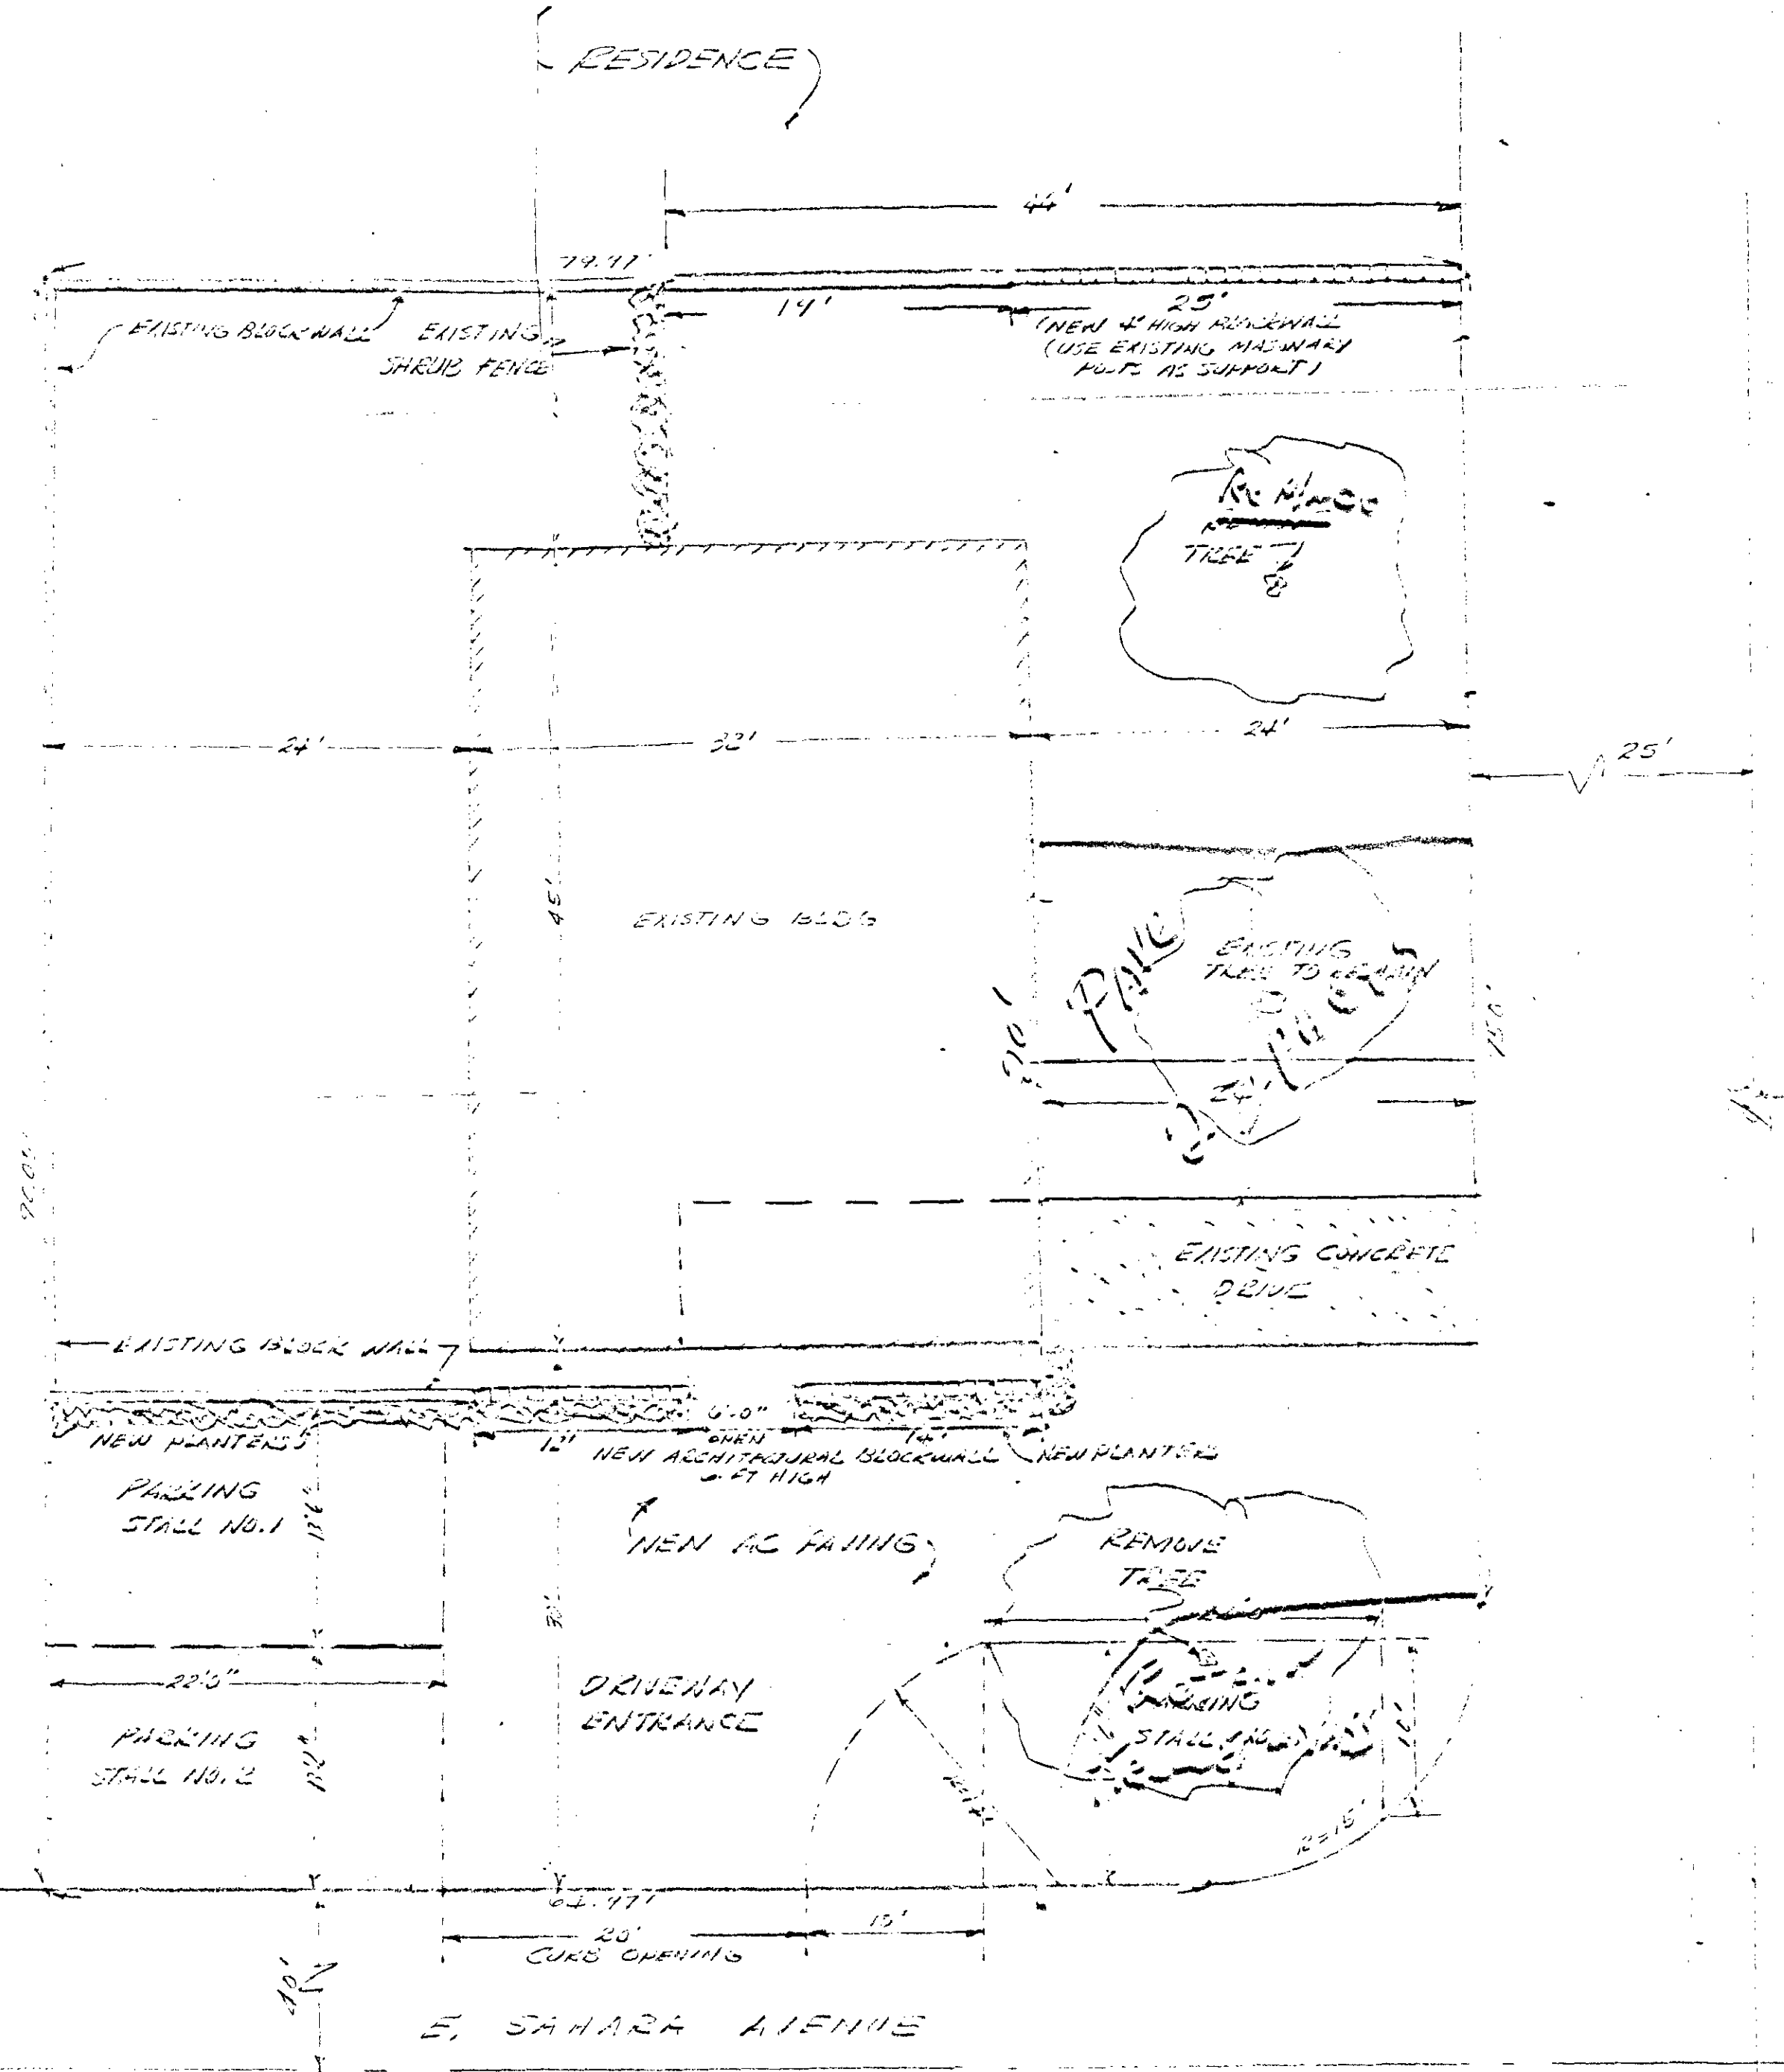

- WORK TO BE DONE
1. NEW AC PAVING (2" THICK) 2015 S.F.
 2. ARCHITECTURAL BLOCK WALL - 26 L.F. 6 FT HIGH
 3. BLOCK WALL FENCE - 25 L.F. 4 FT HIGH
 4. REMOVE TWO TREES

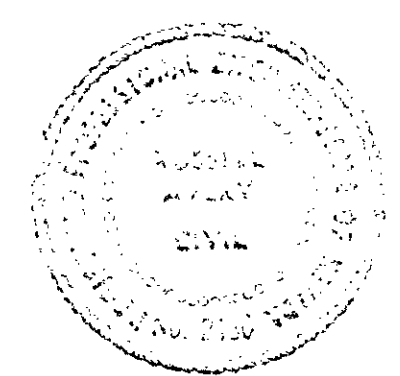

IMPROVEMENT PLAN
OF
303 EAST SAHARA PROPERTY
(FORMERLY 2412 SANTA PAULA DR.)
FOR
JUDY NESS REALTY
AND
AVERY AND ASSOCIATES
LAS VEGAS, NEVADA
DECEMBER, 1963

