

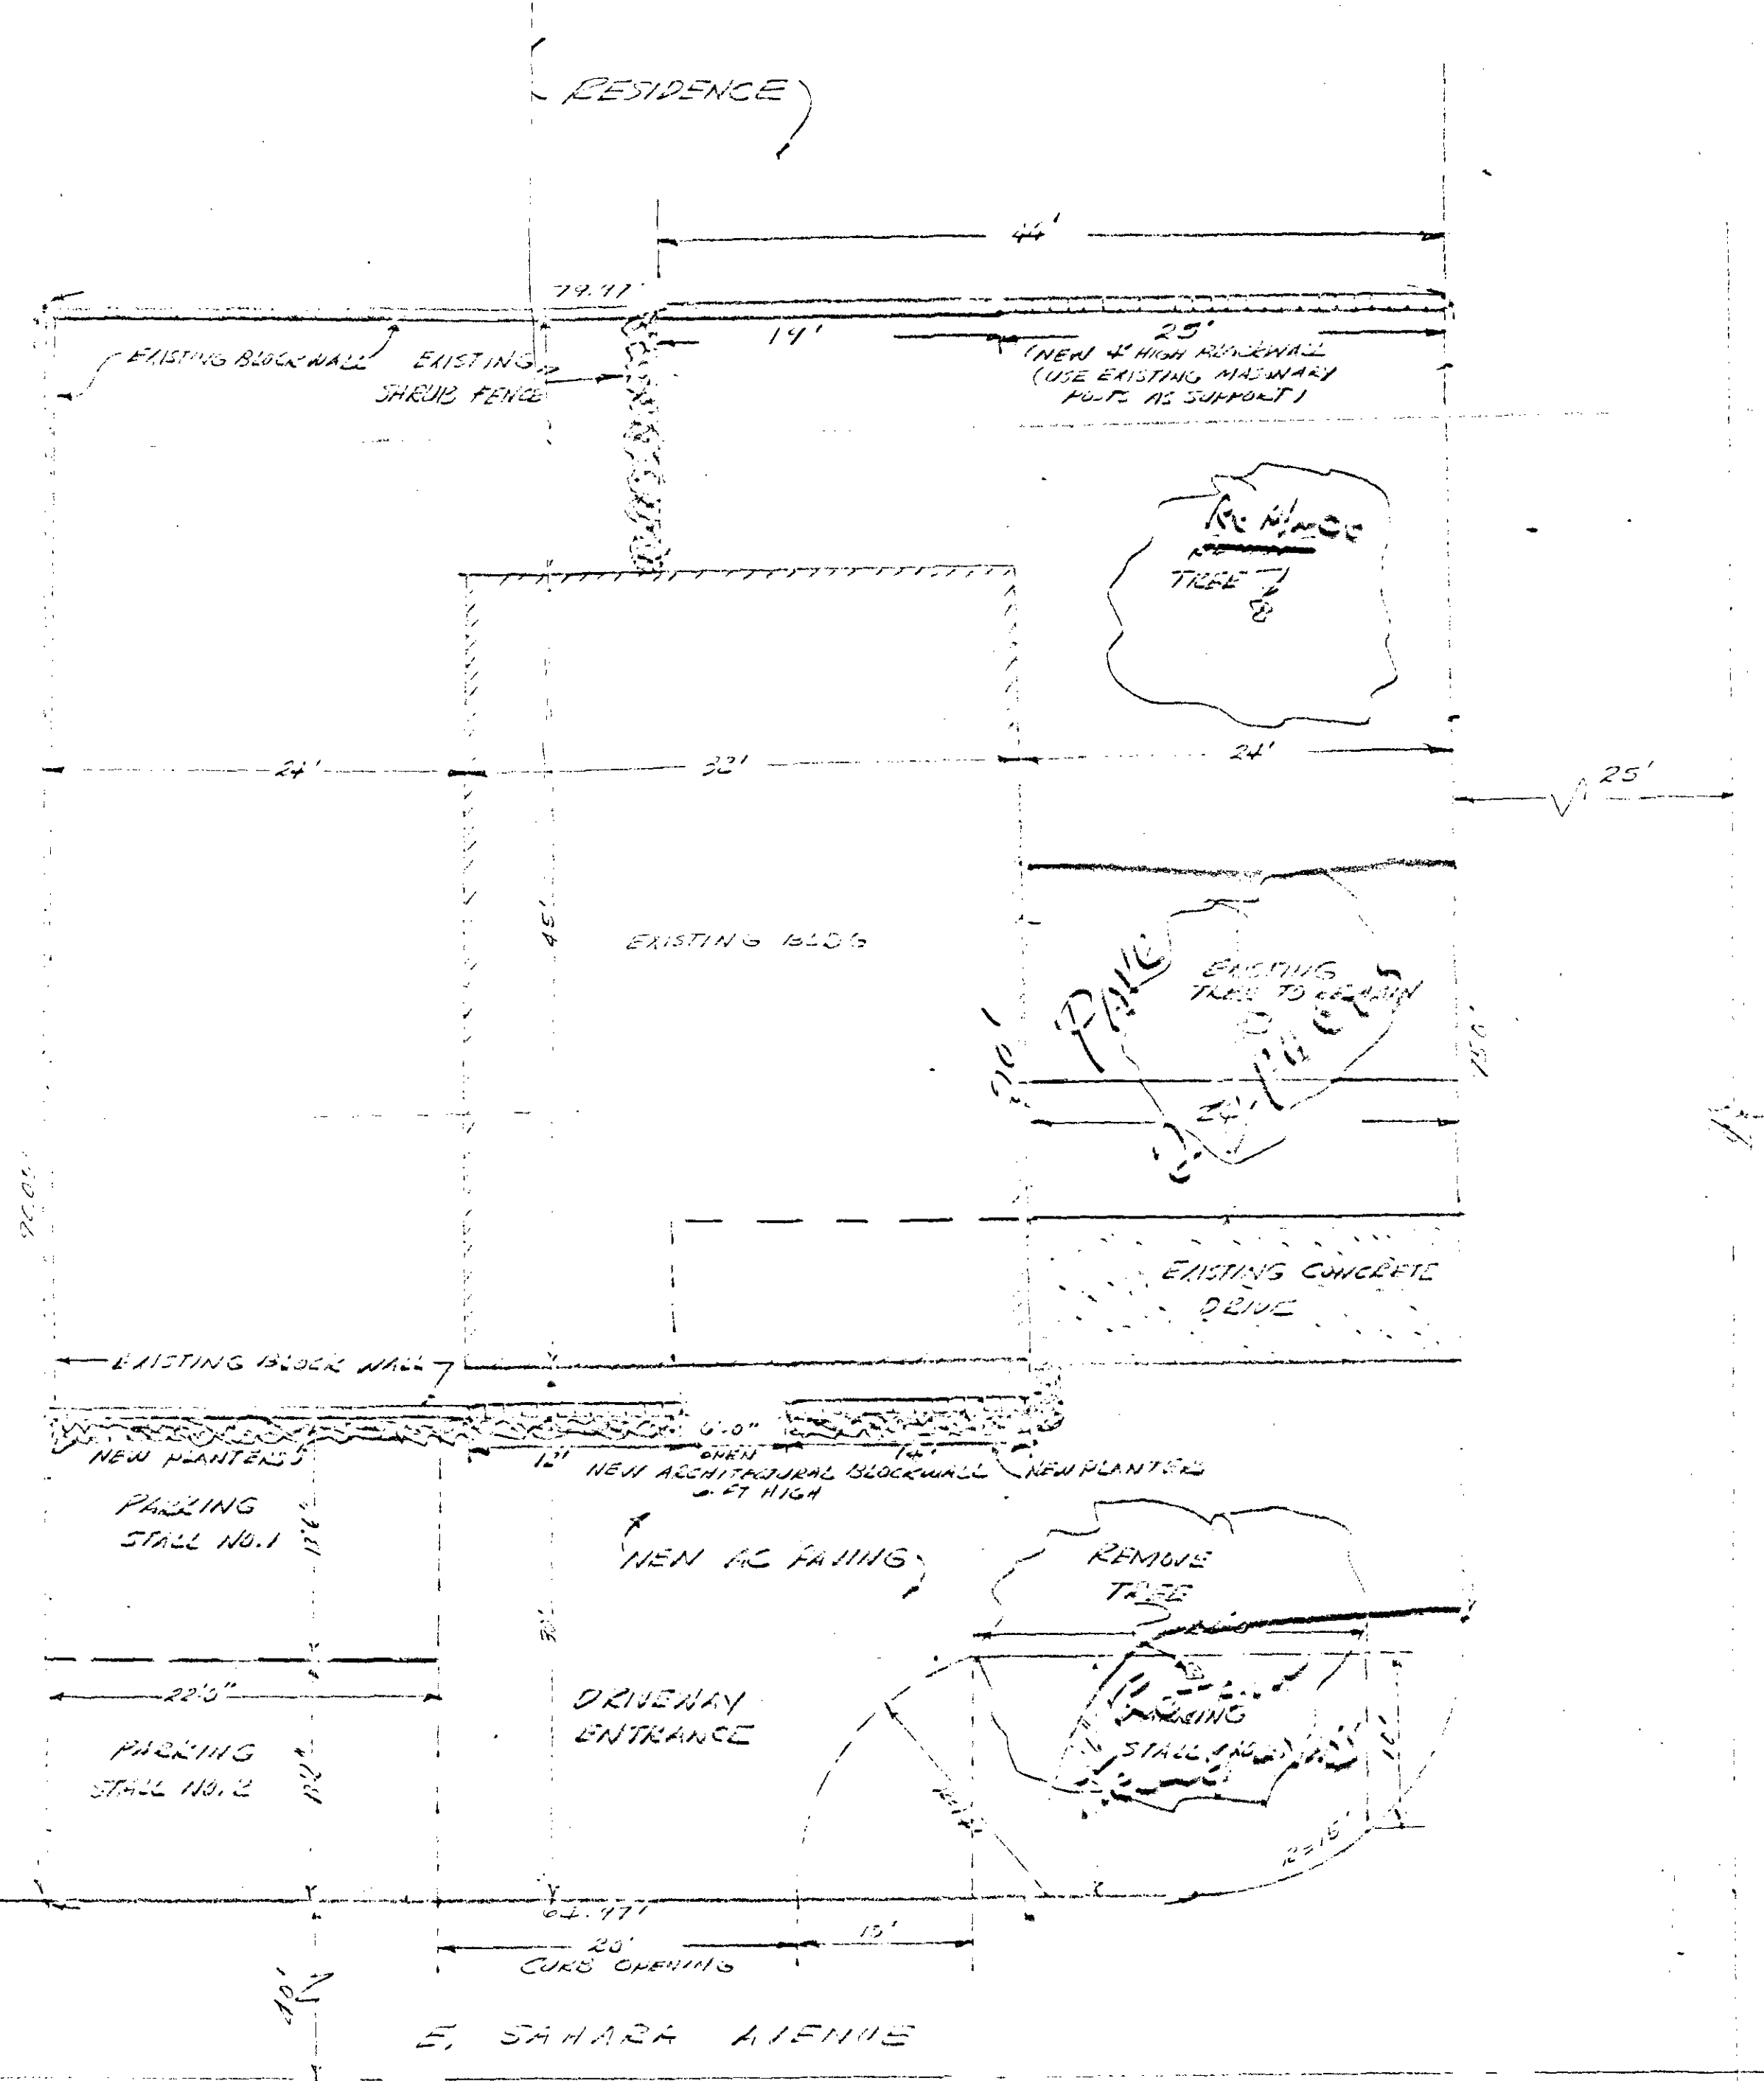


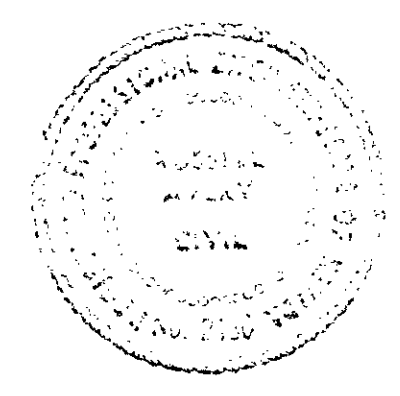

- WORK TO BE DONE
1. NEW AC PAVING (2\"/>

ANIMAL  
MEMORIAL  
HOSPITAL

SANTA PAULA DRIVE

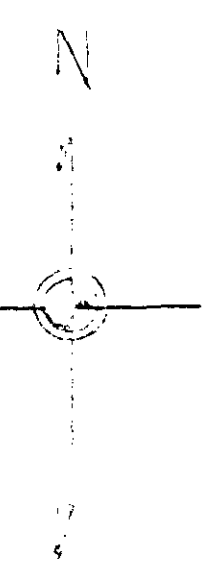

IMPROVEMENT PLAN  
OF  
303 EAST SAHARA PROPERTY  
(FORMERLY 2412 SANTA PAULA DR.)  
FOR  
JUDY NESS REALTY  
AND  
AVERY AND ASSOCIATES  
LAS VEGAS, NEVADA  
DECEMBER, 1963

AVERY AND ASSOCIATES  
