


PLAN SCALE 1/4" = 1'-0"

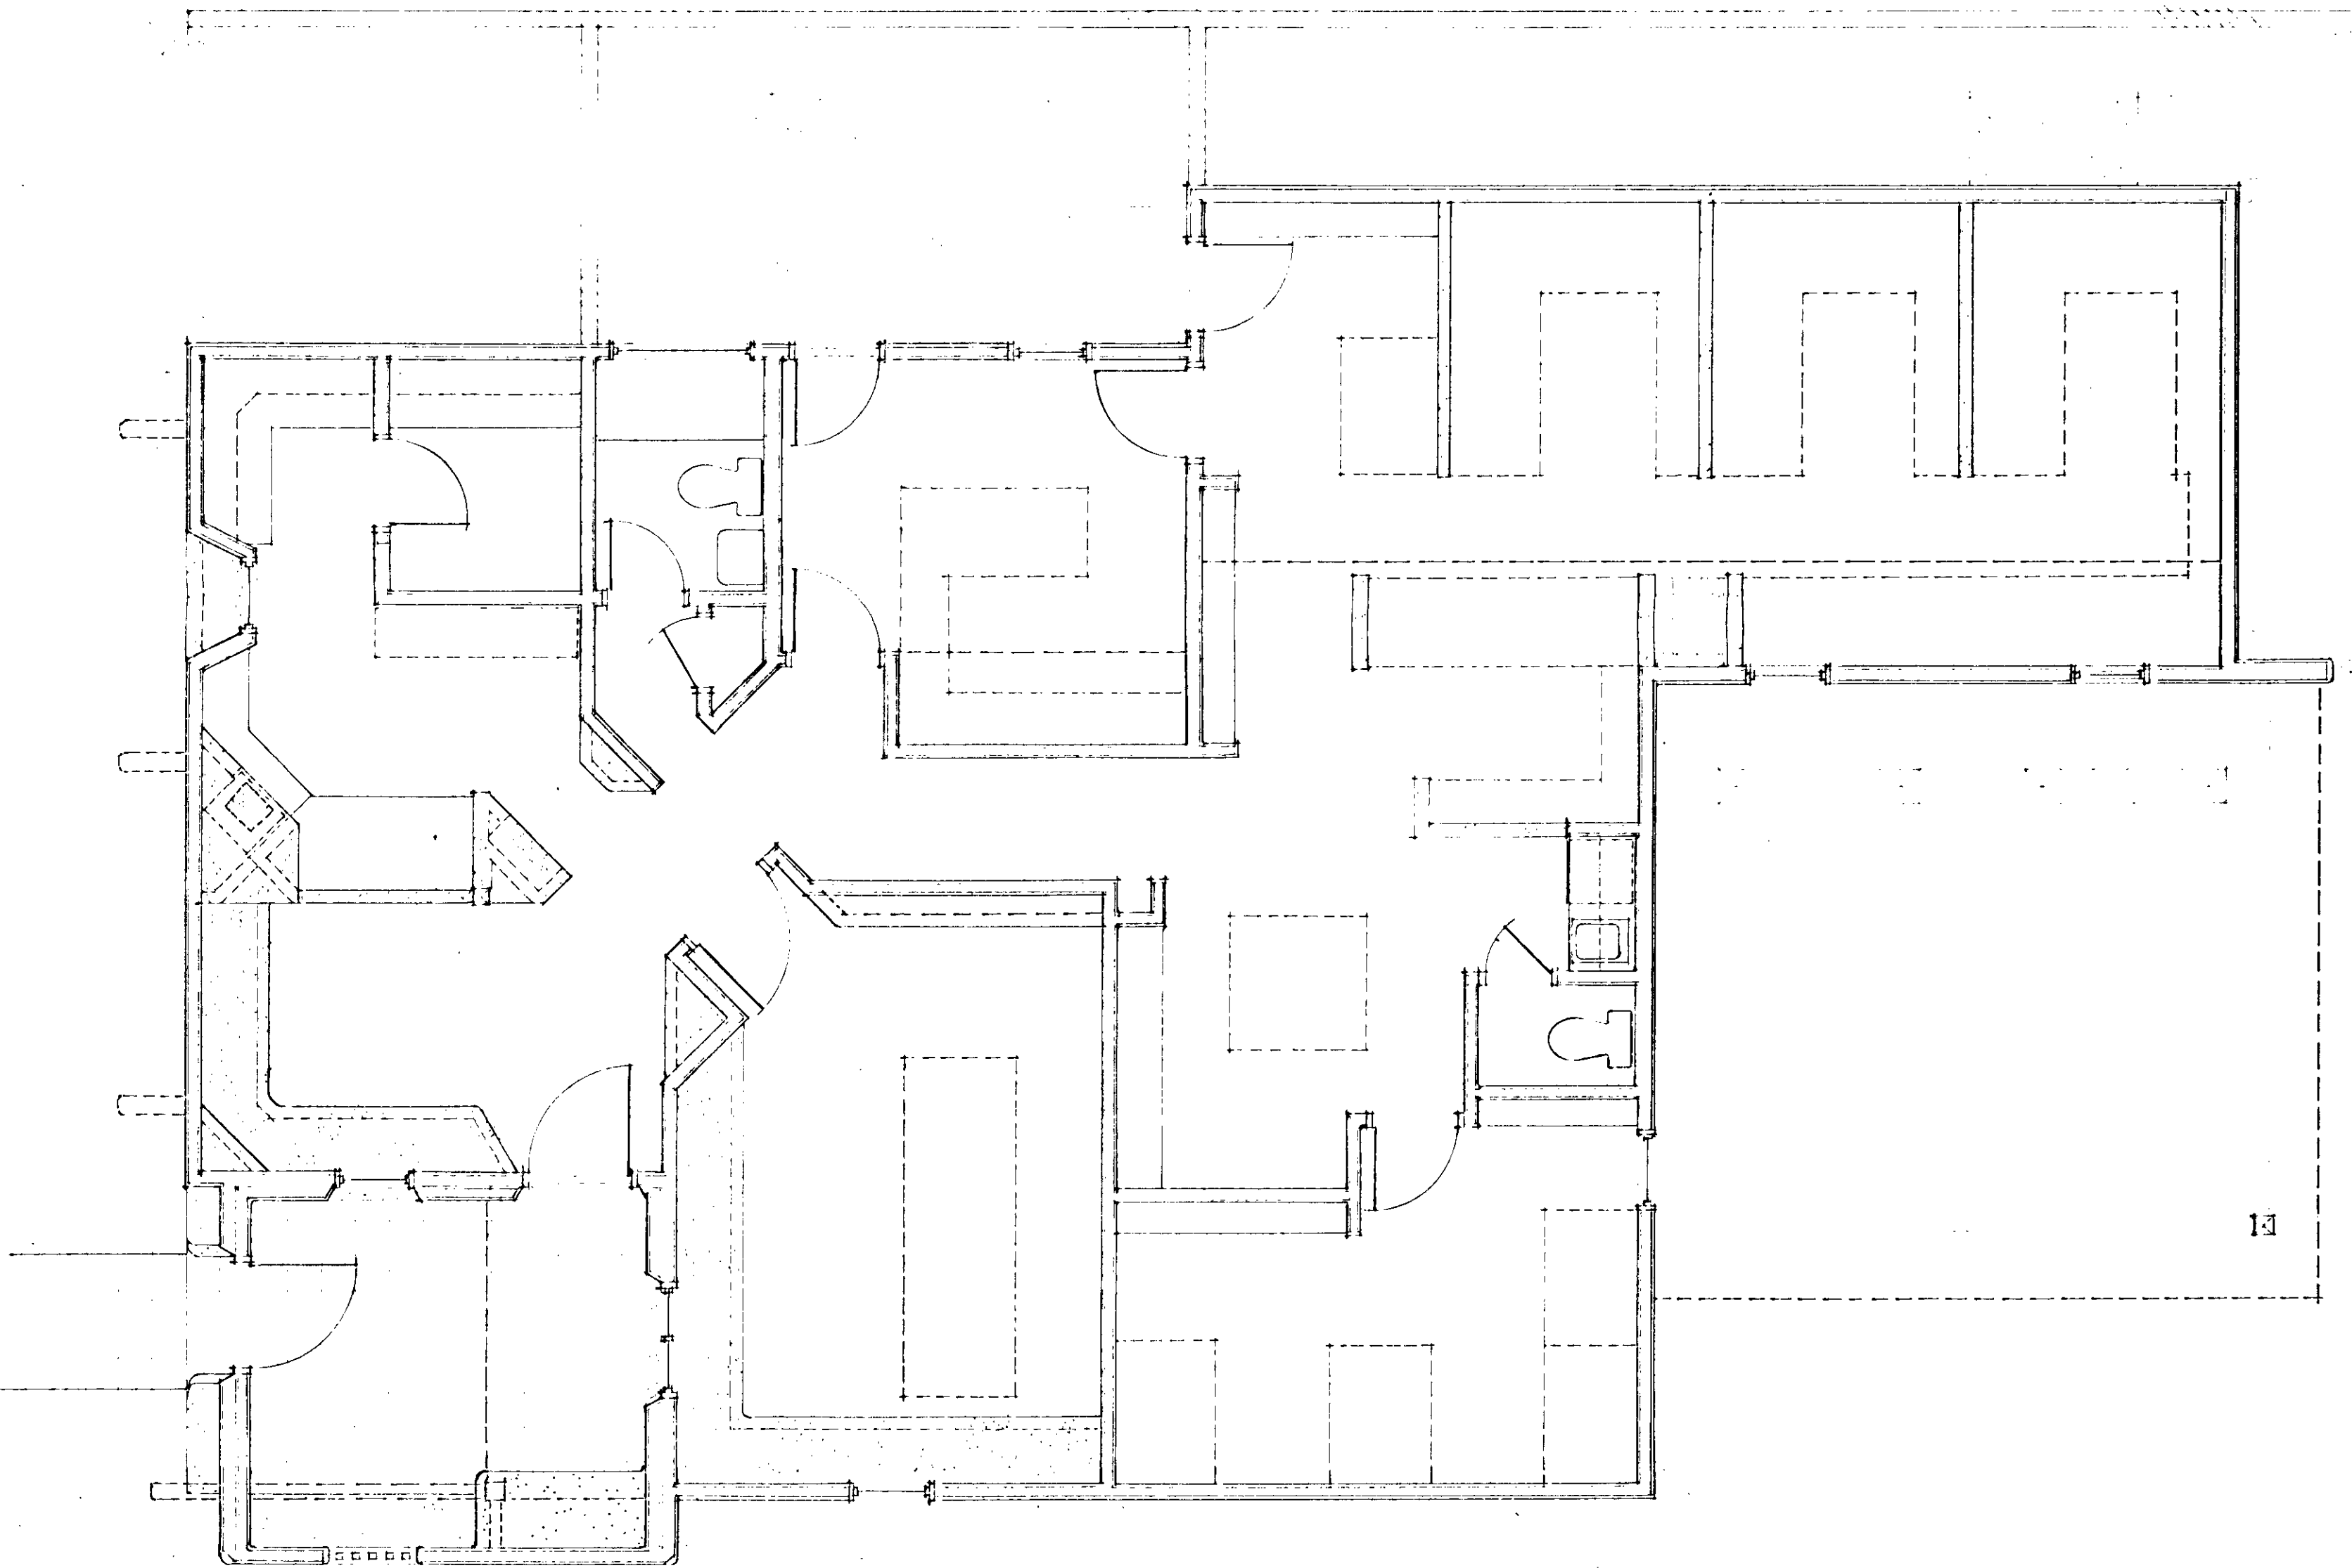

NORTH

SHEET NO.

28

APR
OF
DATE 1/24/91

OFFICE ADDITION & REMODEL

1415 MARYLAND PKWY,

LAS VEGAS NV

FOR ERROL HILL ARCHITECT LTD.



J.R.R.O.L. ARCHITECTS LTD.

1511 MARYLAND PKWY, LAS VEGAS NV 89104 385-2723


REVISION

AFN
OF
DATE 7/17/71

NEW OFFICE BUILDING
1435 MARYLAND PKWY,
LAS VEGAS NV
J.R.O. J.B.J. ARCHITECT LTD.
1511 MARYLAND PKWY, LAS VEGAS NV 89106 385-2723
FOR EEROL HILL ARCHITECT LTD.

SHEET NO. 1

REVISION

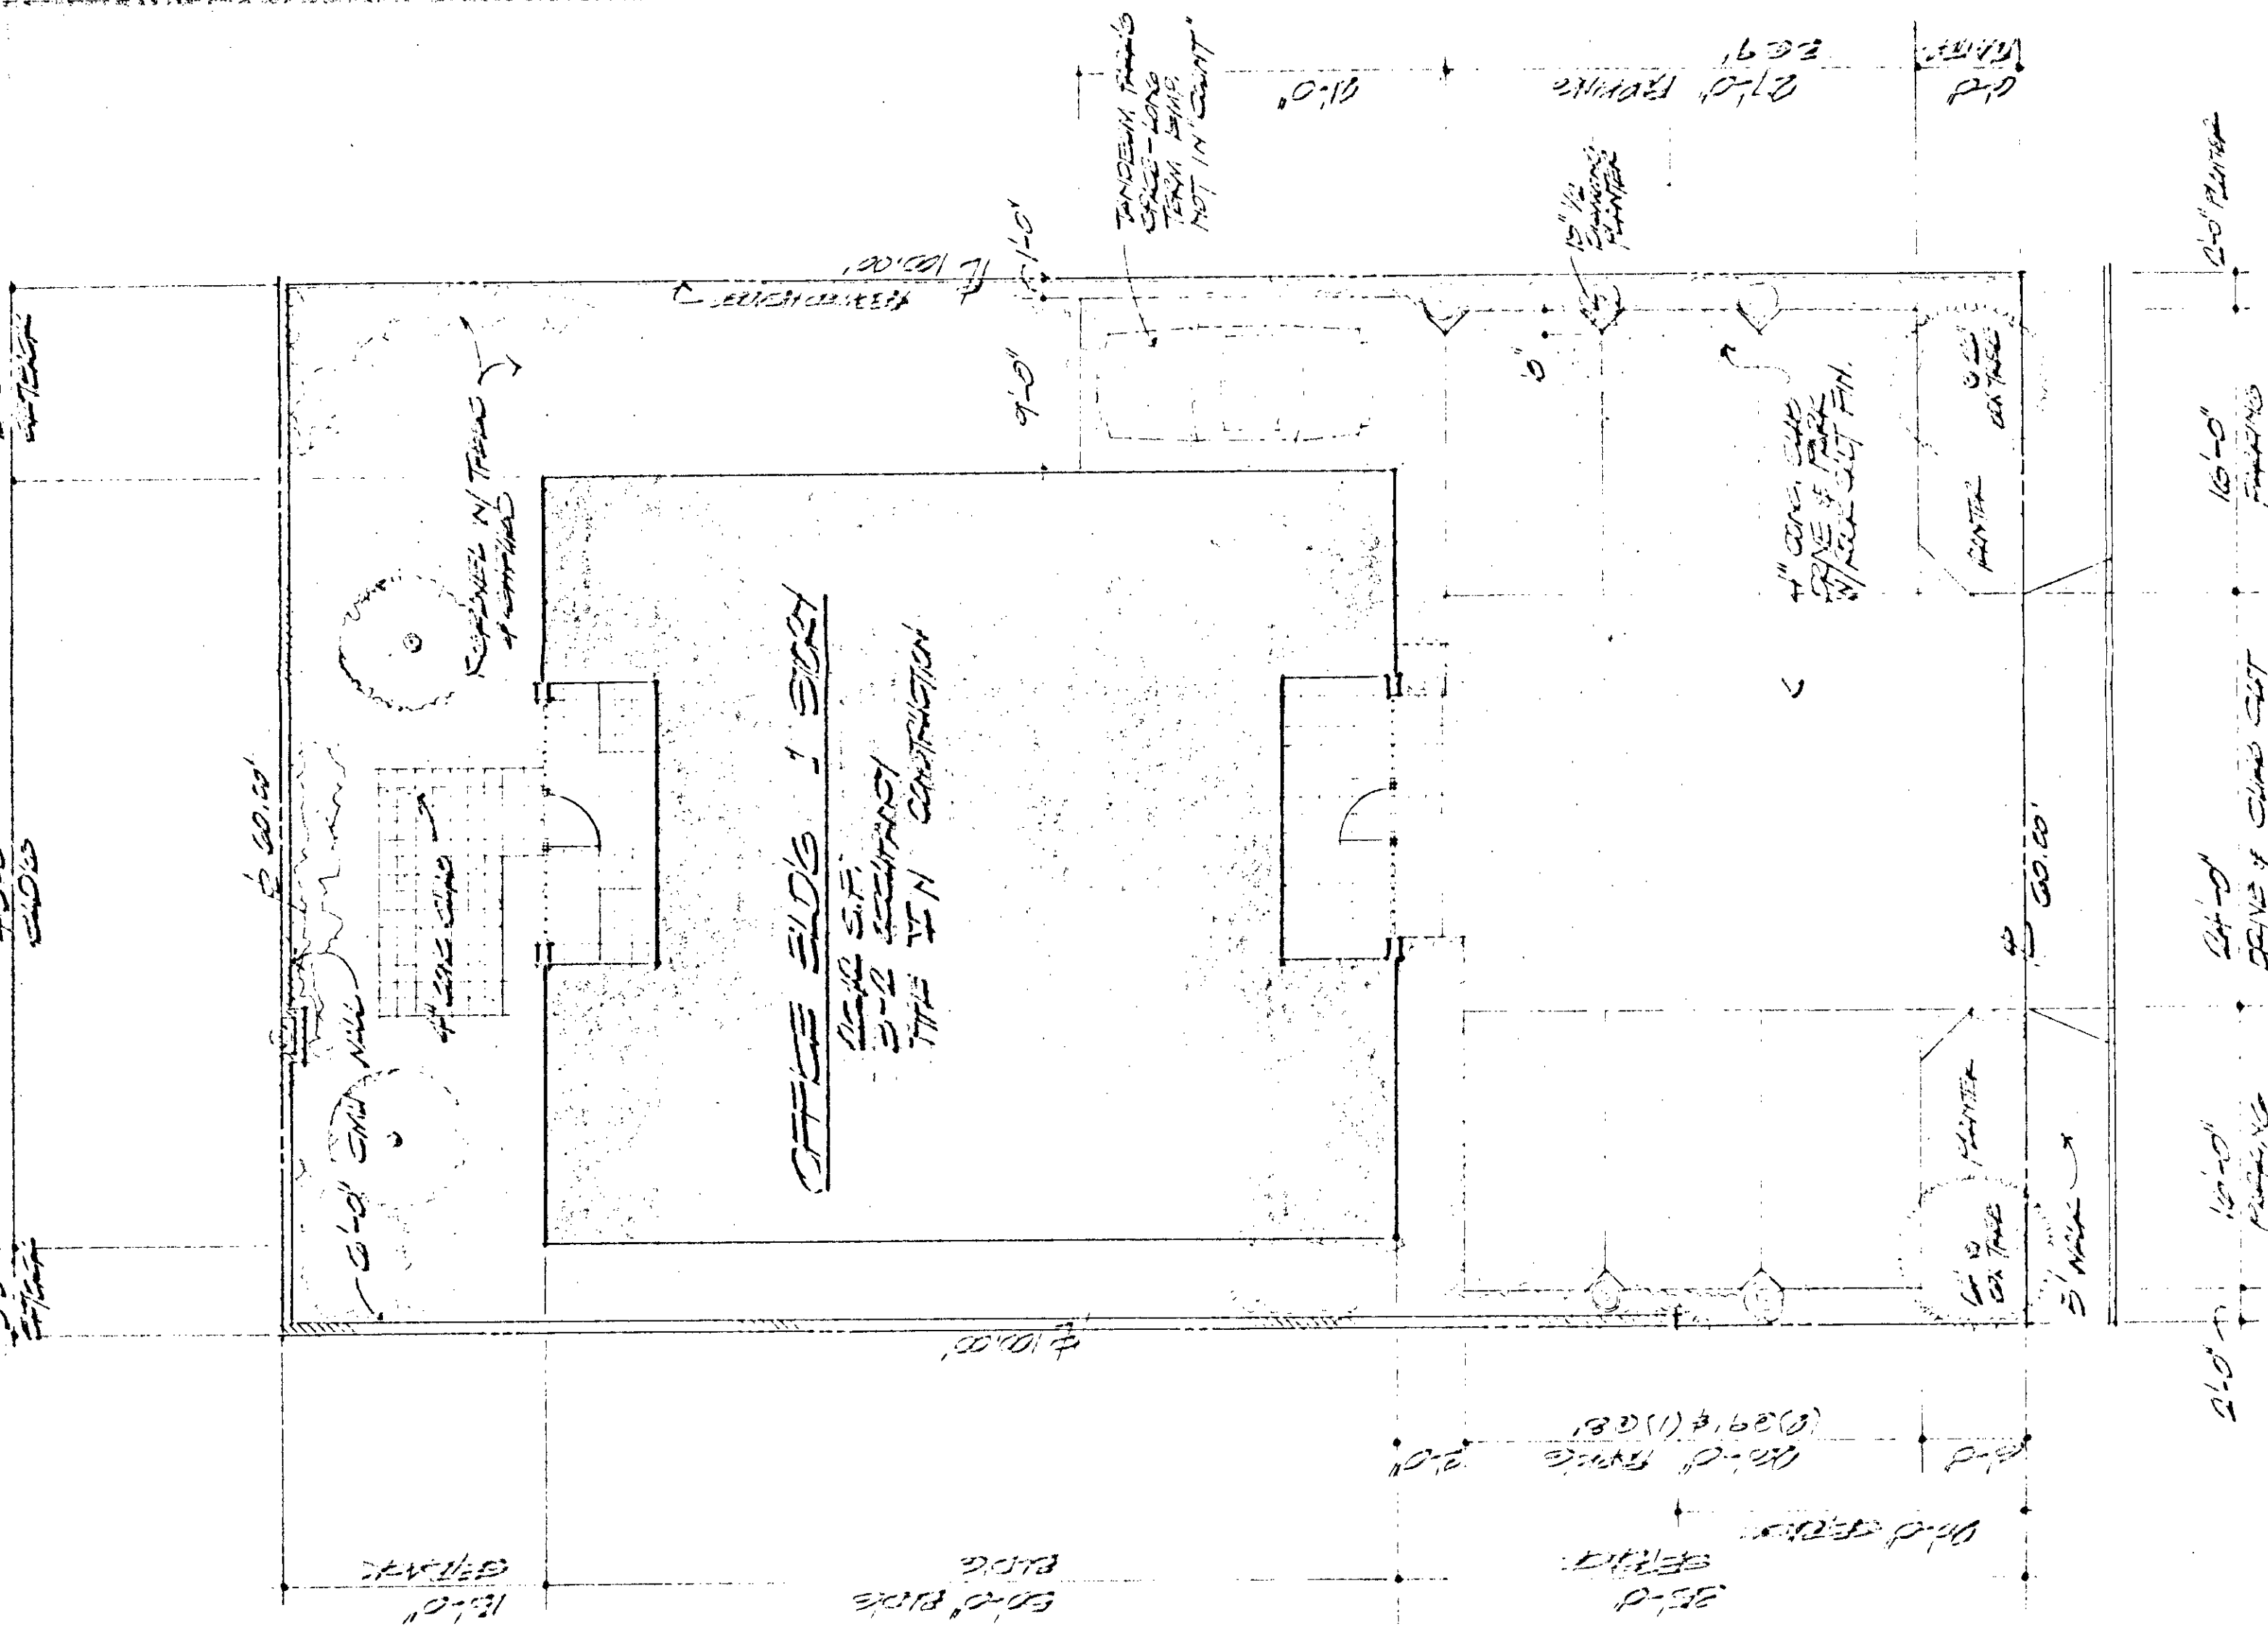


S. MARYLAND FRM

1/2\"/>

LOT 11, BLOCK 20, PUNTER'S EMBROIDERY
NO. 4, CLARK CO. NV, ZONE 2, PAGE 55,
CLARK CO. RECORDS

SITE PLAN 10\"/>

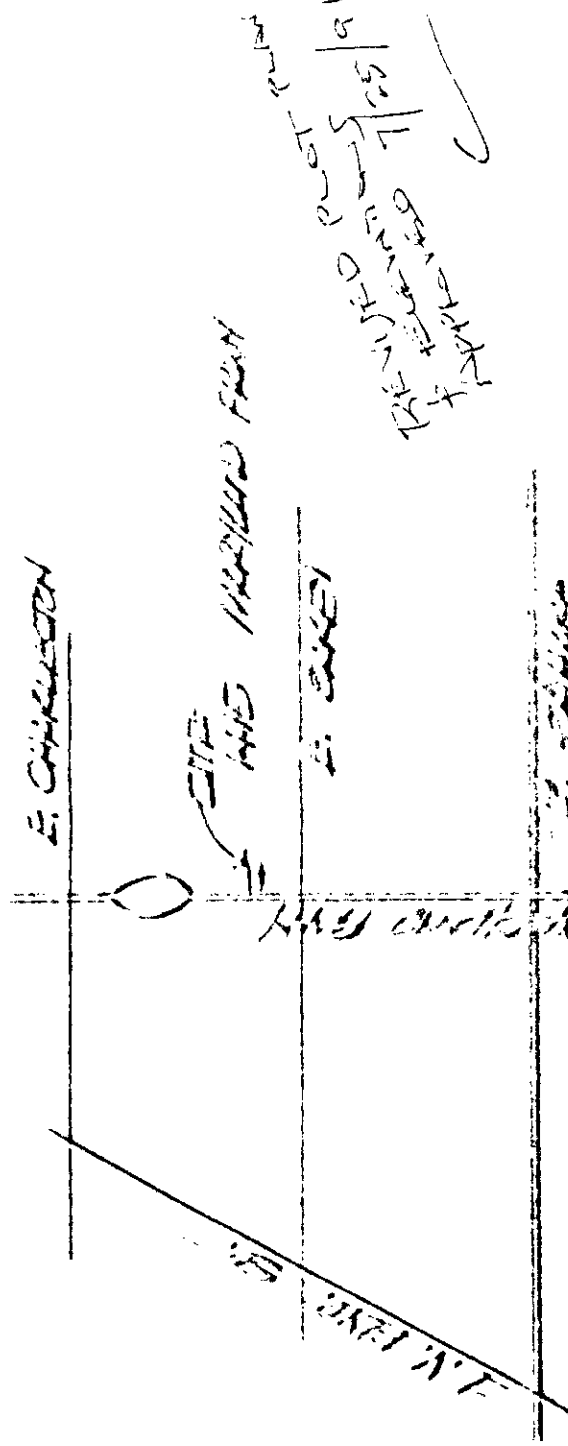

VICINITY MAP

