
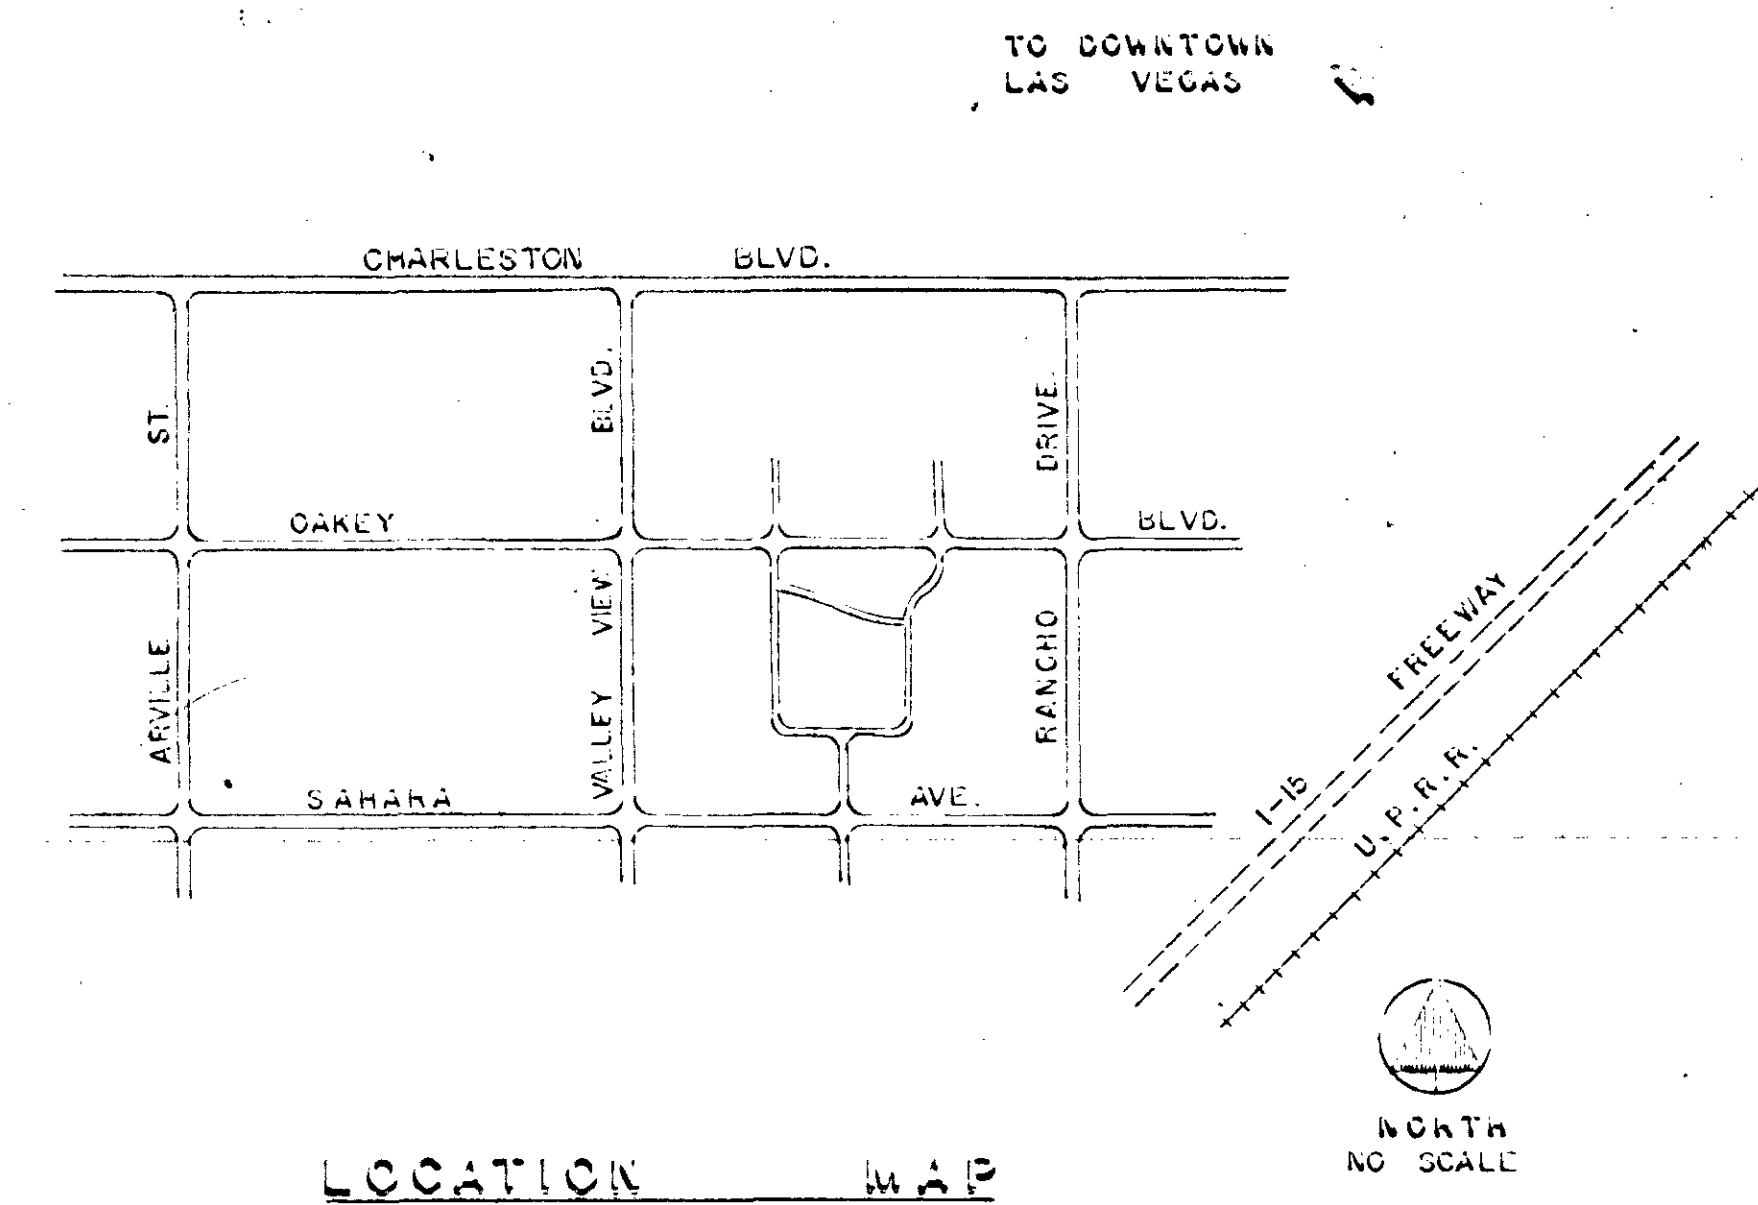


20' Alley

149

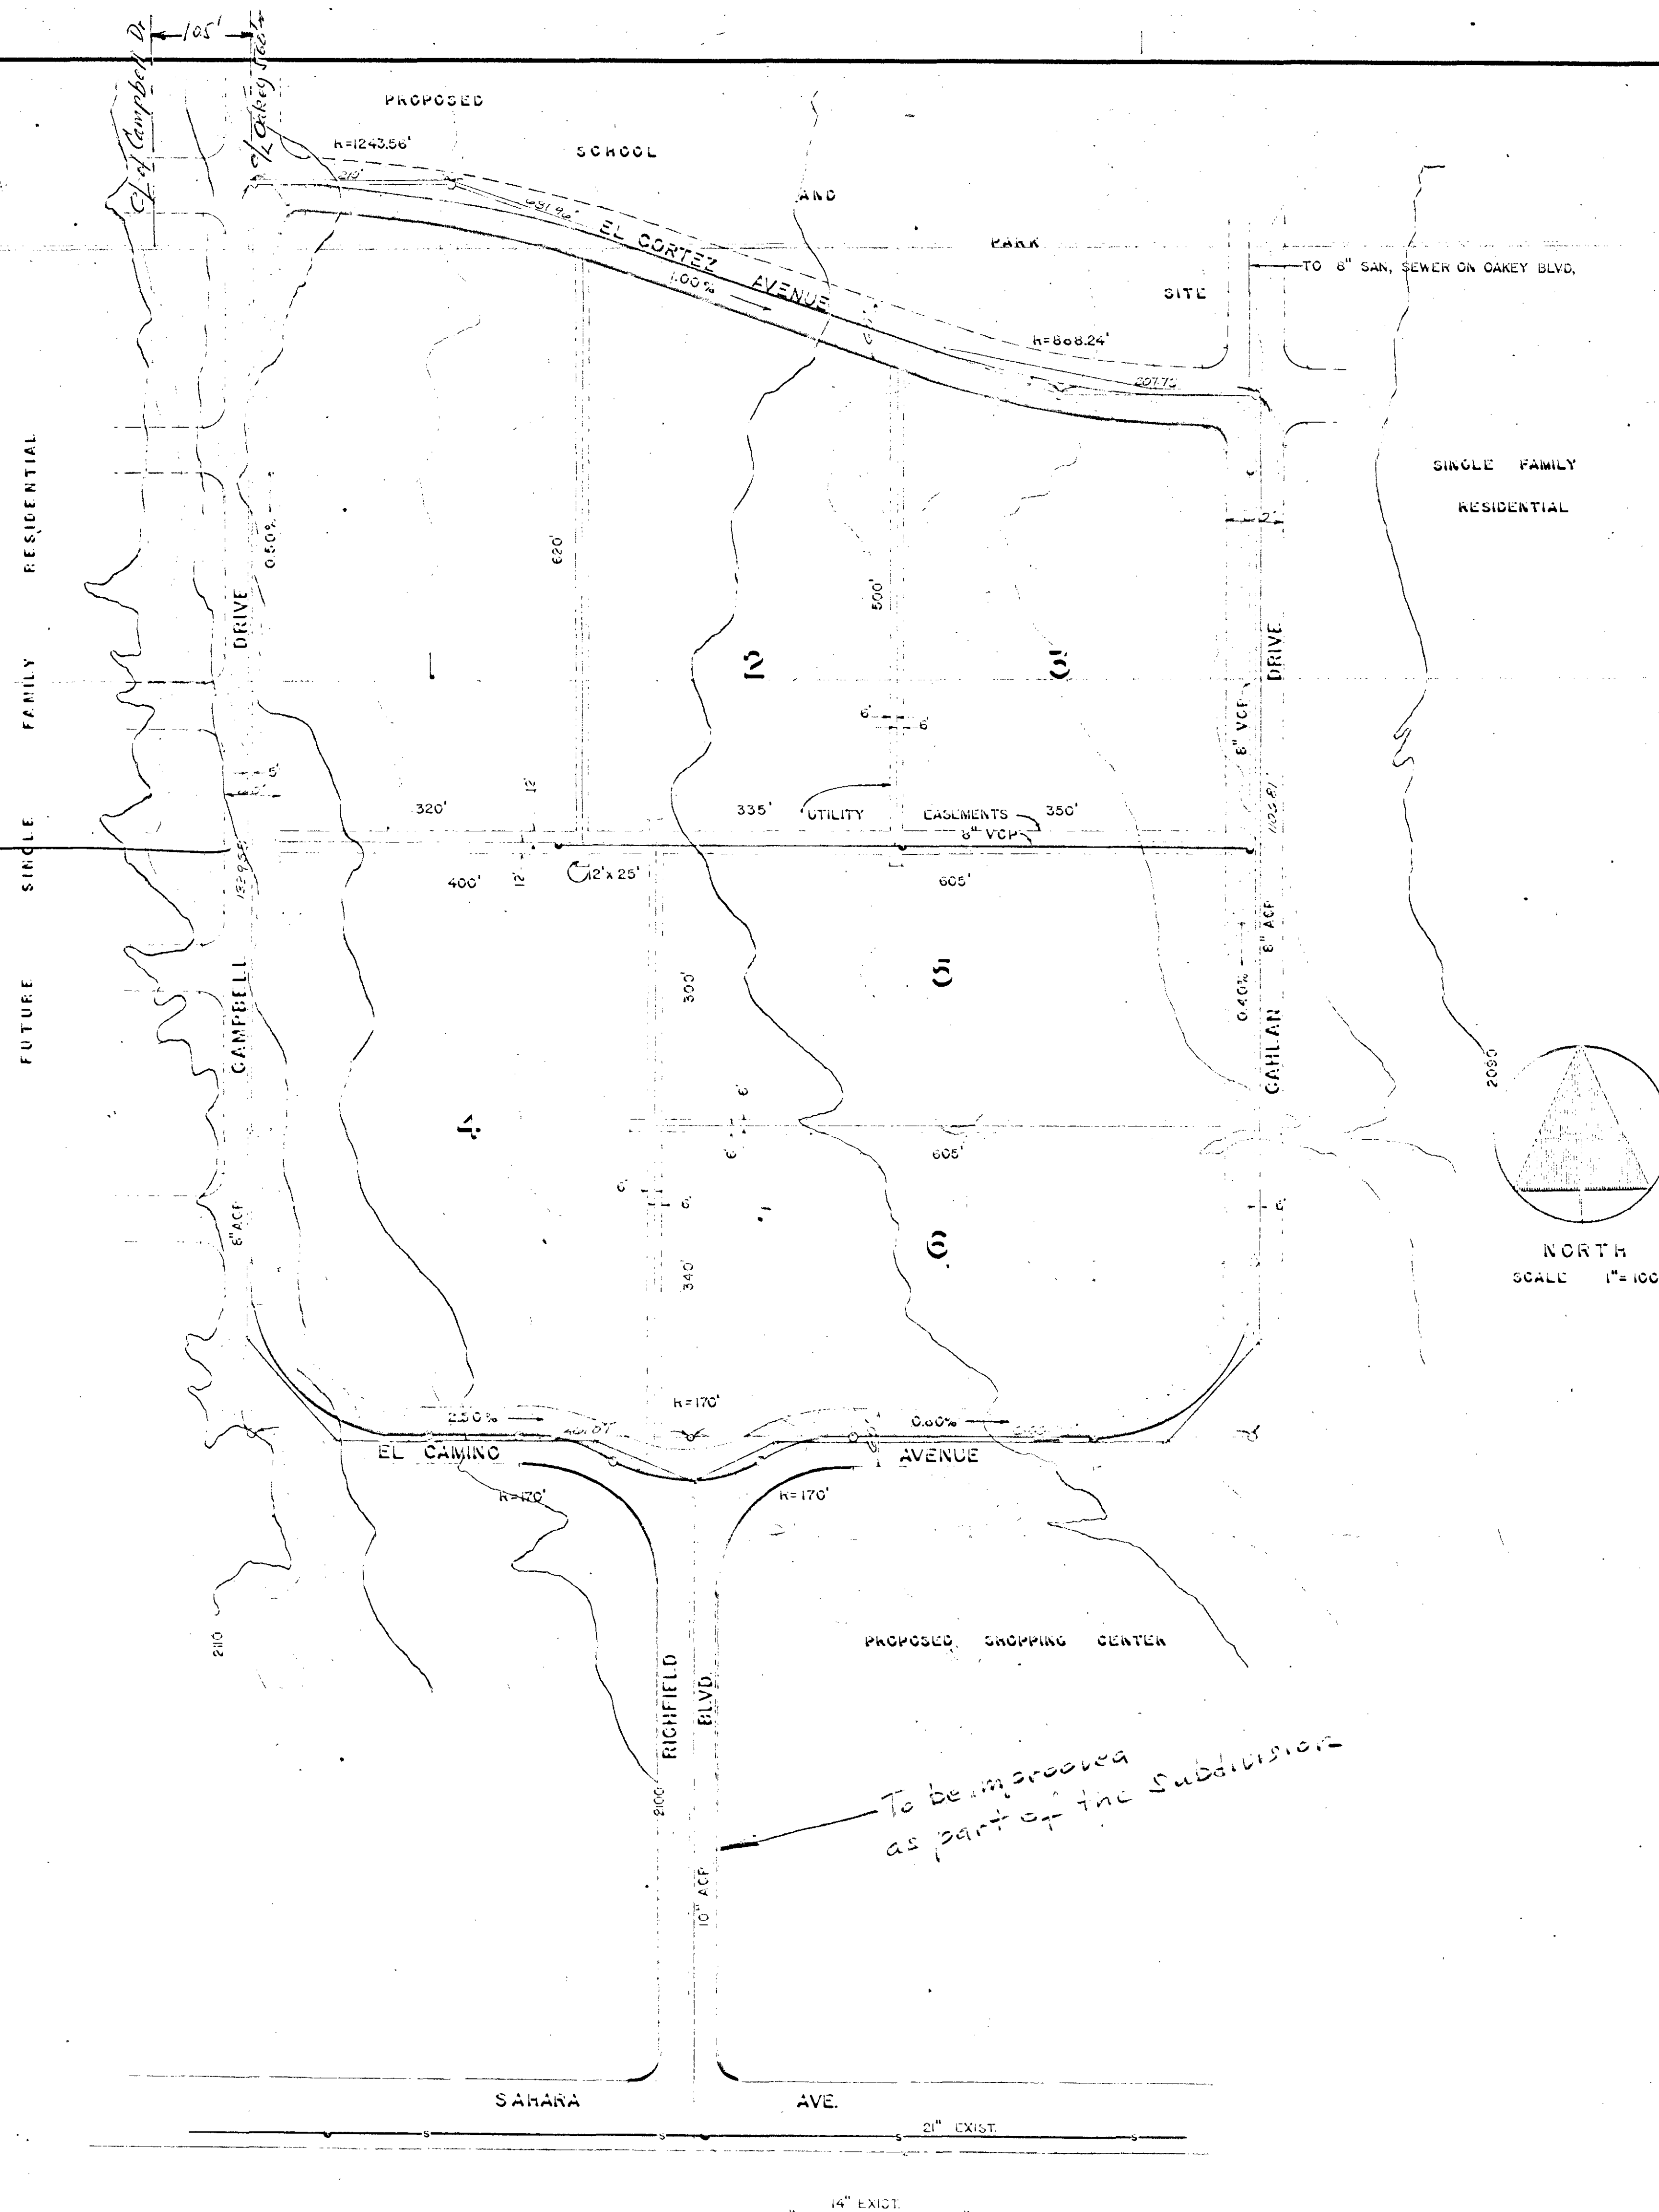

#### DATA:

|                               |                |
|-------------------------------|----------------|
| GROSS ACRES OF SITE           | 25.4           |
| TOTAL DWELLING UNITS          | 250            |
| DWELLING UNITS PER GROSS ACRE | 9.8            |
| ACRES OF RECREATION AREA      | 3.0            |
| NUMBER OF PARKING SPACES:     |                |
| COVERED                       | 500            |
| UNCOVERED                     | 70             |
| TOTAL                         | 570            |
| PARKING RATIO                 | 2.3:1          |
| ESTIMATED SEWAGE FLOW AVE.    | 153,000 G.P.D. |
| ESTIMATED SEWAGE FLOW PEAK    | 214,000 G.P.D. |


FILED  
JUL 2 1963

SUBMITTED BY Robert E. Taylor R.E. 1314  
MOORE, KEMPA & GALLOWAY INC.  
878-7448



Frontyard Lot  
Side " 6' or 5' 1/2"  
Rear " 20'  
R3 = 7,750 Sq Ft per Unit

|                                                                                               |          |      |      |
|-----------------------------------------------------------------------------------------------|----------|------|------|
| WESTWOOD VILLAGE NO. 3                                                                        |          |      |      |
| PORTION OF S 1/2 OF SEC. 5, T21S, R12E, N.D.E. & M., CITY OF LAS VEGAS, CLARK COUNTY, NEVADA. |          |      |      |
| PREPARED FOR FIRST WESTERN SAVINGS 1221 E. CHARLESTON LAS VEGAS, NEV                          |          |      |      |
| TENTATIVE                                                                                     | MAP      |      |      |
| DATE                                                                                          | DES.     | CHK. | APP. |
| REVISION                                                                                      | NO. DATE | BY   | DATE |
| 1                                                                                             | 2430     |      |      |
| OP                                                                                            | 1        |      |      |

## 2121 PLAZA DE LA CANDELA

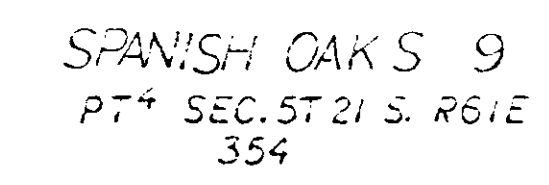


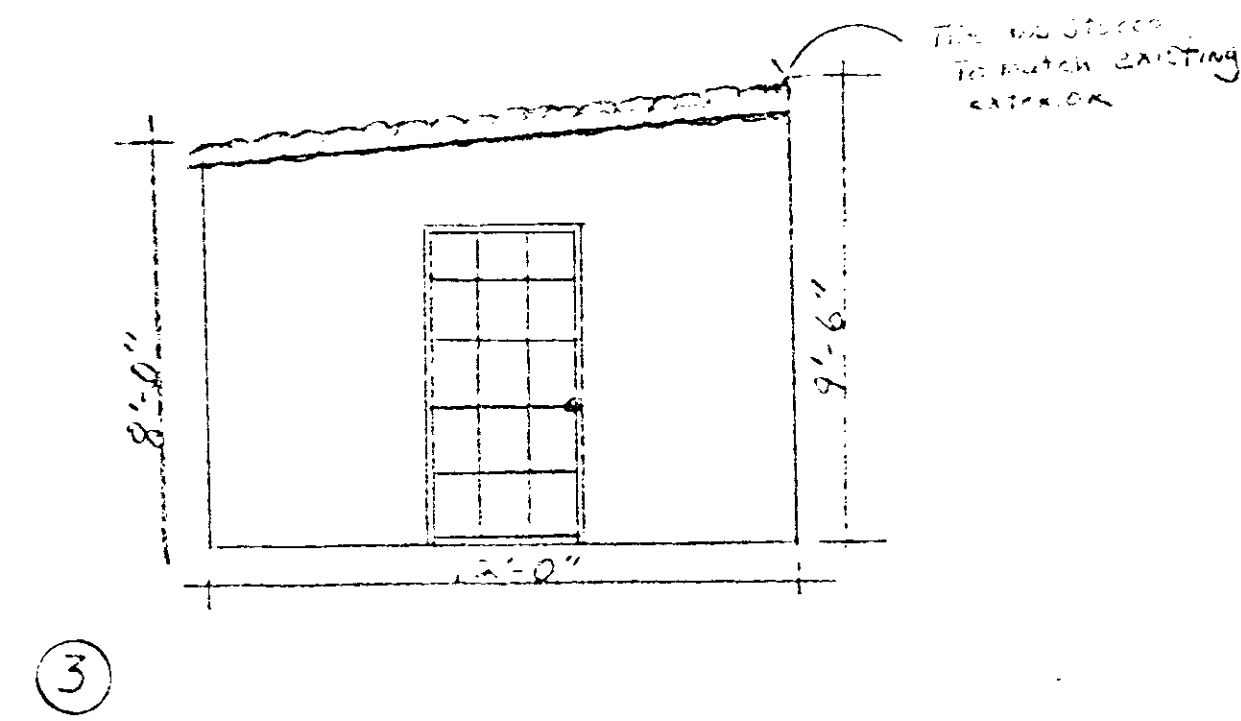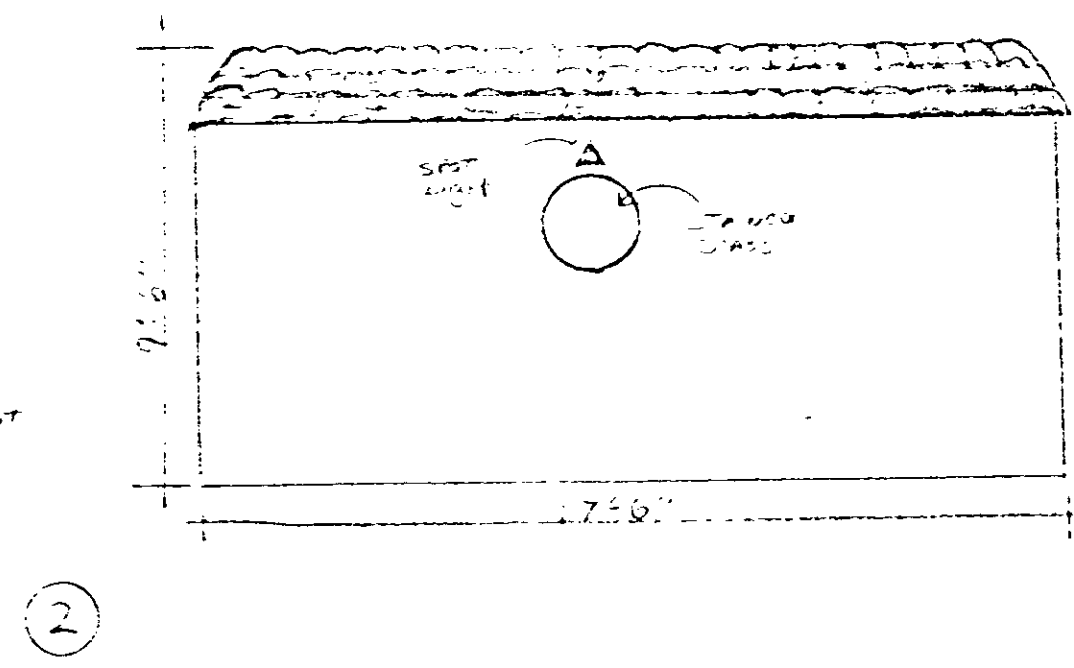


 RESIDENCE  
 LOT LINE  
 BLOCK WALL  
 $\frac{1}{4}'' = 1'-0''$

SARA CUTTER STONESTREET  
2121 PLAZA DE LA CANDELA  
LAS VEGAS, NEVADA

SOUTHWEST INTERIORS  
1-19-86  
Victoria S Whitekey

