


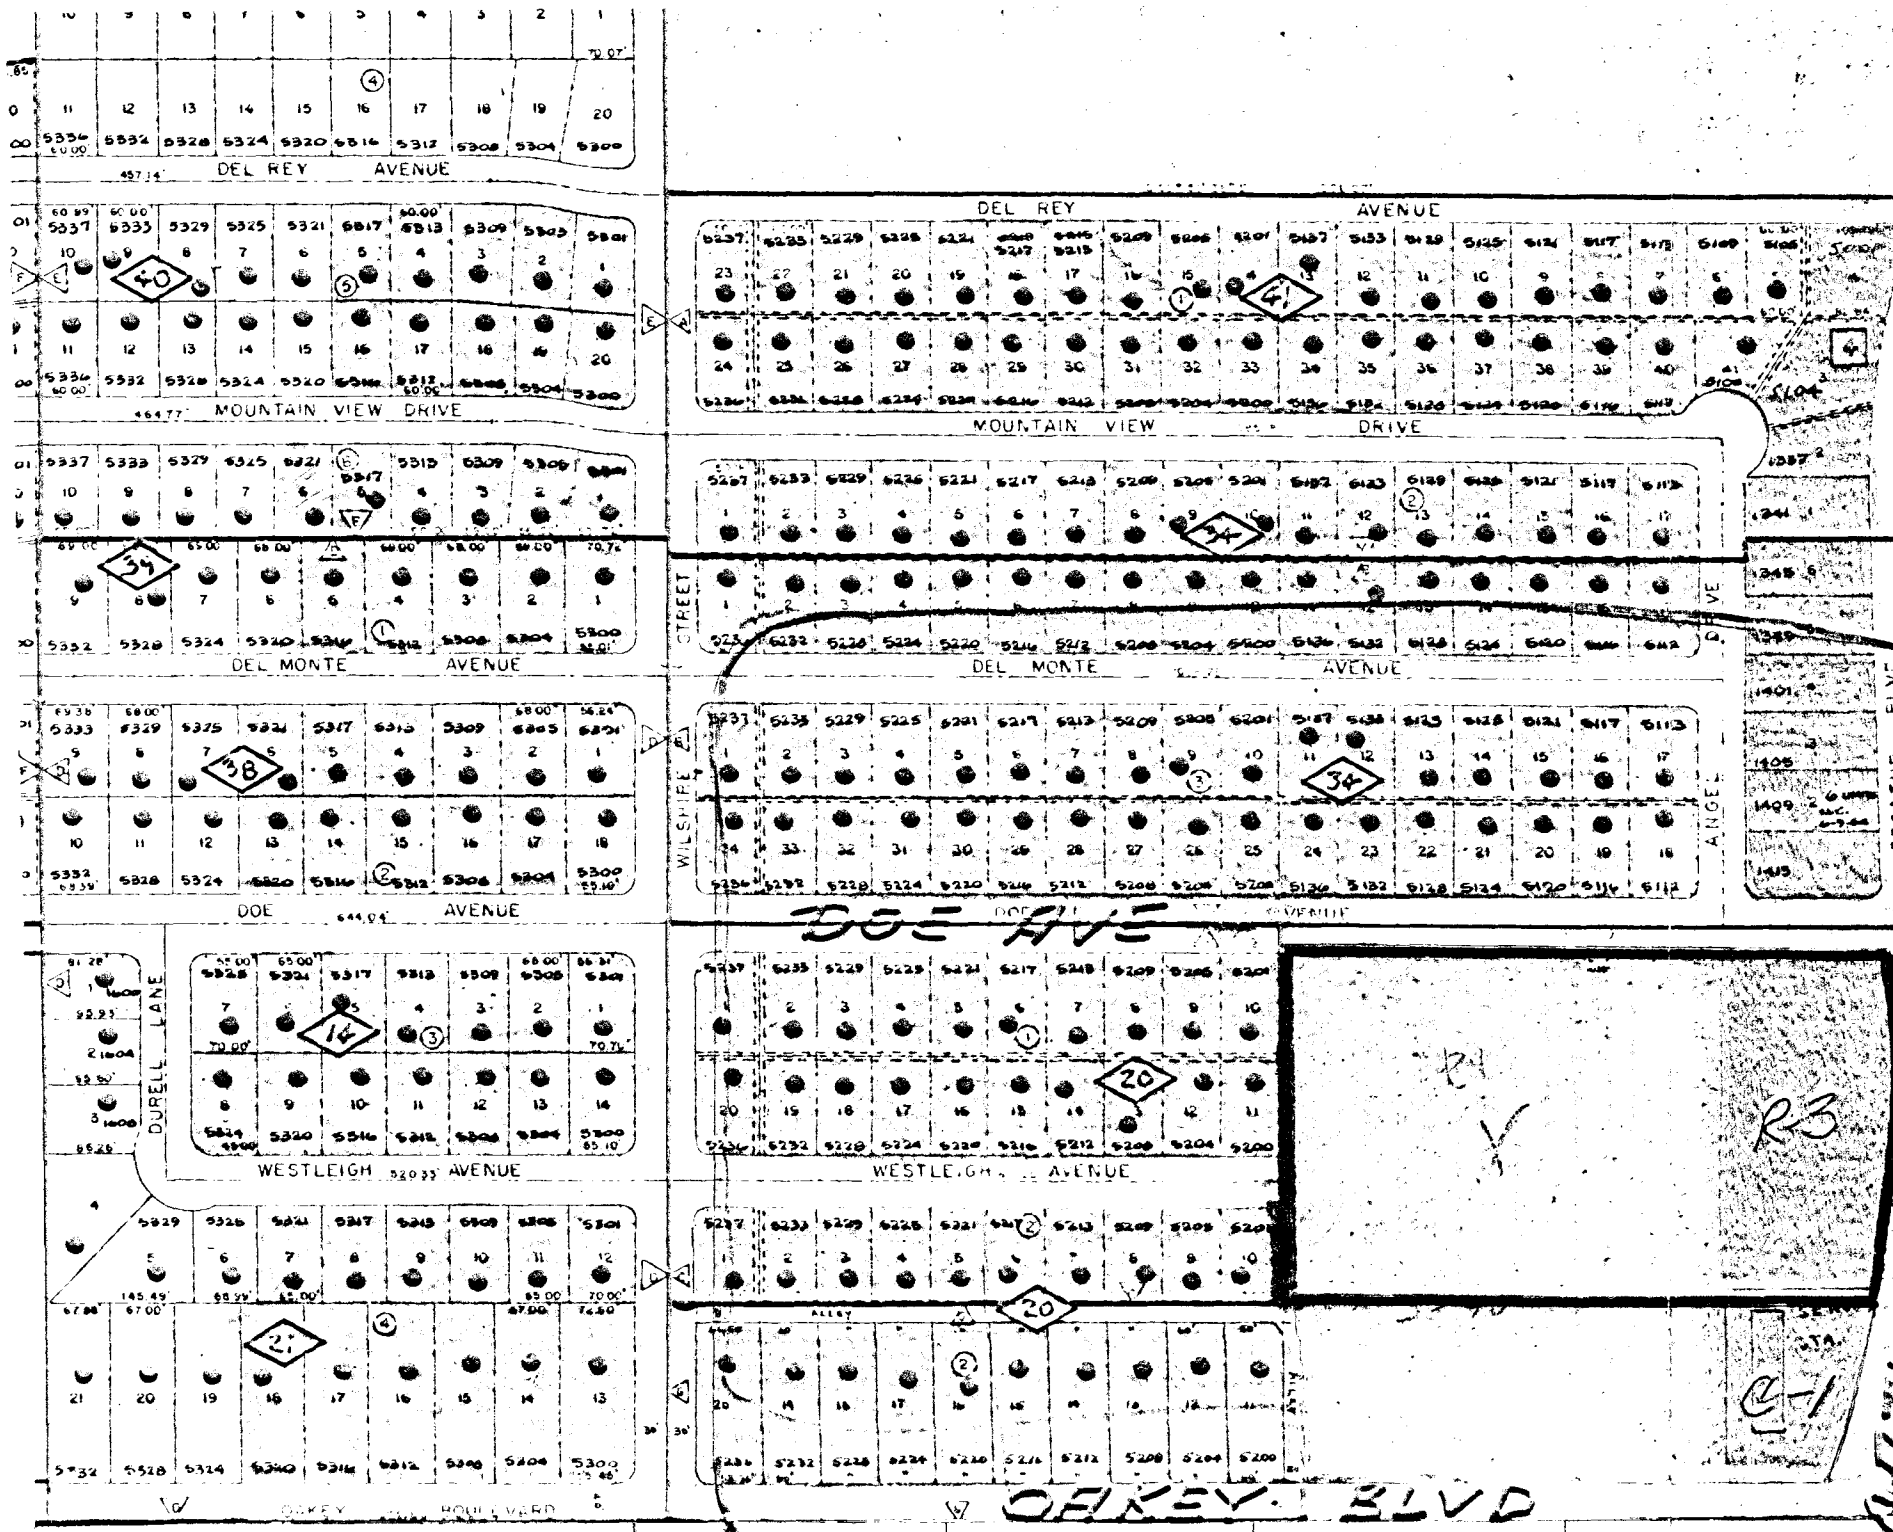

DE CHUR BLVD

OAKLEY BLVD


COUNTY

Z-149-77

149



11102512

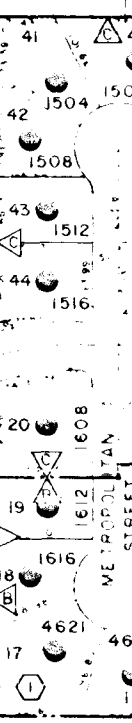

See Revised
Plot No.

Base Design.

West-Lewis
Ave.

Access

PLOT PLAN
Scale: 1/4" = 30' 0"



2005 AVENUE

Provide Landscaping

r.v. stall

h.w./service

oil/w.

service

Move Sidewalk

10' 0" sewer easement

service

wipe up

parts dept.

office

showroom

covered display

service

landscape (imp.)


DECATUR BLVD.

SERVICE


LAS VEGAS, NEVADA
PROJ. No. 7550 PLAN No. 1
29th July 1977 a.w.32

149

SHEET 1 of 3

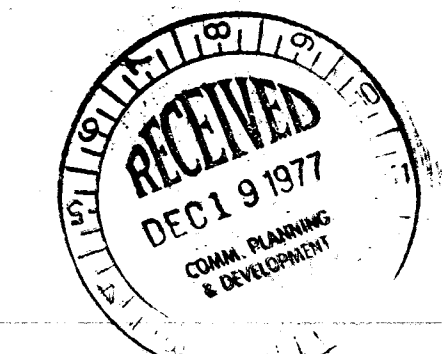


STAFF
2-149-77

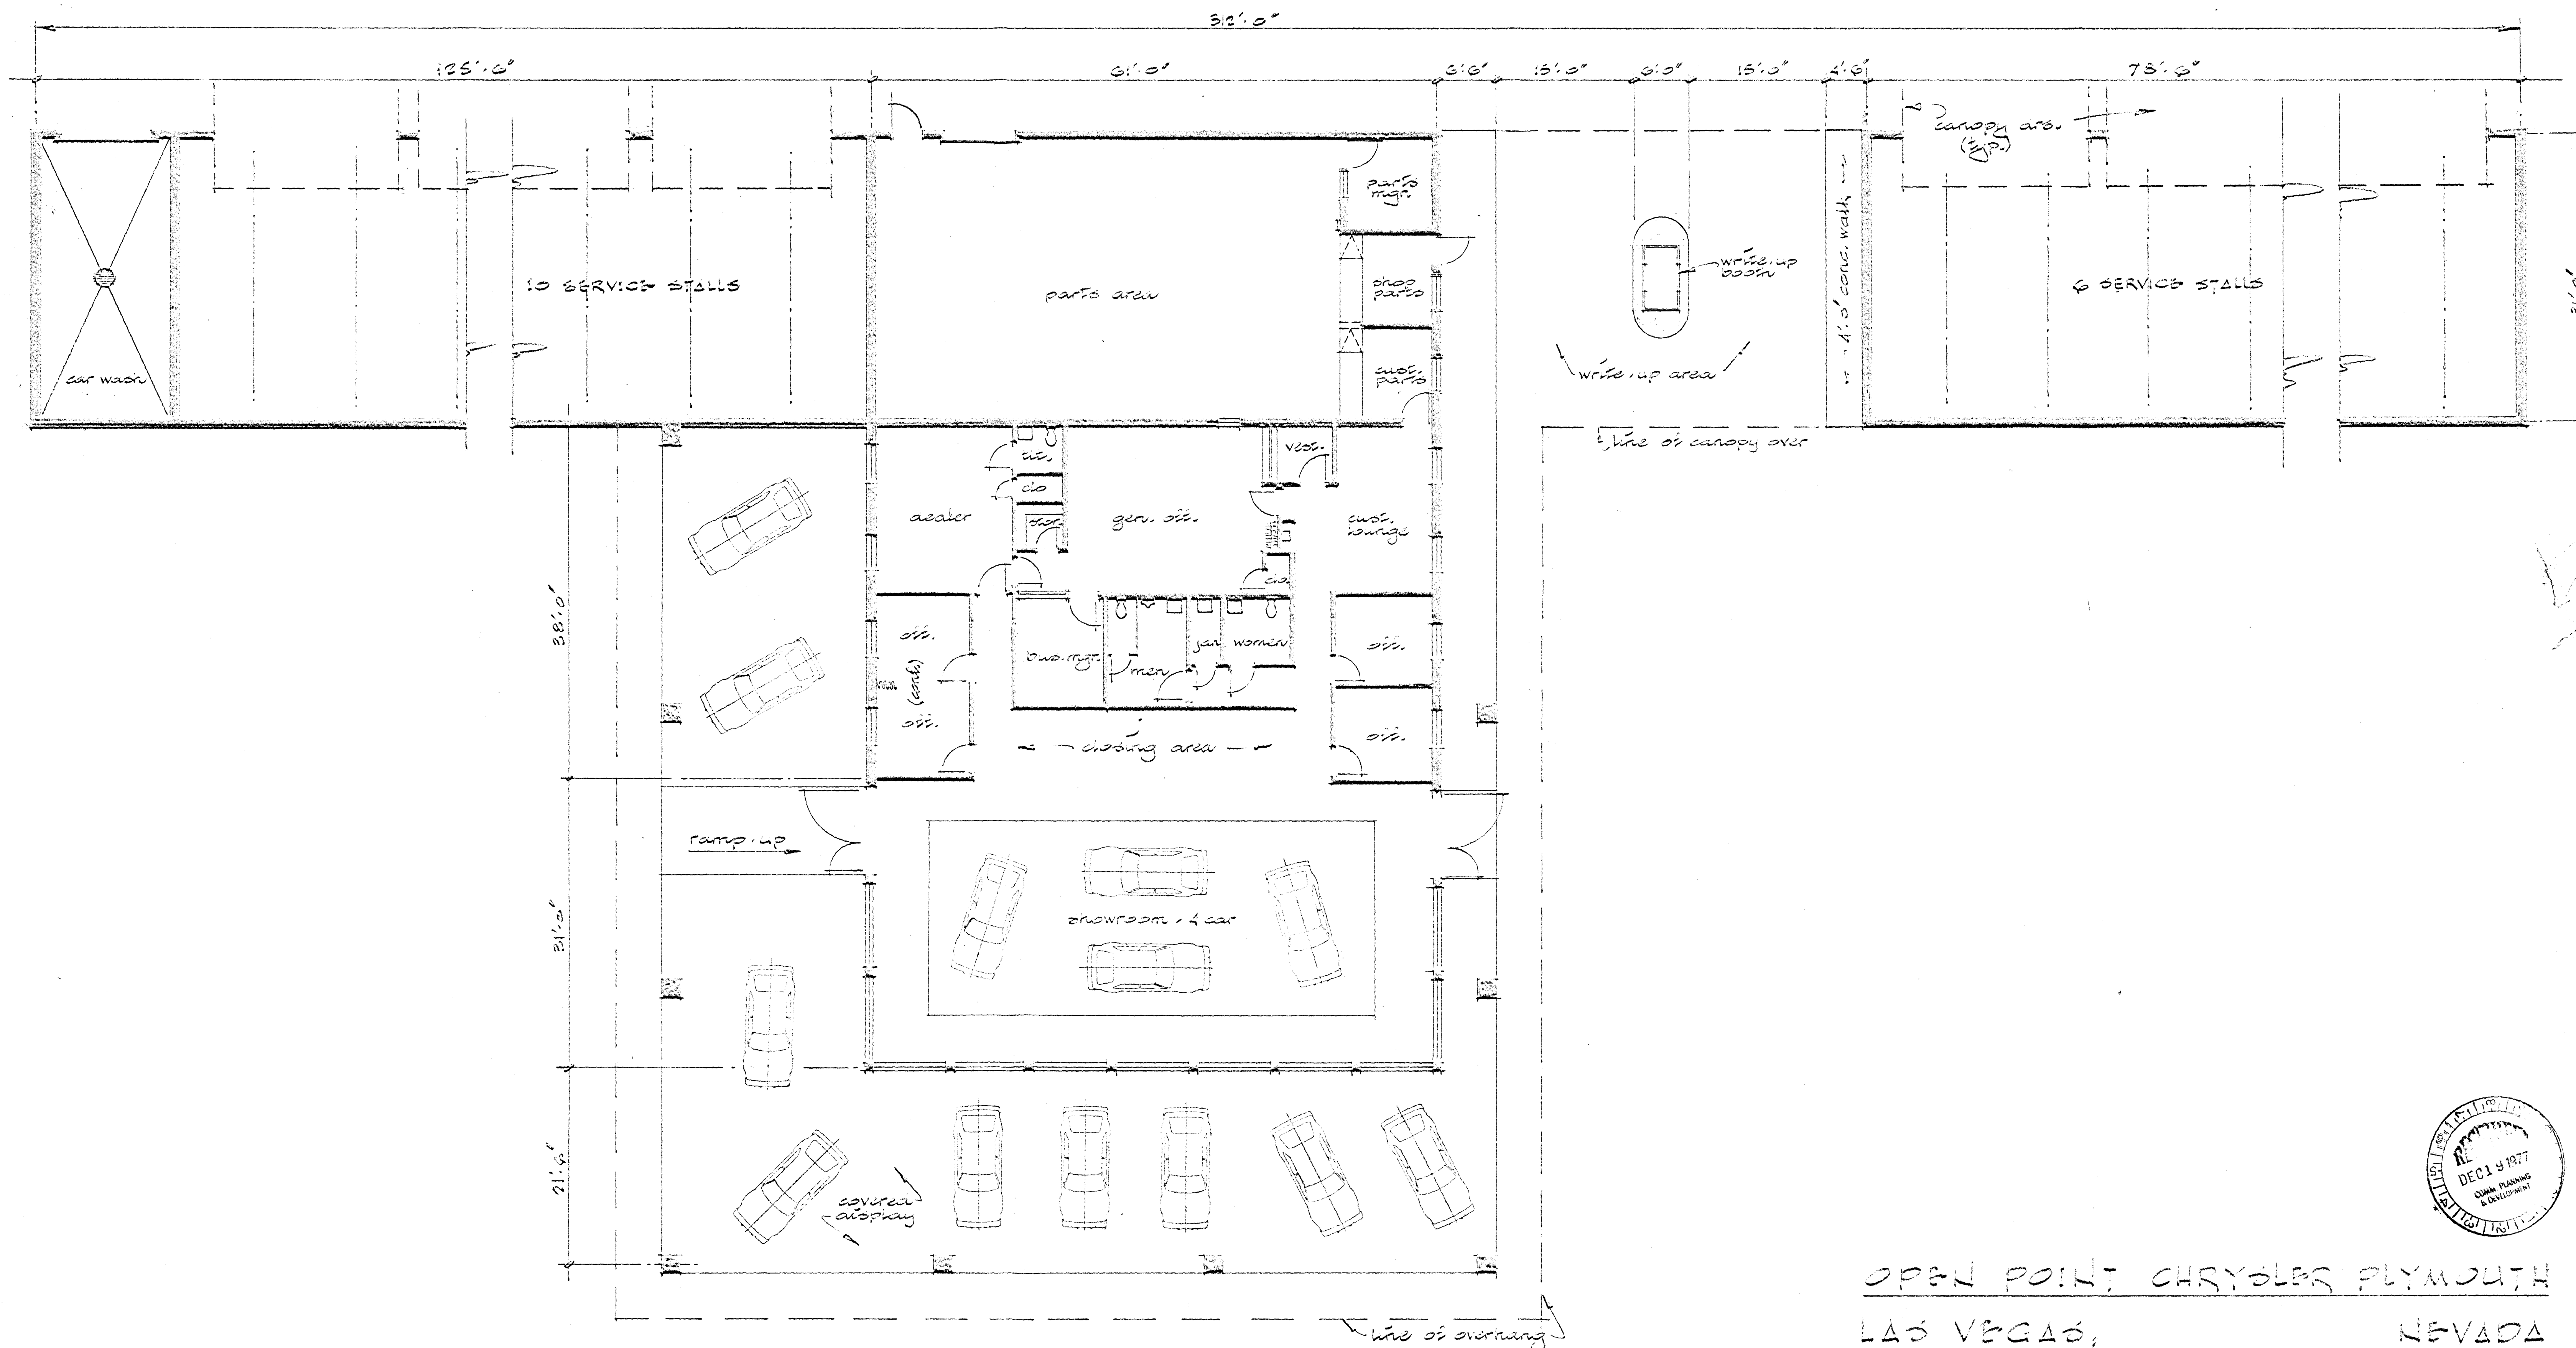

149


FLOOR PLAN
scale: 1/8" = 1'-0"

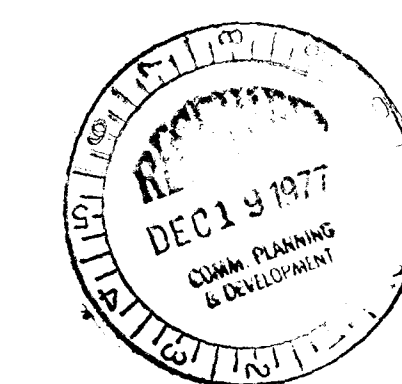

OPEN POINT CHRYSLER PLYMOUTH
LAS VEGAS, NEVADA

PROJ. No. 7550 PLAN No. 1
29th July 1977 d.w.ise


SHEET 2 of 3

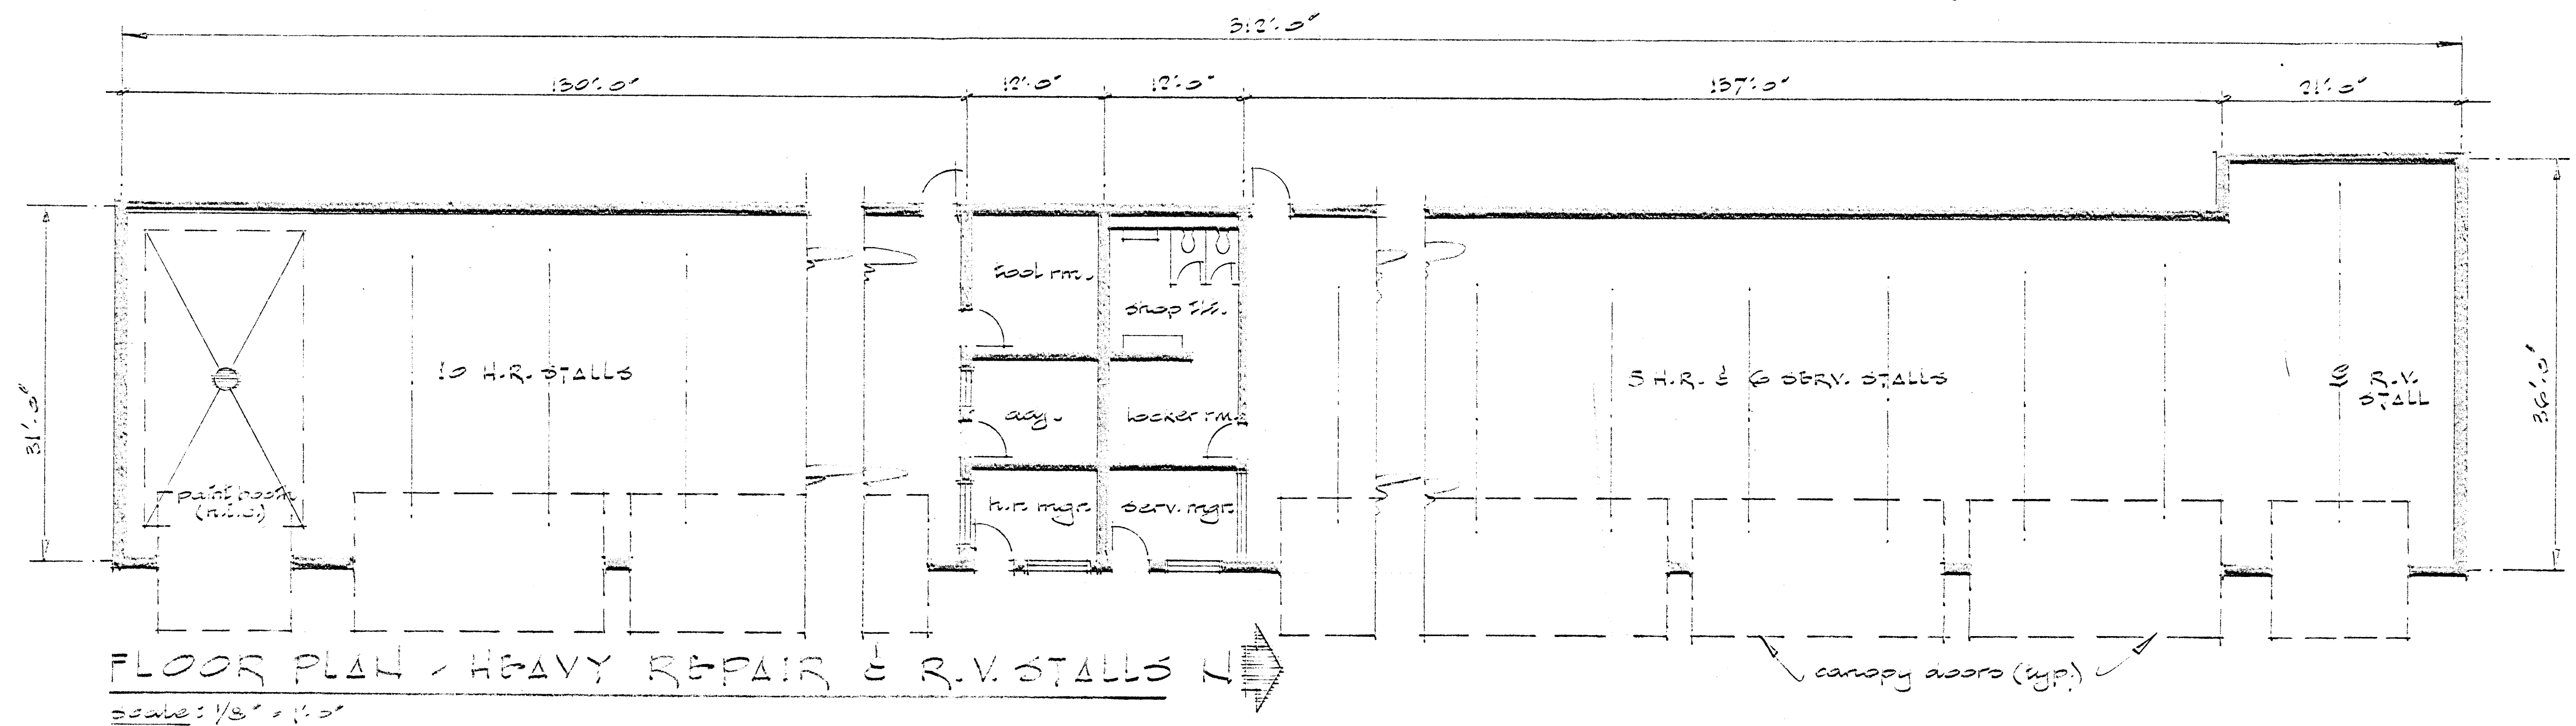


OPEN POINT CHRYSLER PLYMOUTH
 LAS VEGAS, NEVADA
 PROJ. No. 7550 PLAN No. 1
 23rd July 1977 a.wise

149

SHEET 3 of 3

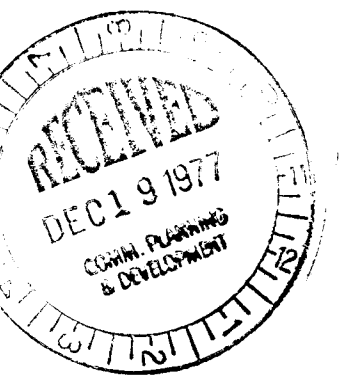

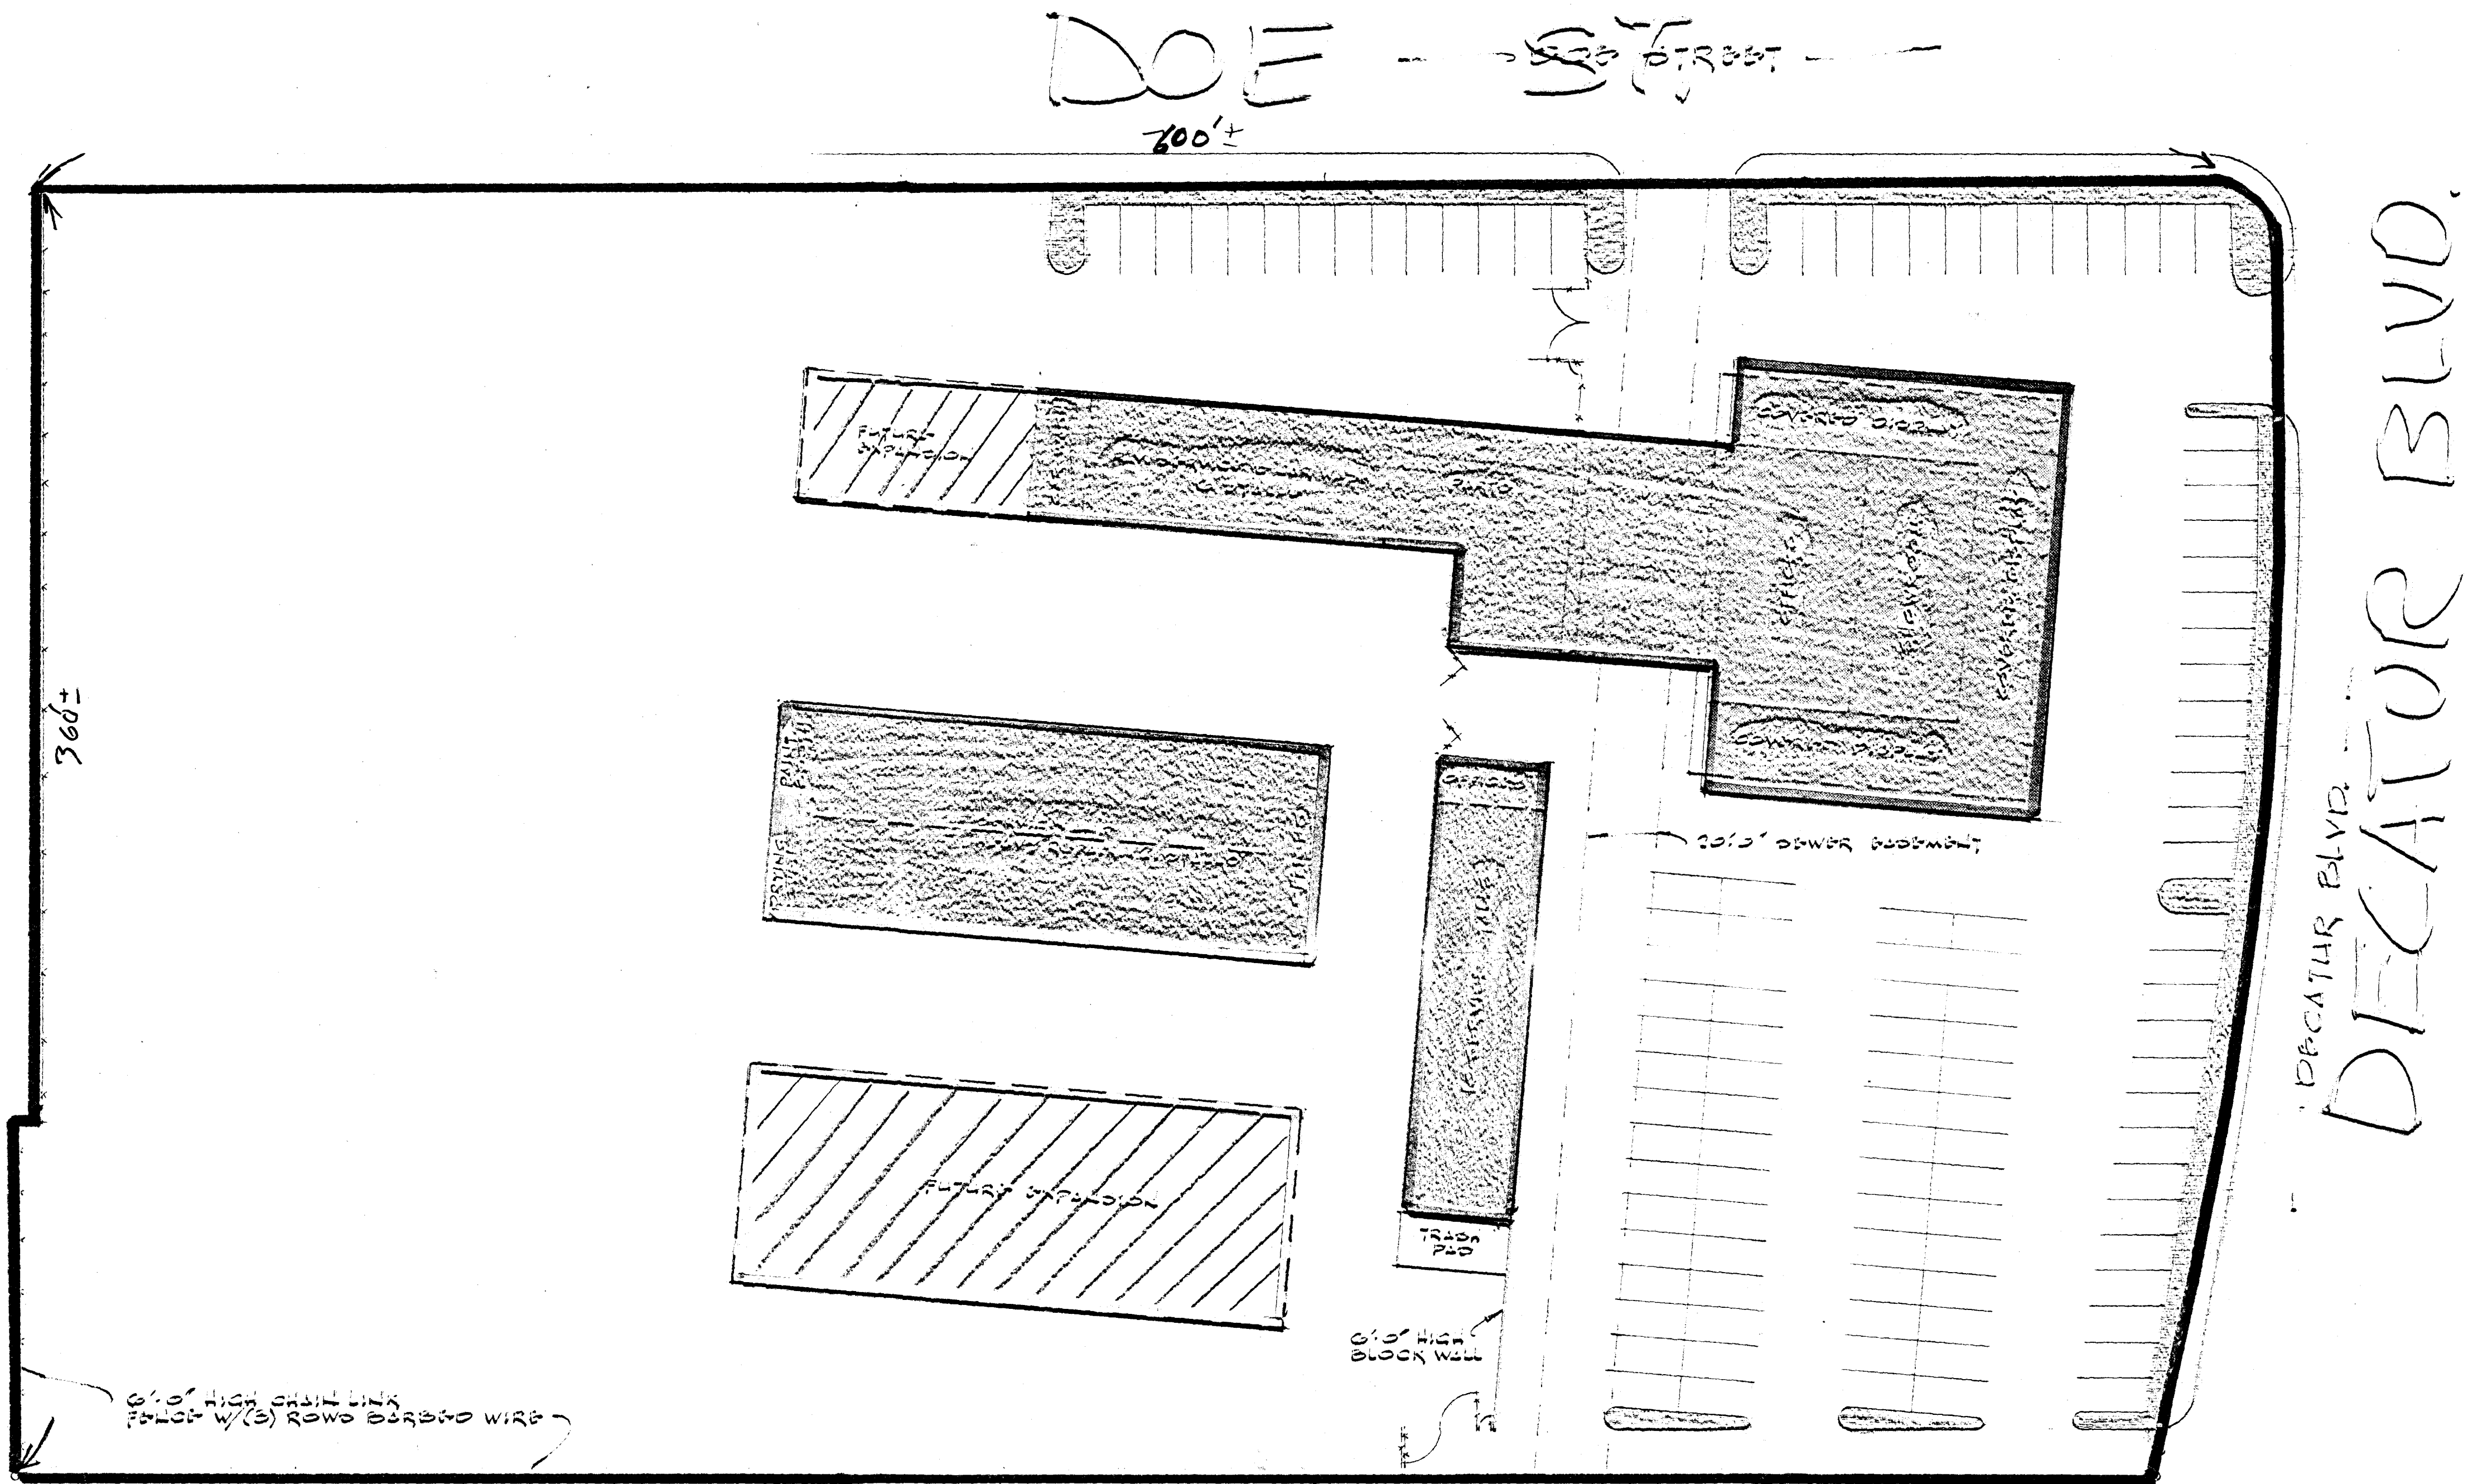

SITE PLAN
SCALE: 1" = 30' 0"




NOTE = ENTIRE SITE TO BE ASPHALT PAVED

PLAN

PLANNING PC
STALLS REQ'D
STALLS PROV!

149
Pellado
cc 2/2/78

Z-149-77

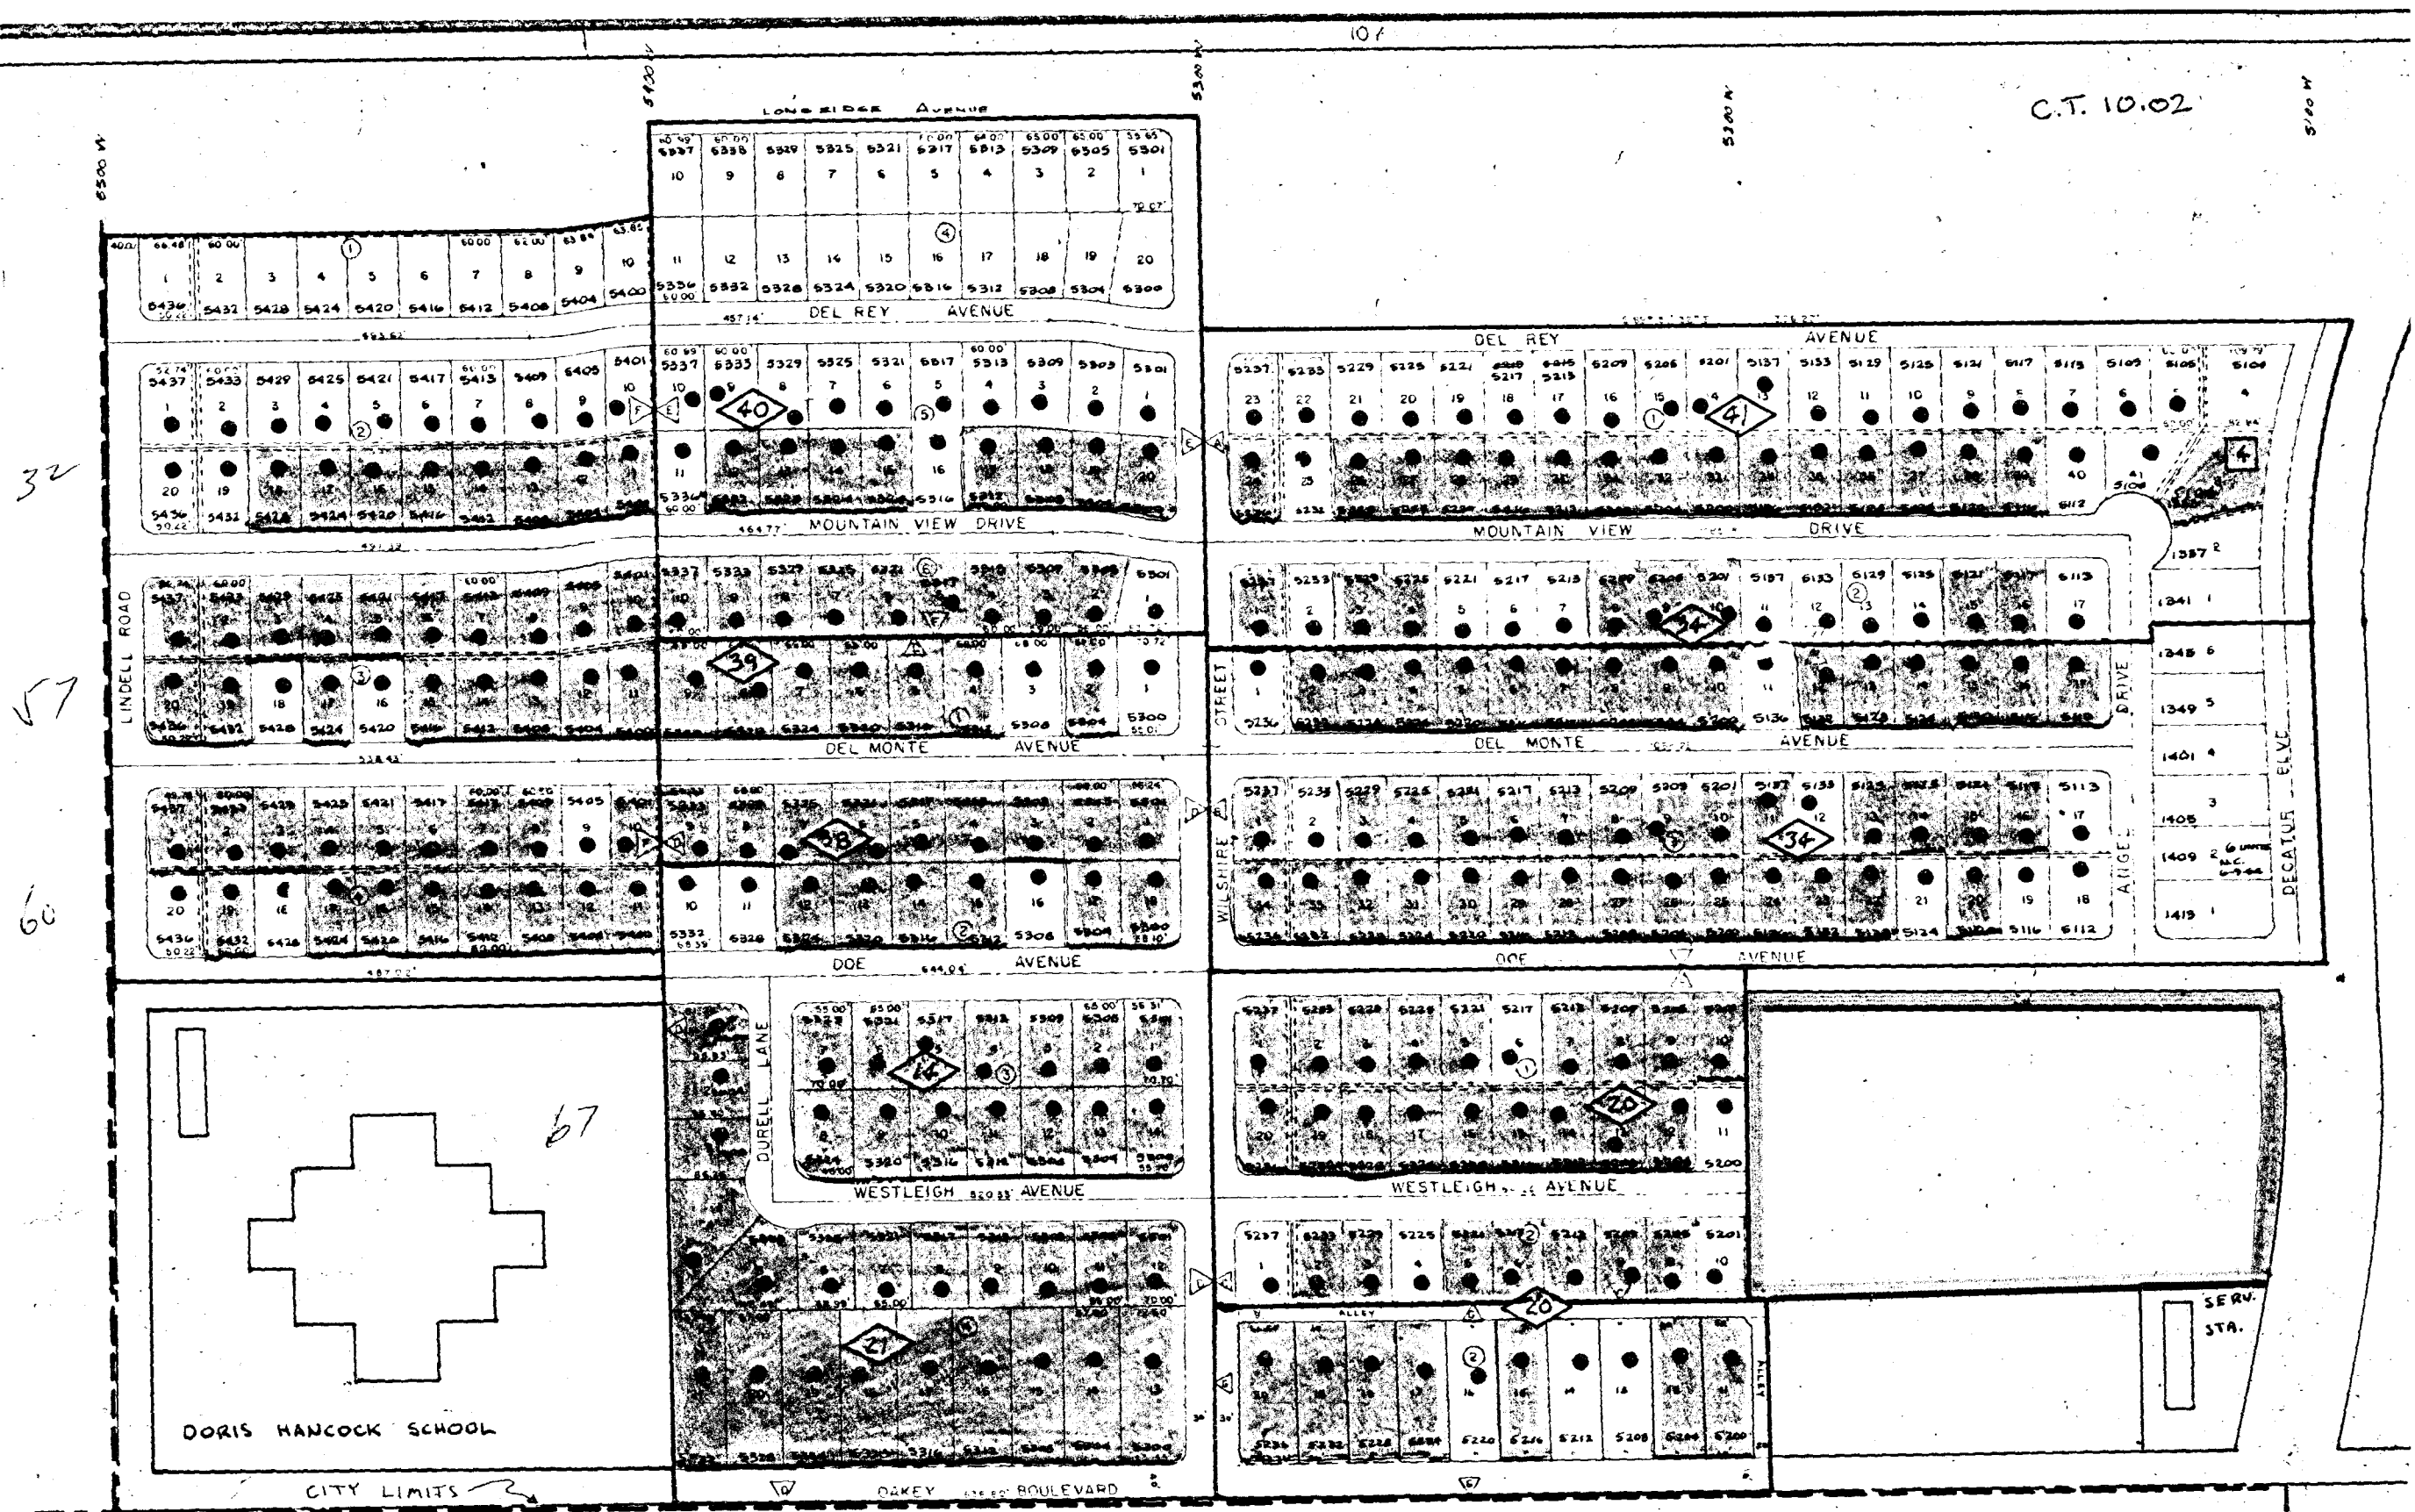

C.T. 10.02

32

57

60

67

DORIS HANCOCK SCHOOL

CITY LIMITS

149

- CHARLESTON HEIGHTS 32-A-1
- CHARLESTON HEIGHTS 32-A-2
- CHARLESTON HILLS 35-A
- CHARLESTON HILLS NO. 4
- CHARLESTON HILLS NO. 2
- CHARLESTON HEIGHTS 36
- CHARLESTON HEIGHTS 35-B

REVISED OCT. 73 JG

216 prelatat map

S 1/2 NE 1/4	
CITY OF LAS VEGAS	
ENGINEER	
DISTRICT MAP	
DESIGNED BY	WARRER
APPROVED BY	CITY ENGINEER

149