

85

AVENUE

CITY

28


37

60

CHARLESTON

BLVD.

CHURCH

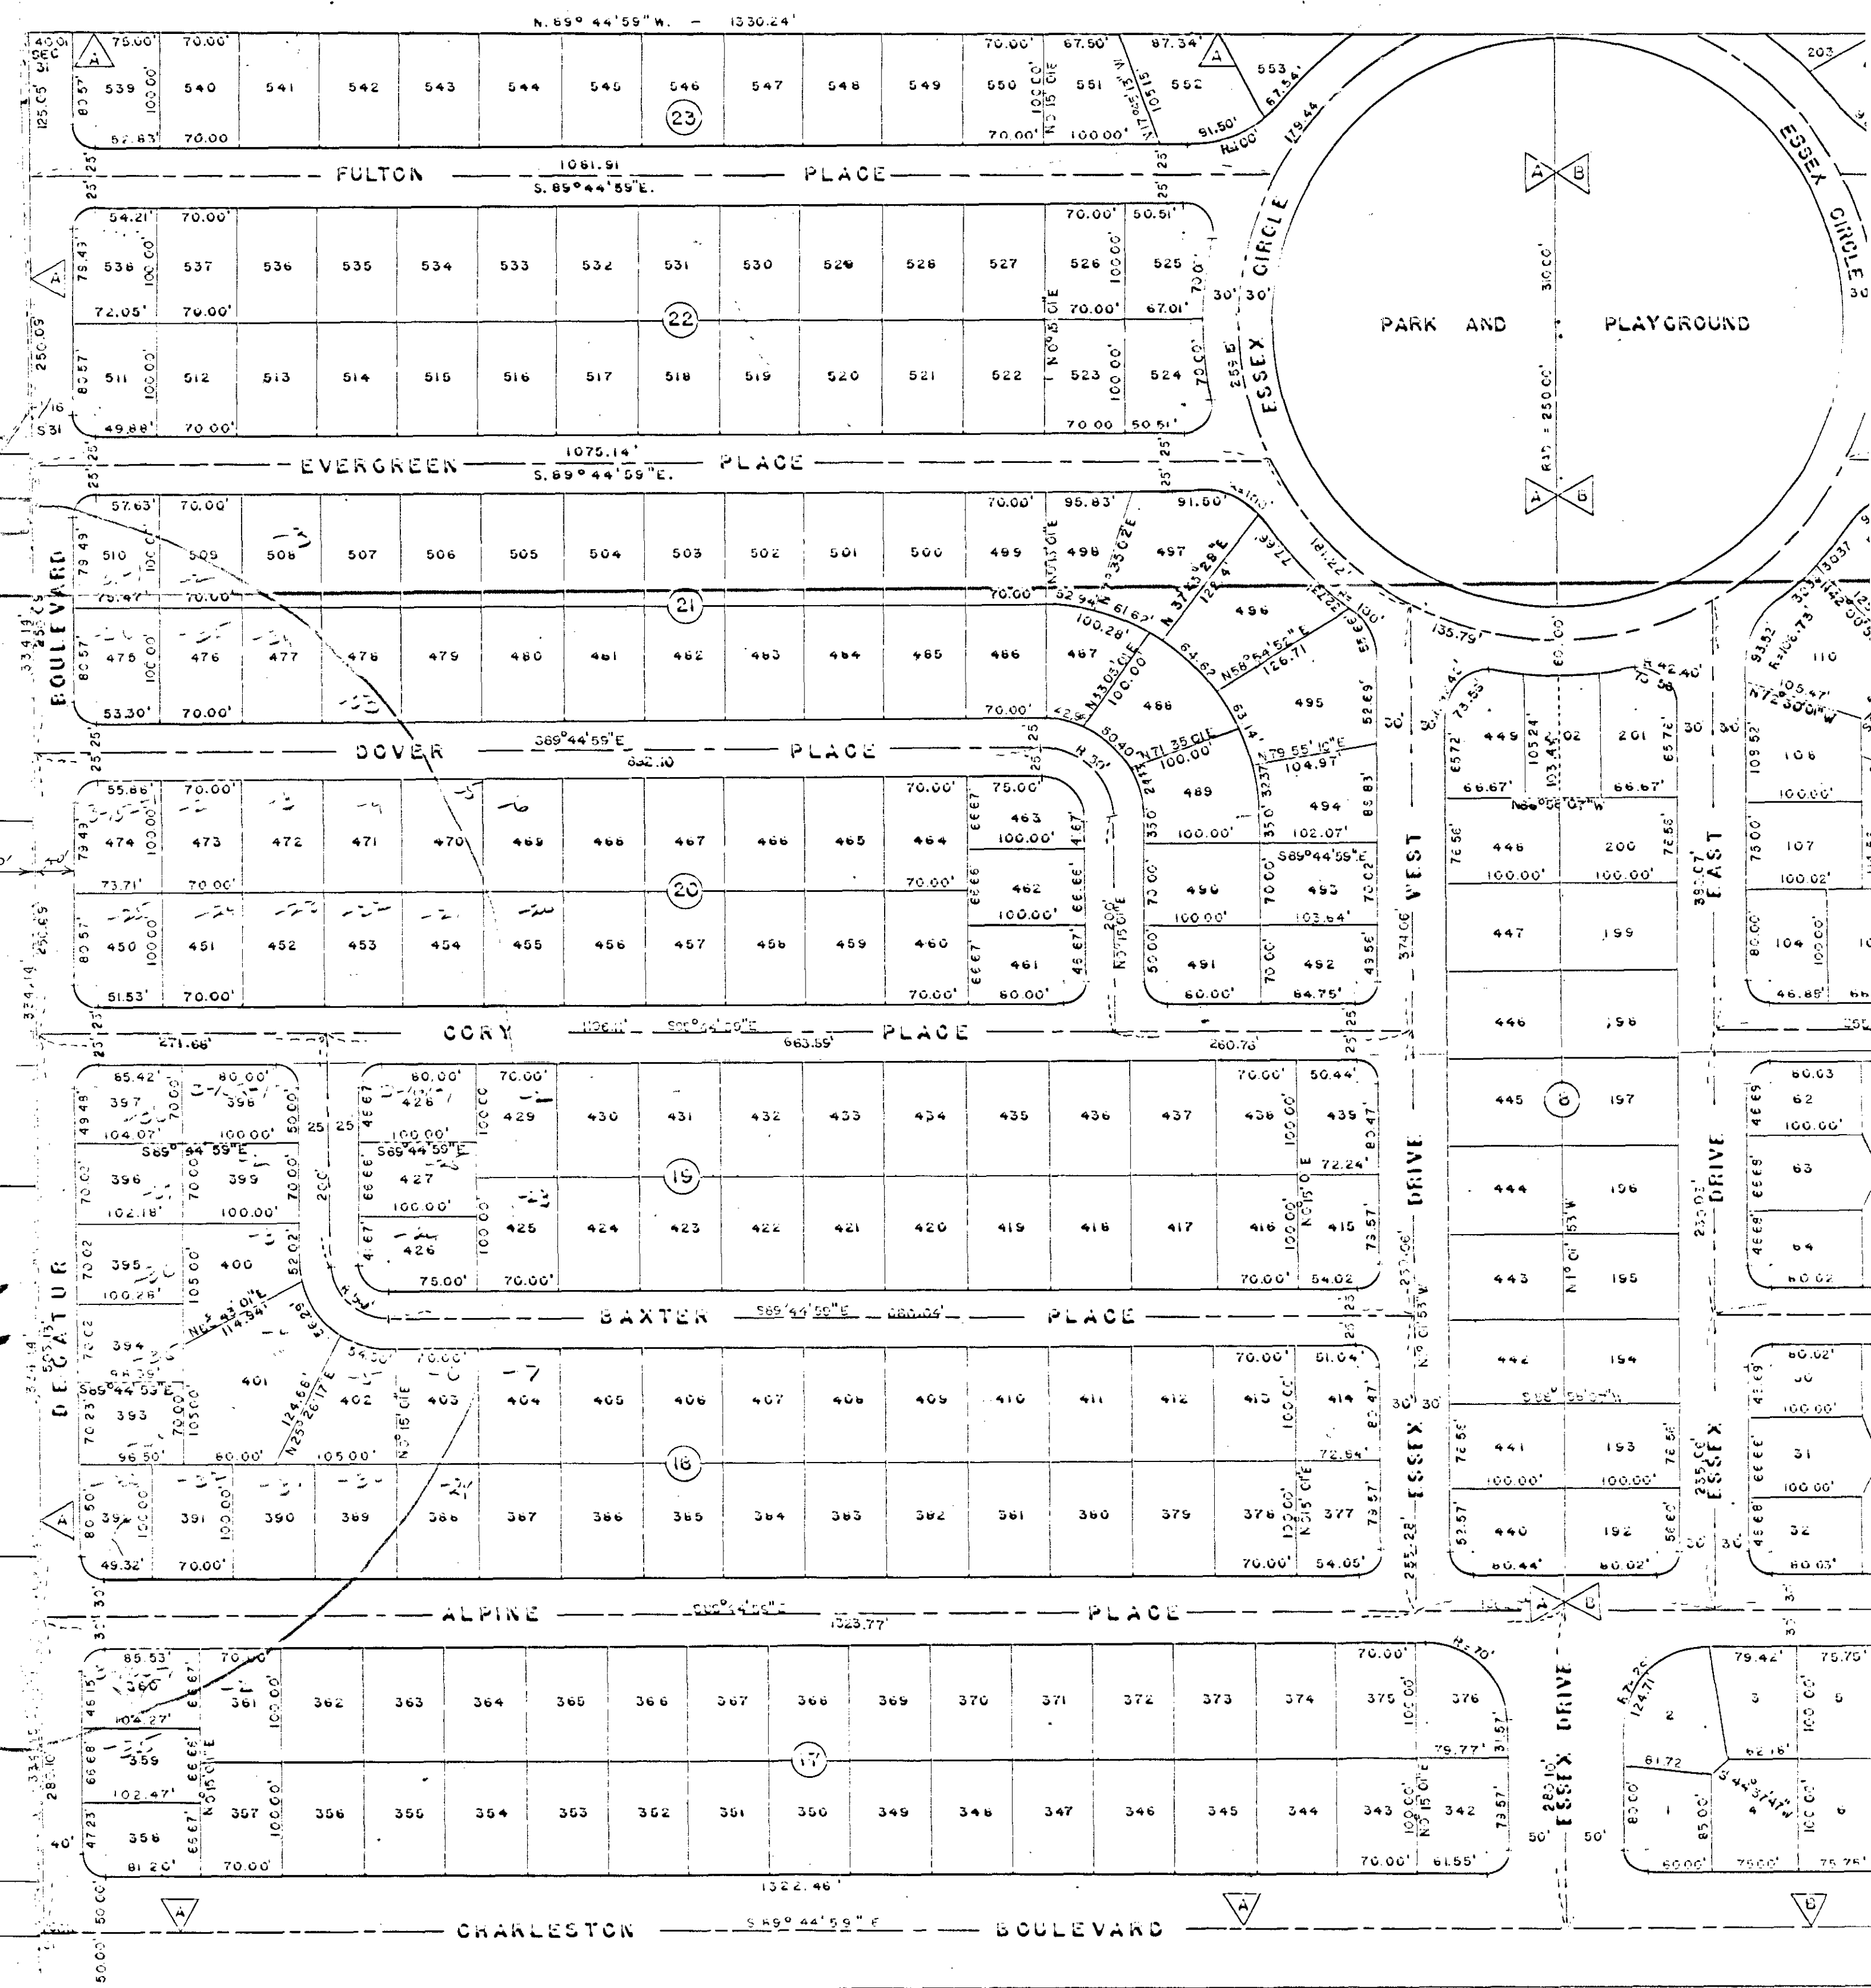

ALL RADII 20' UNLESS SHOWN

APPROVED
Z-50-62
JONES

Z-150-62

Z150

Denied 1/14/63 PC. SHEET NO. 108 R7 TO C-1 OR C-2