


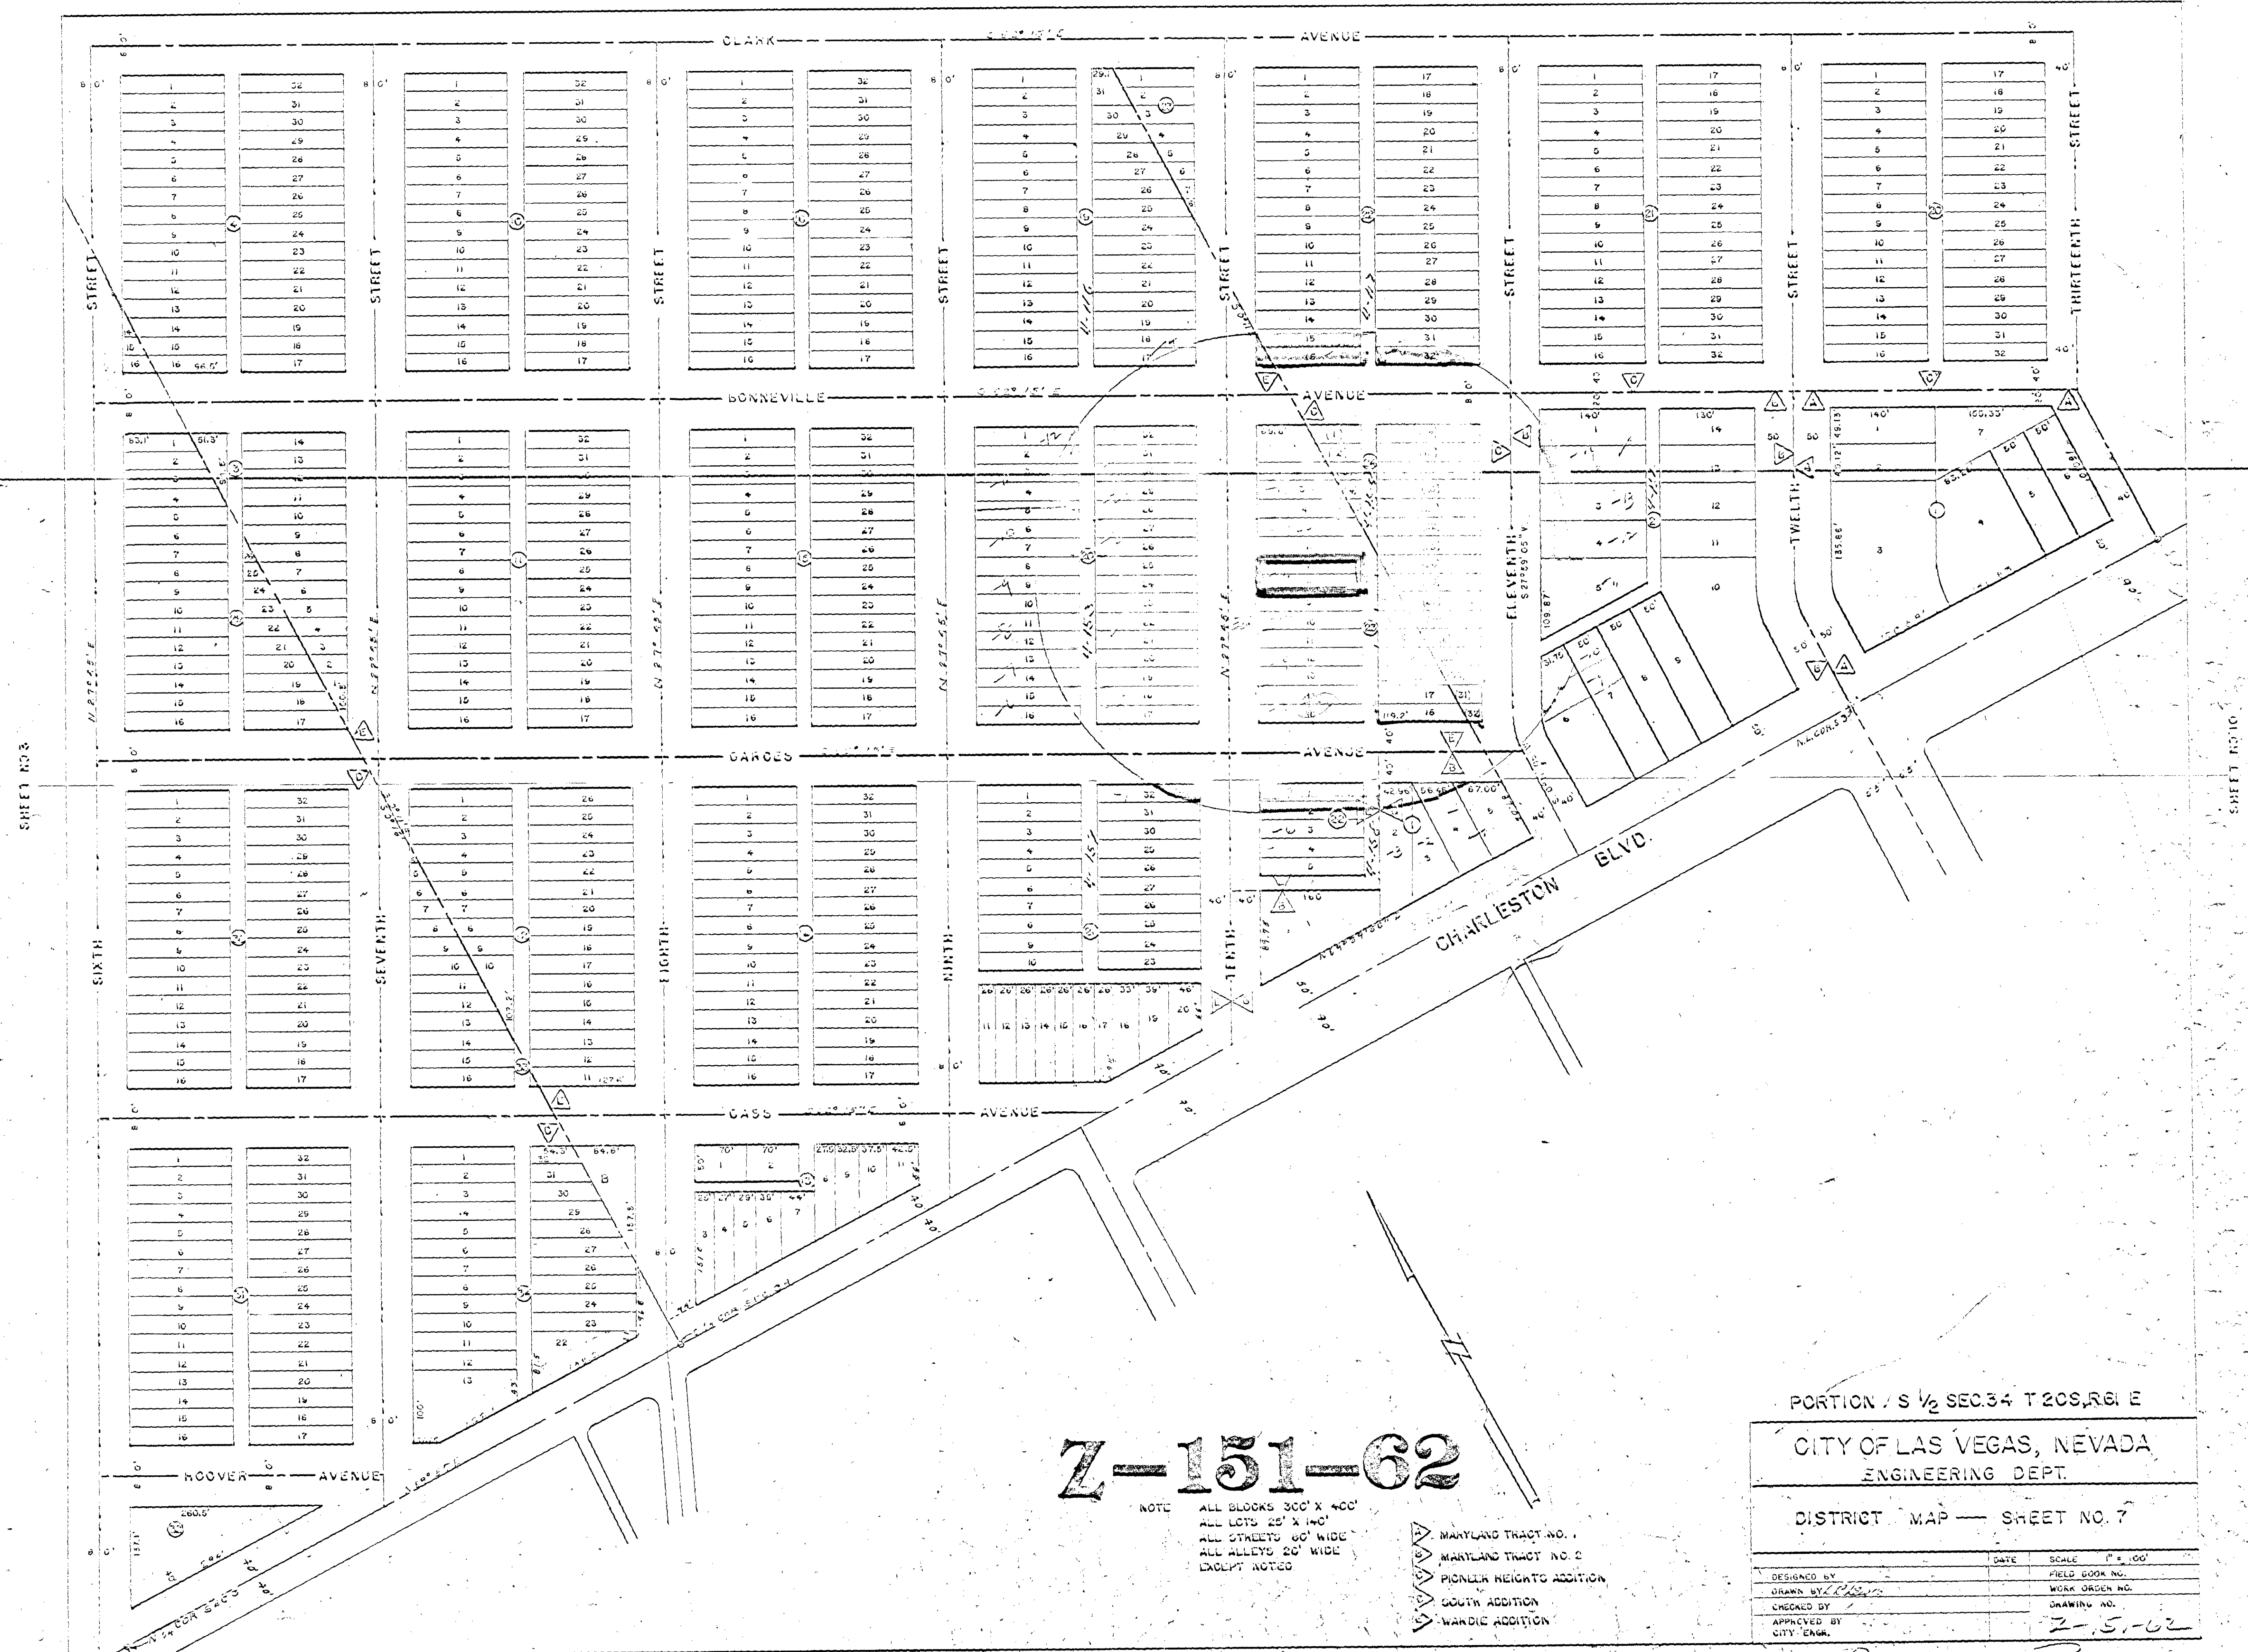

Z-151-62

NOTE
ALL BLOCKS 300' X 400'
ALL LOTS 25' X 140'
ALL STREETS 60' WIDE
ALL ALLEYS 20' WIDE
EXCEPT NOTED

- ✓ MARYLAND TRACT NO. 1
- ✓ MARYLAND TRACT NO. 2
- ✓ PIONEER HEIGHTS ADDITION
- ✓ SOUTH ADDITION
- ✓ WARDIE ADDITION

PORTION 1/2 SEC. 34 T. 20S. R. 1E
CITY OF LAS VEGAS, NEVADA
ENGINEERING DEPT.

DISTRICT MAP — SHEET NO. 7

DESIGNED BY	DATE	SCALE
DRAWN BY		1" = 100'
CHECKED BY		
APPROVED BY		
CITY ENGR.		

Designed
10/1/63 P.C.
Reccole
R-1 TO R-3

2-151