


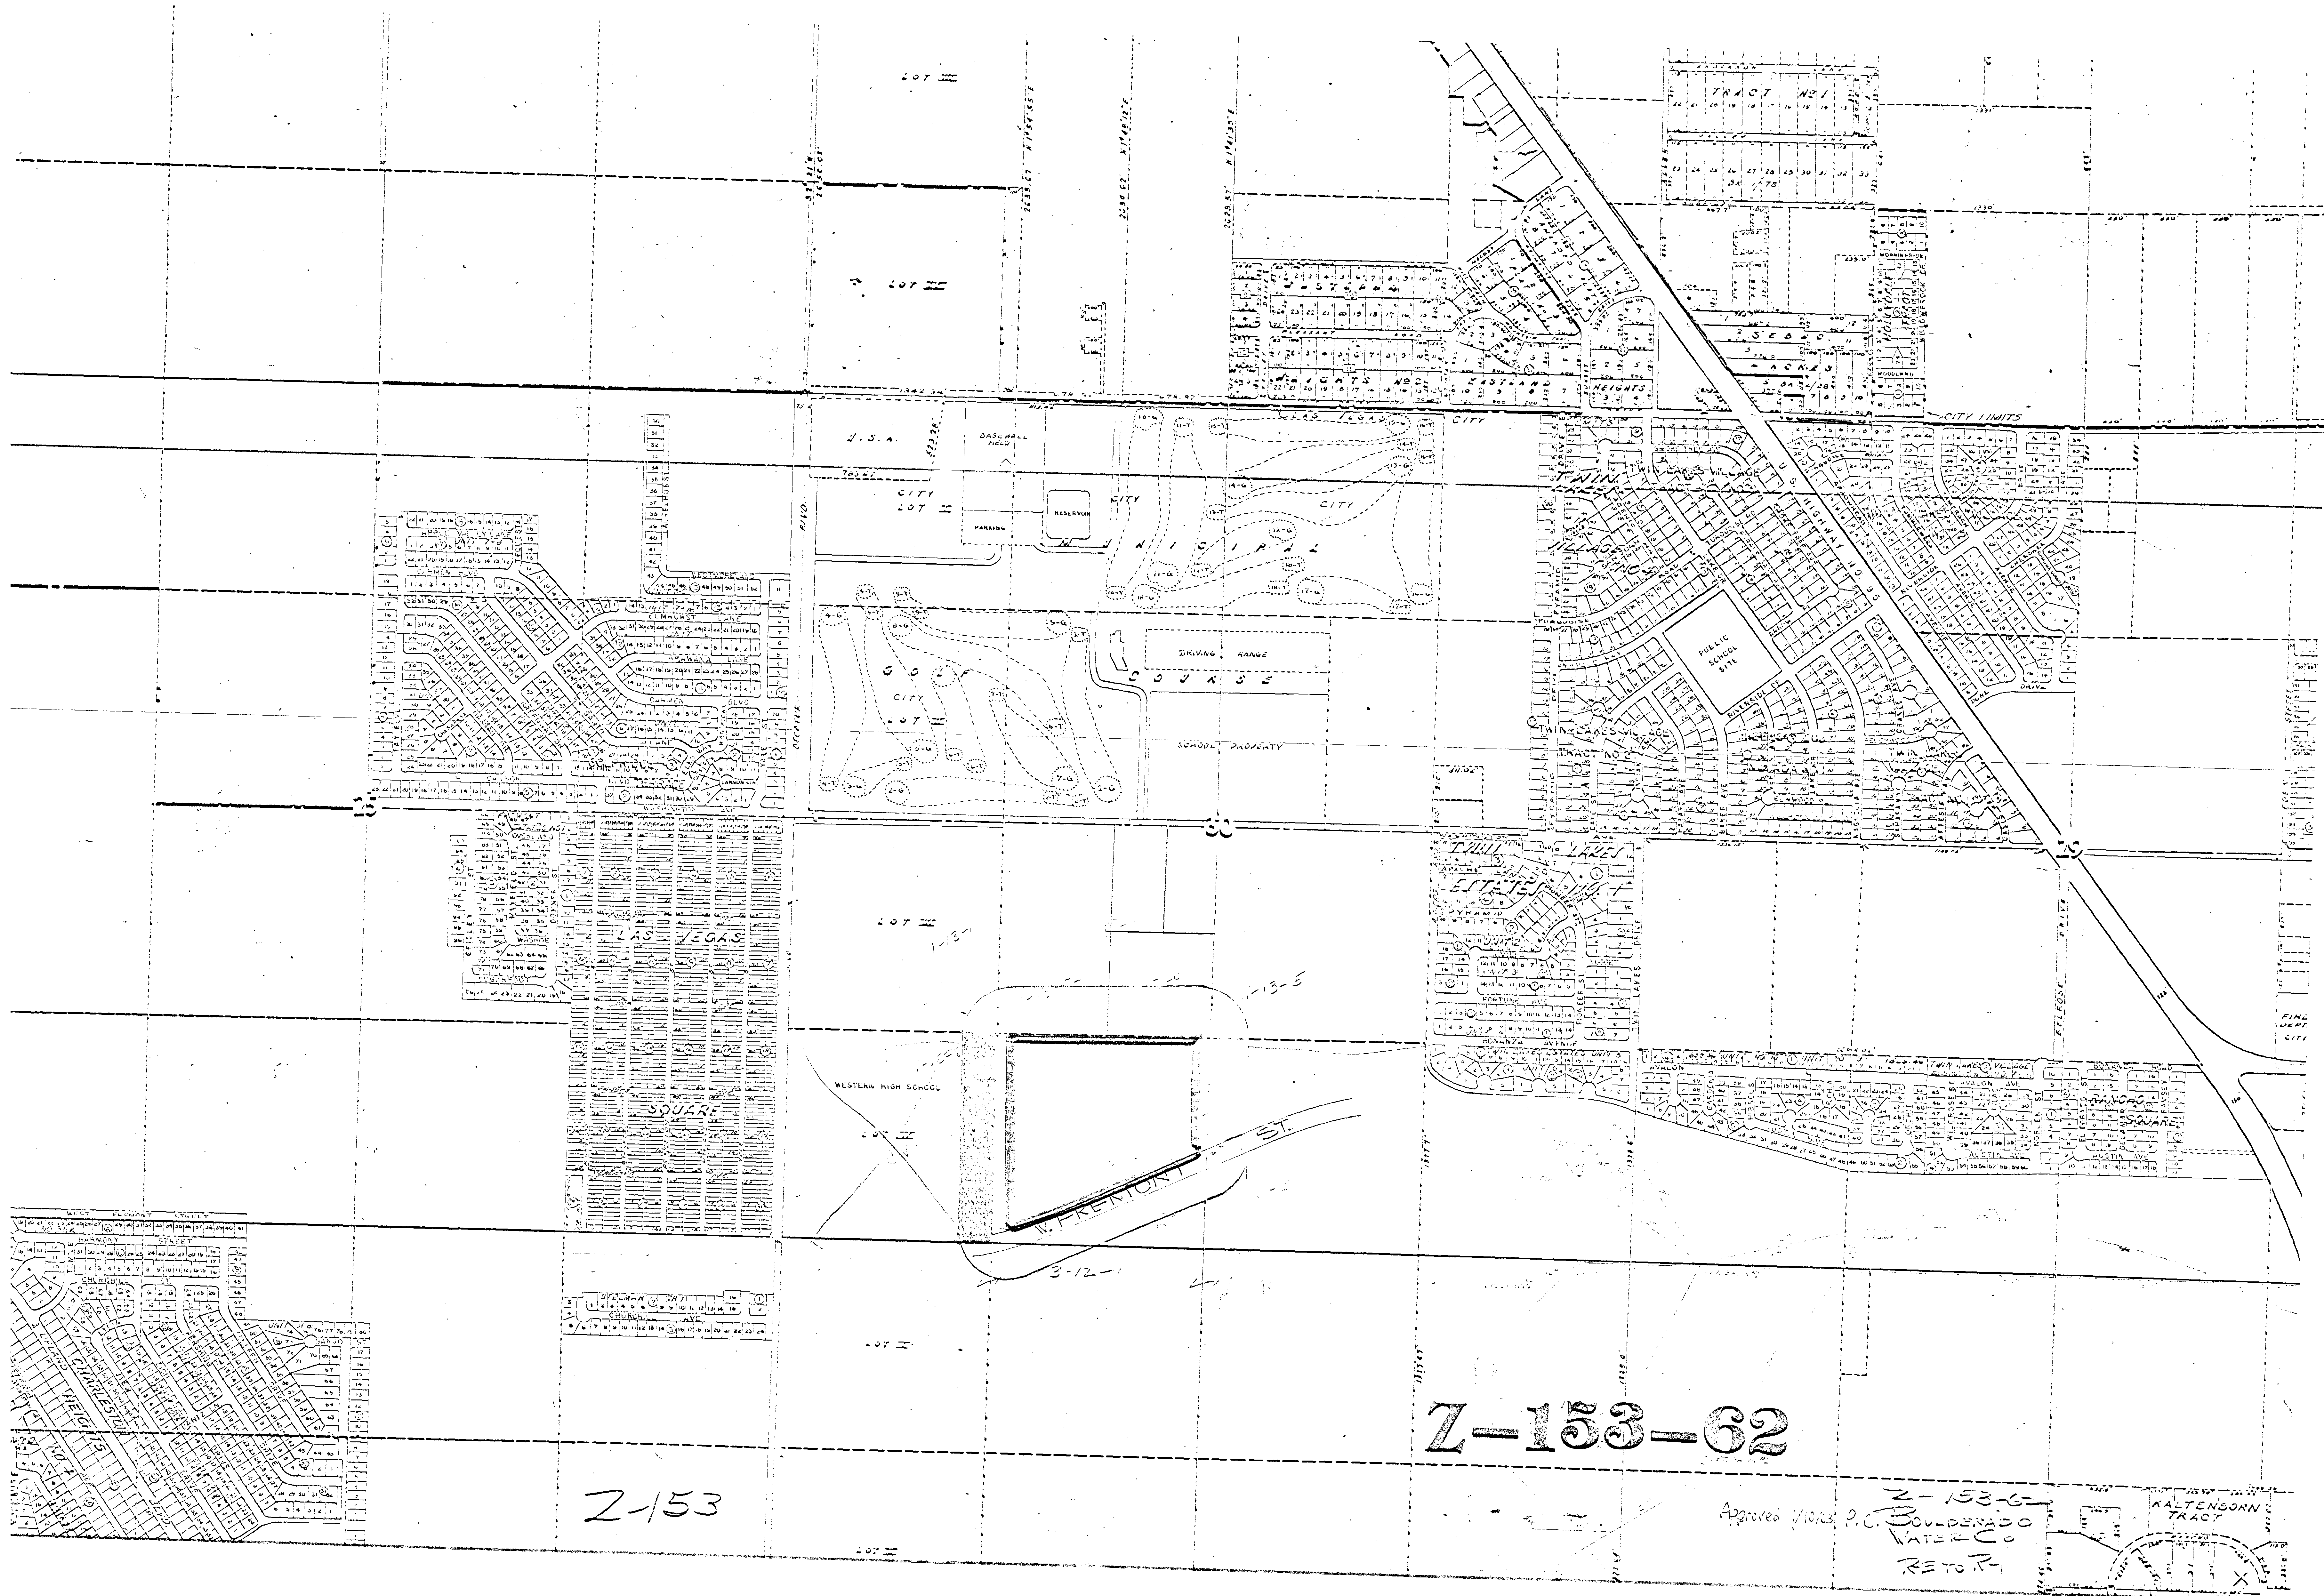

Z-153-62

Z-153

Approved: *[Signature]* P.C. BOULDERADO
KALTENBORN TRACT
RETOPI