


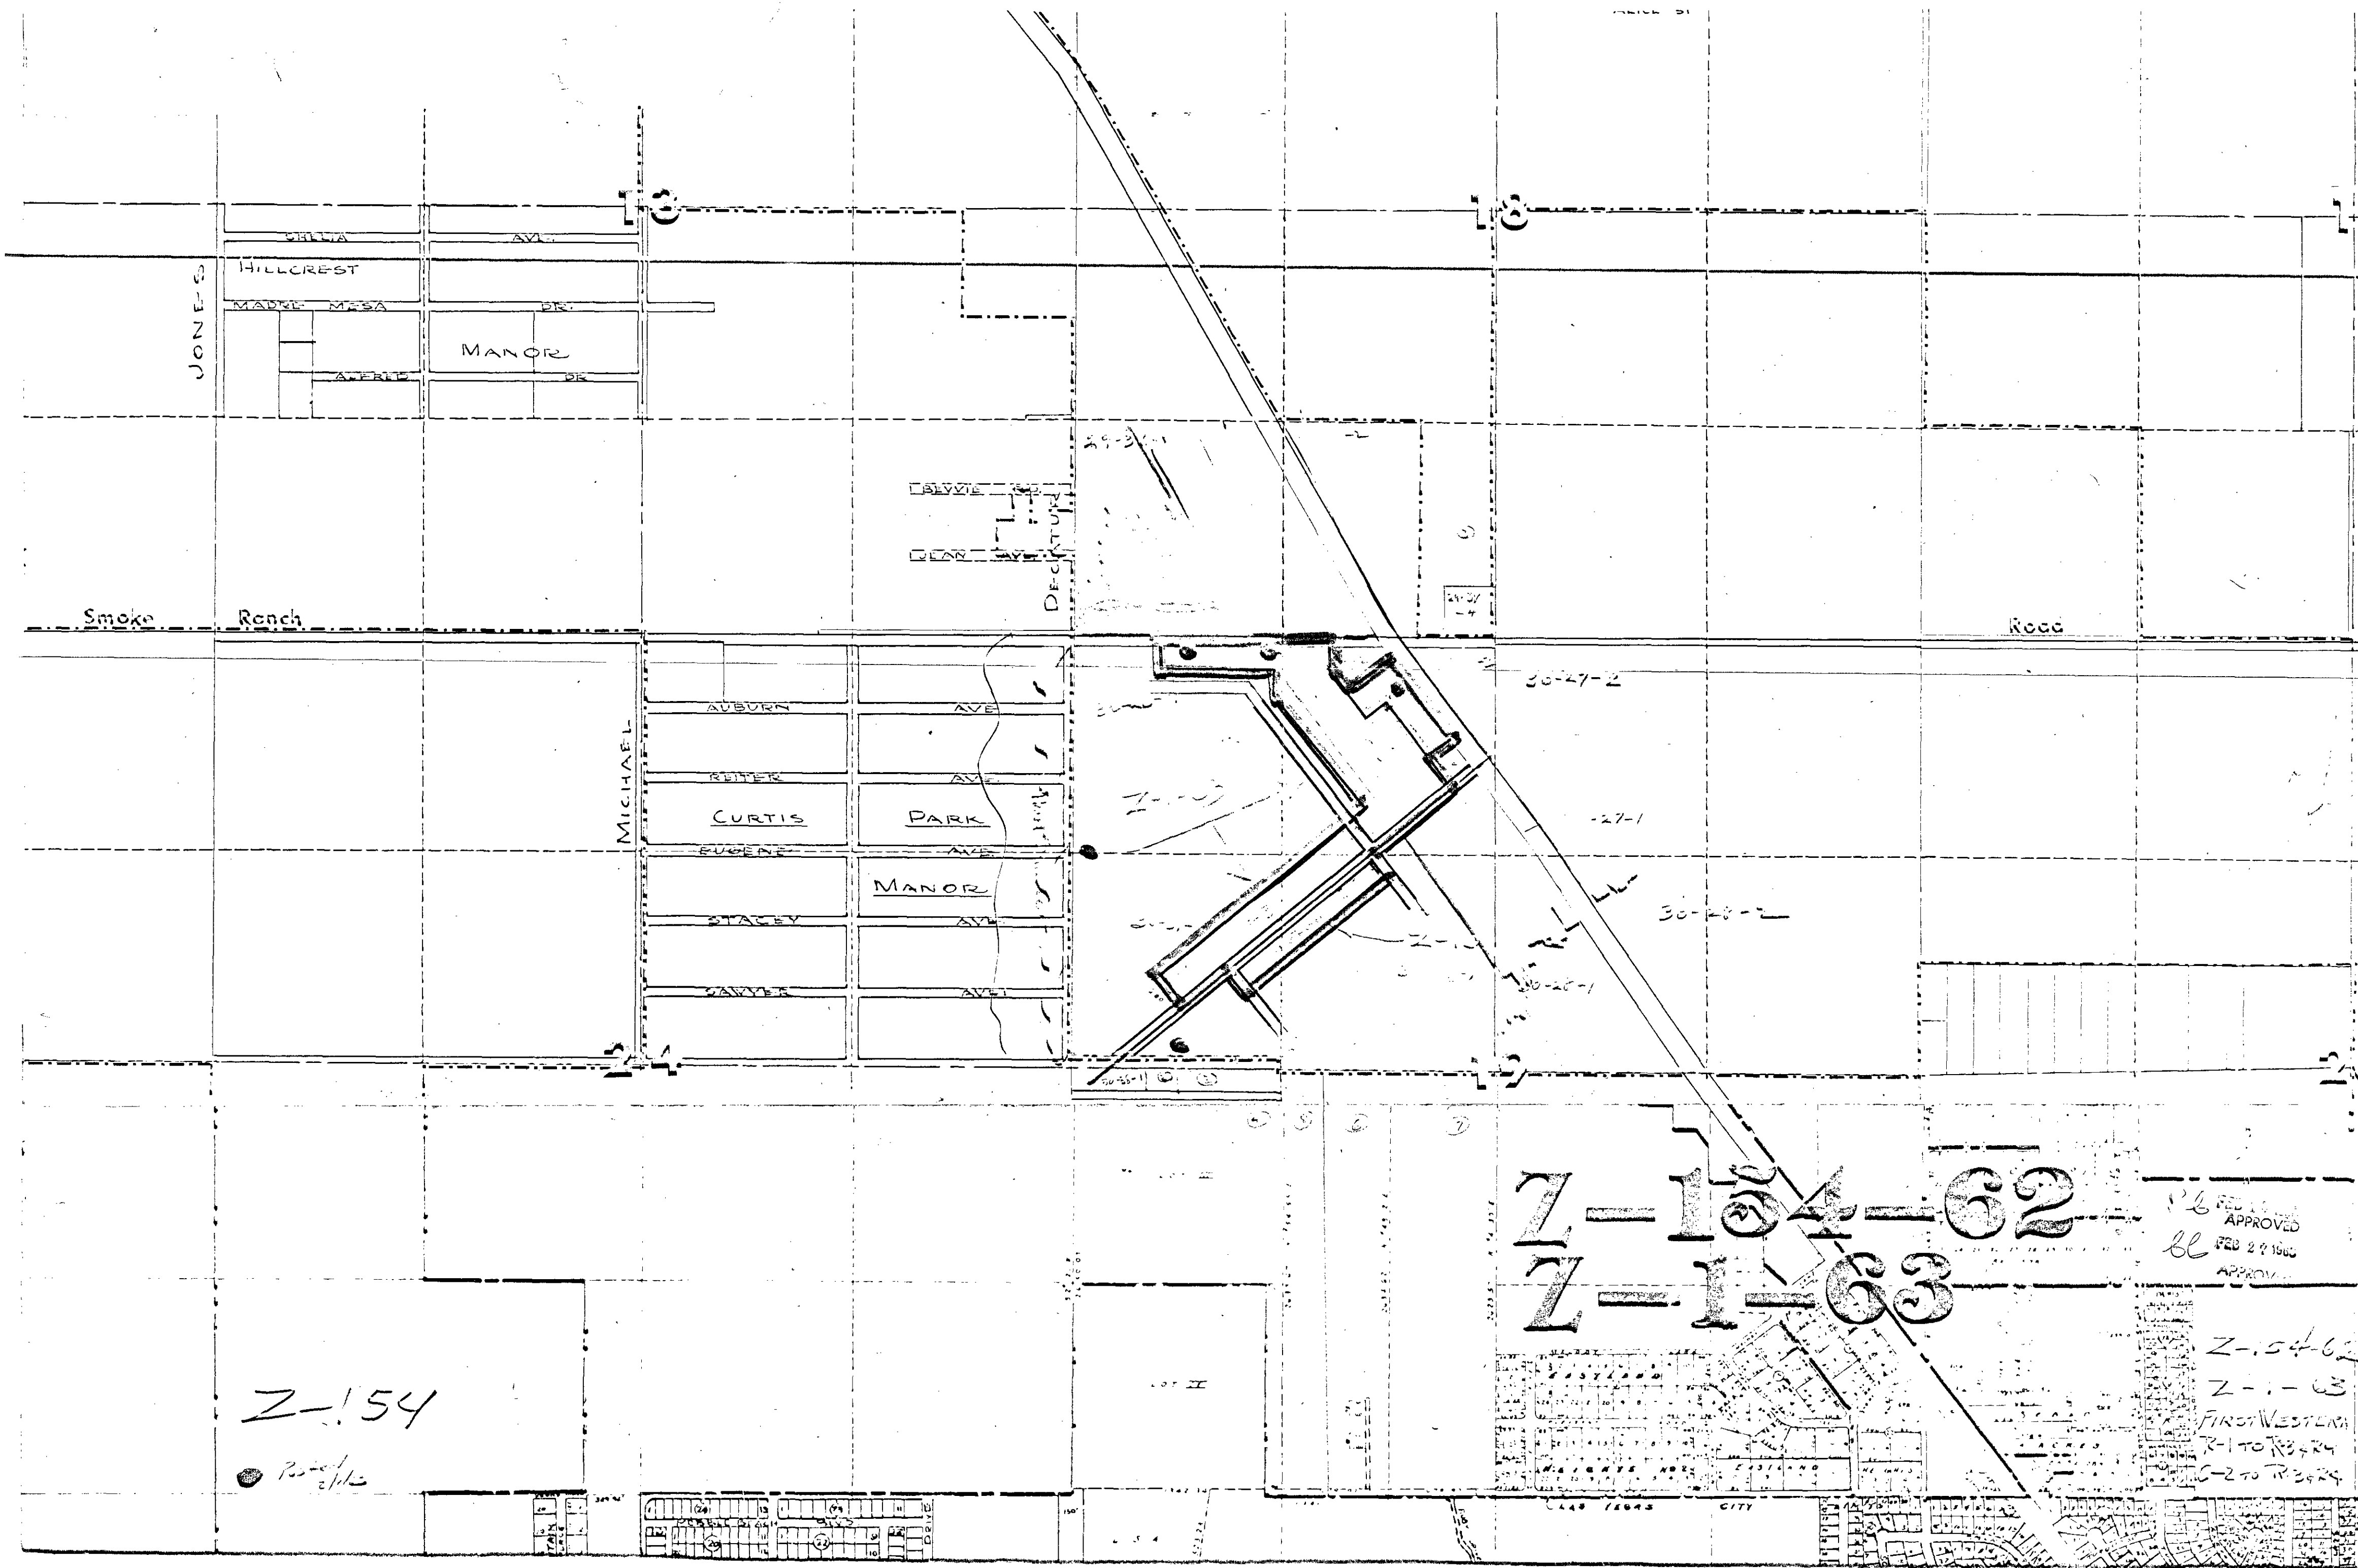

Z-154

Post 2/1/62

Z-154-62
Z-1-63

PL 16 FEB 1962
APPROVED
bl FEB 27 1962
APPROVED

Z-154-62
Z-1-63
FIRST WESTERN
R-1 TO R-24
C-2 TO R-24