

ALL AREAS
NOT COLORED
ARE R-1


REB FEB 14 1963
DENIED

BE FEB 24 1966
DENIED

Z-157-62

Z-157-62
ALOHA COVER
R-1 to R2


4/6 • Z-157

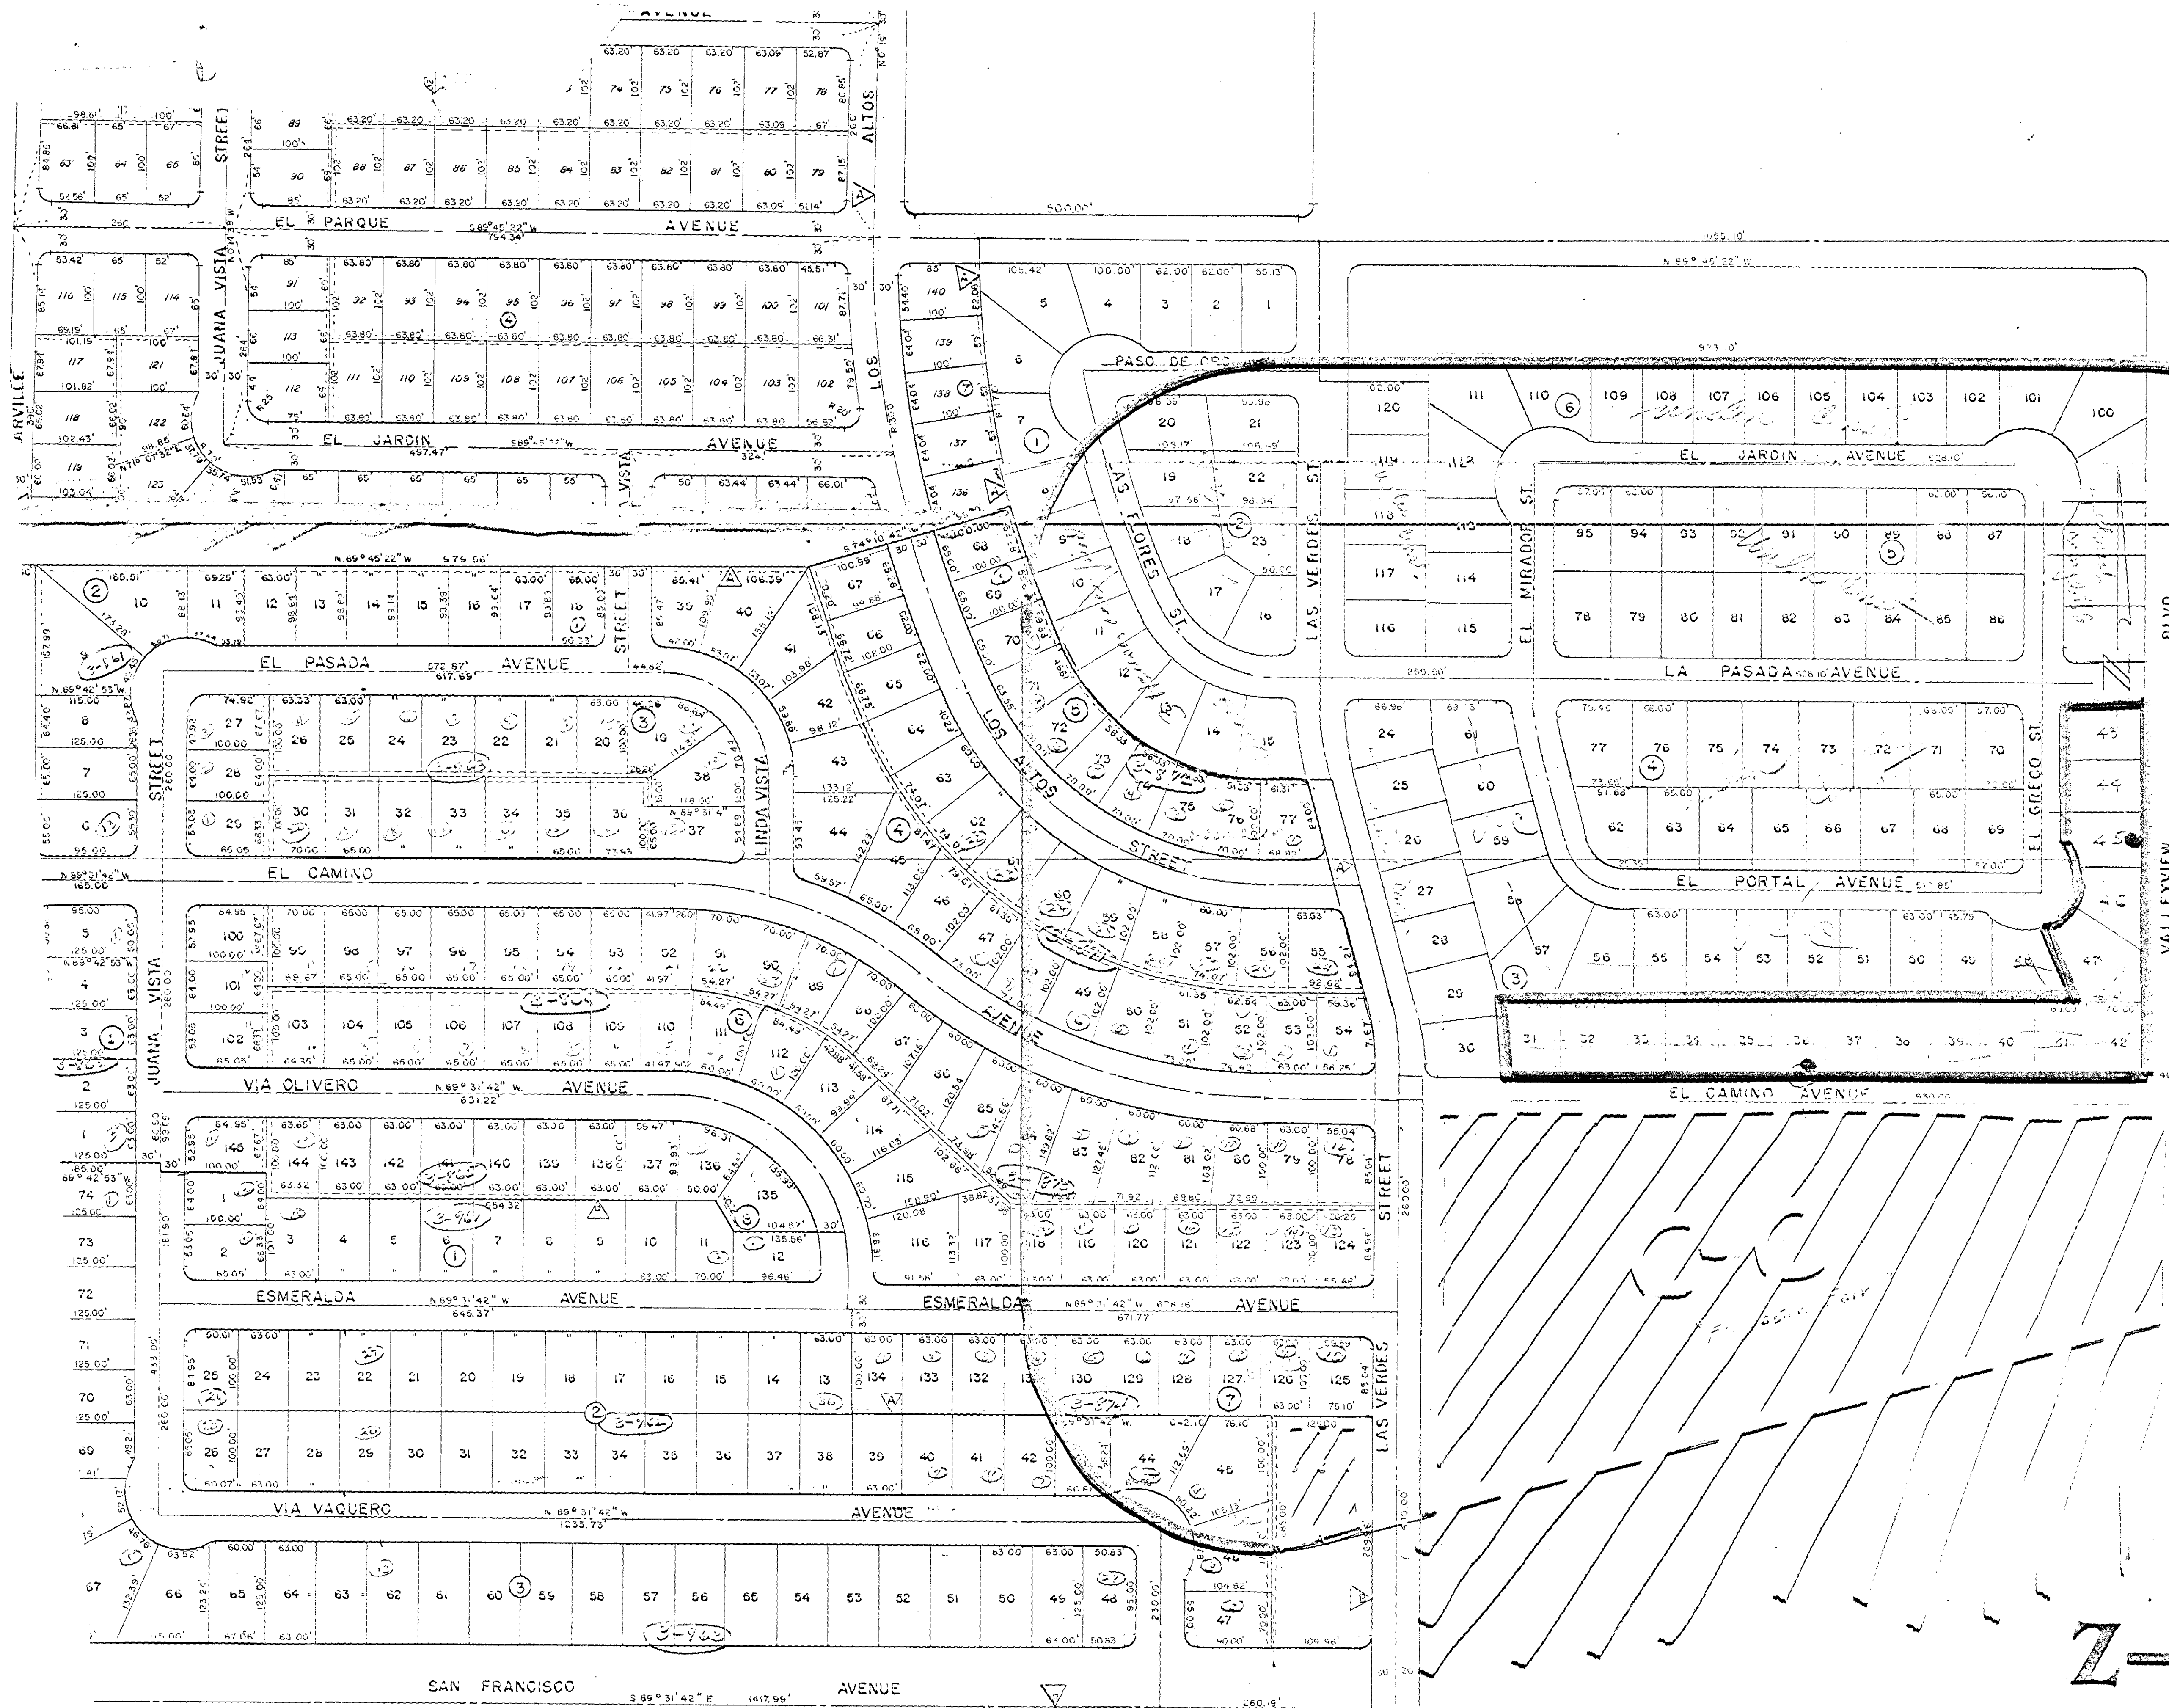

LAS VERDES HEIGHTS

UNIT No. 5

PLOT PLAN

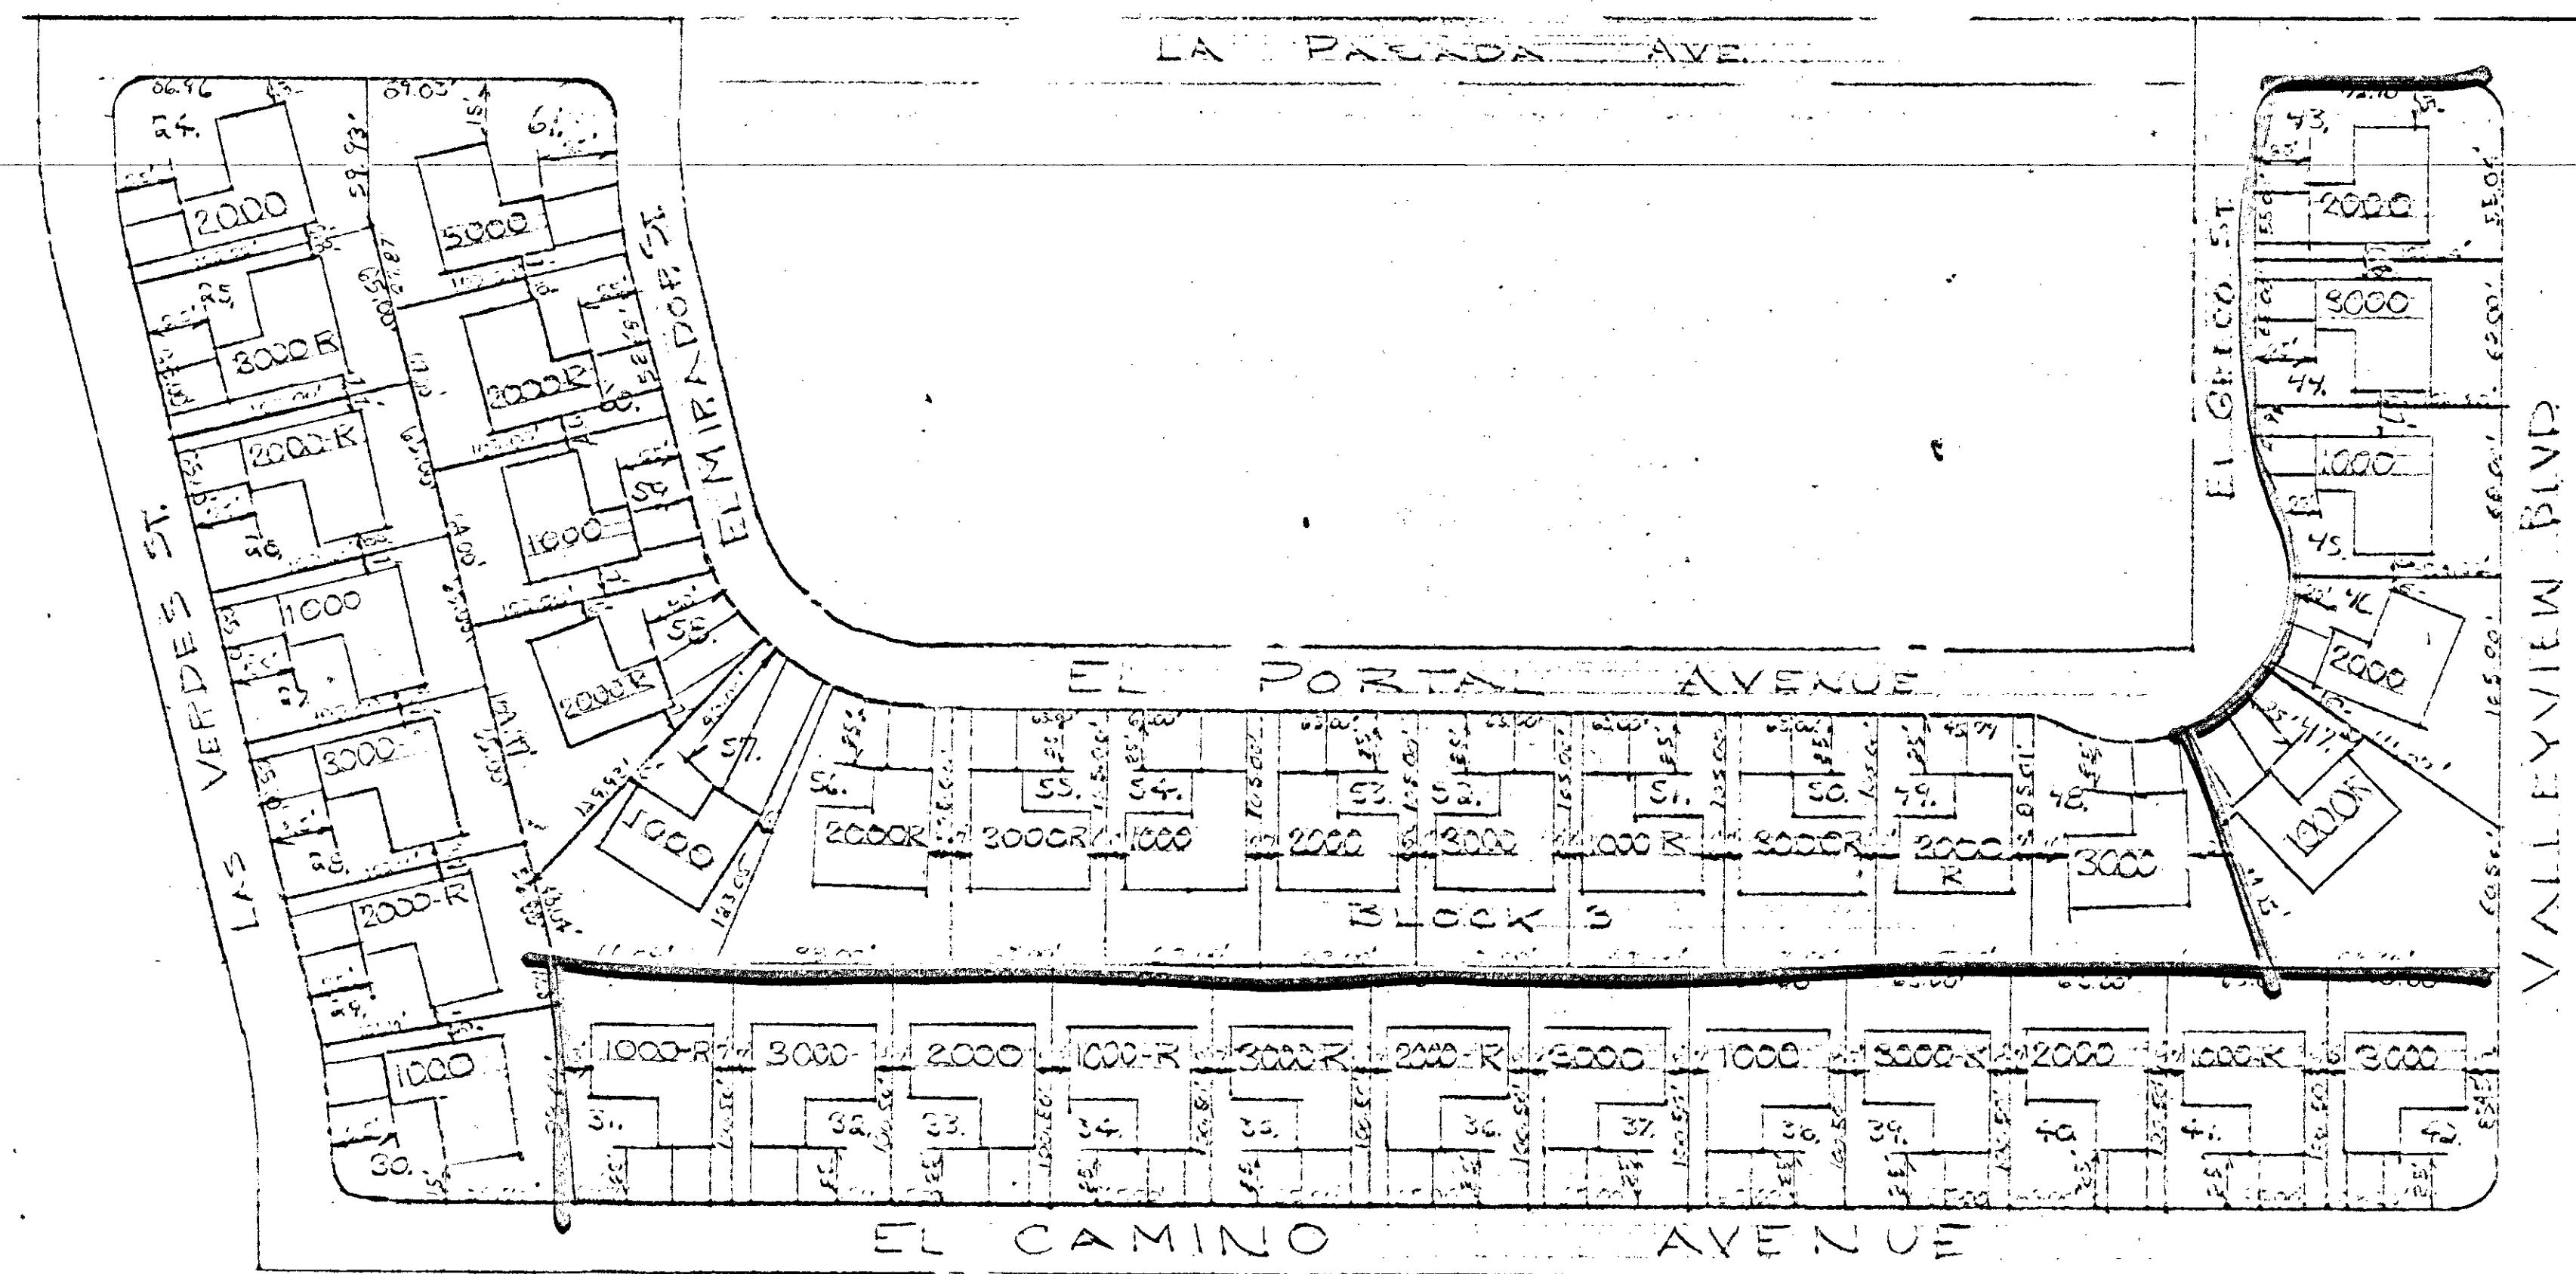

SCALE 1" = 40.00'

ALOHA CONSTRUCTION CO.

SCALE:	APPROVED BY:
DATE:	

2-157

0018 1/183