


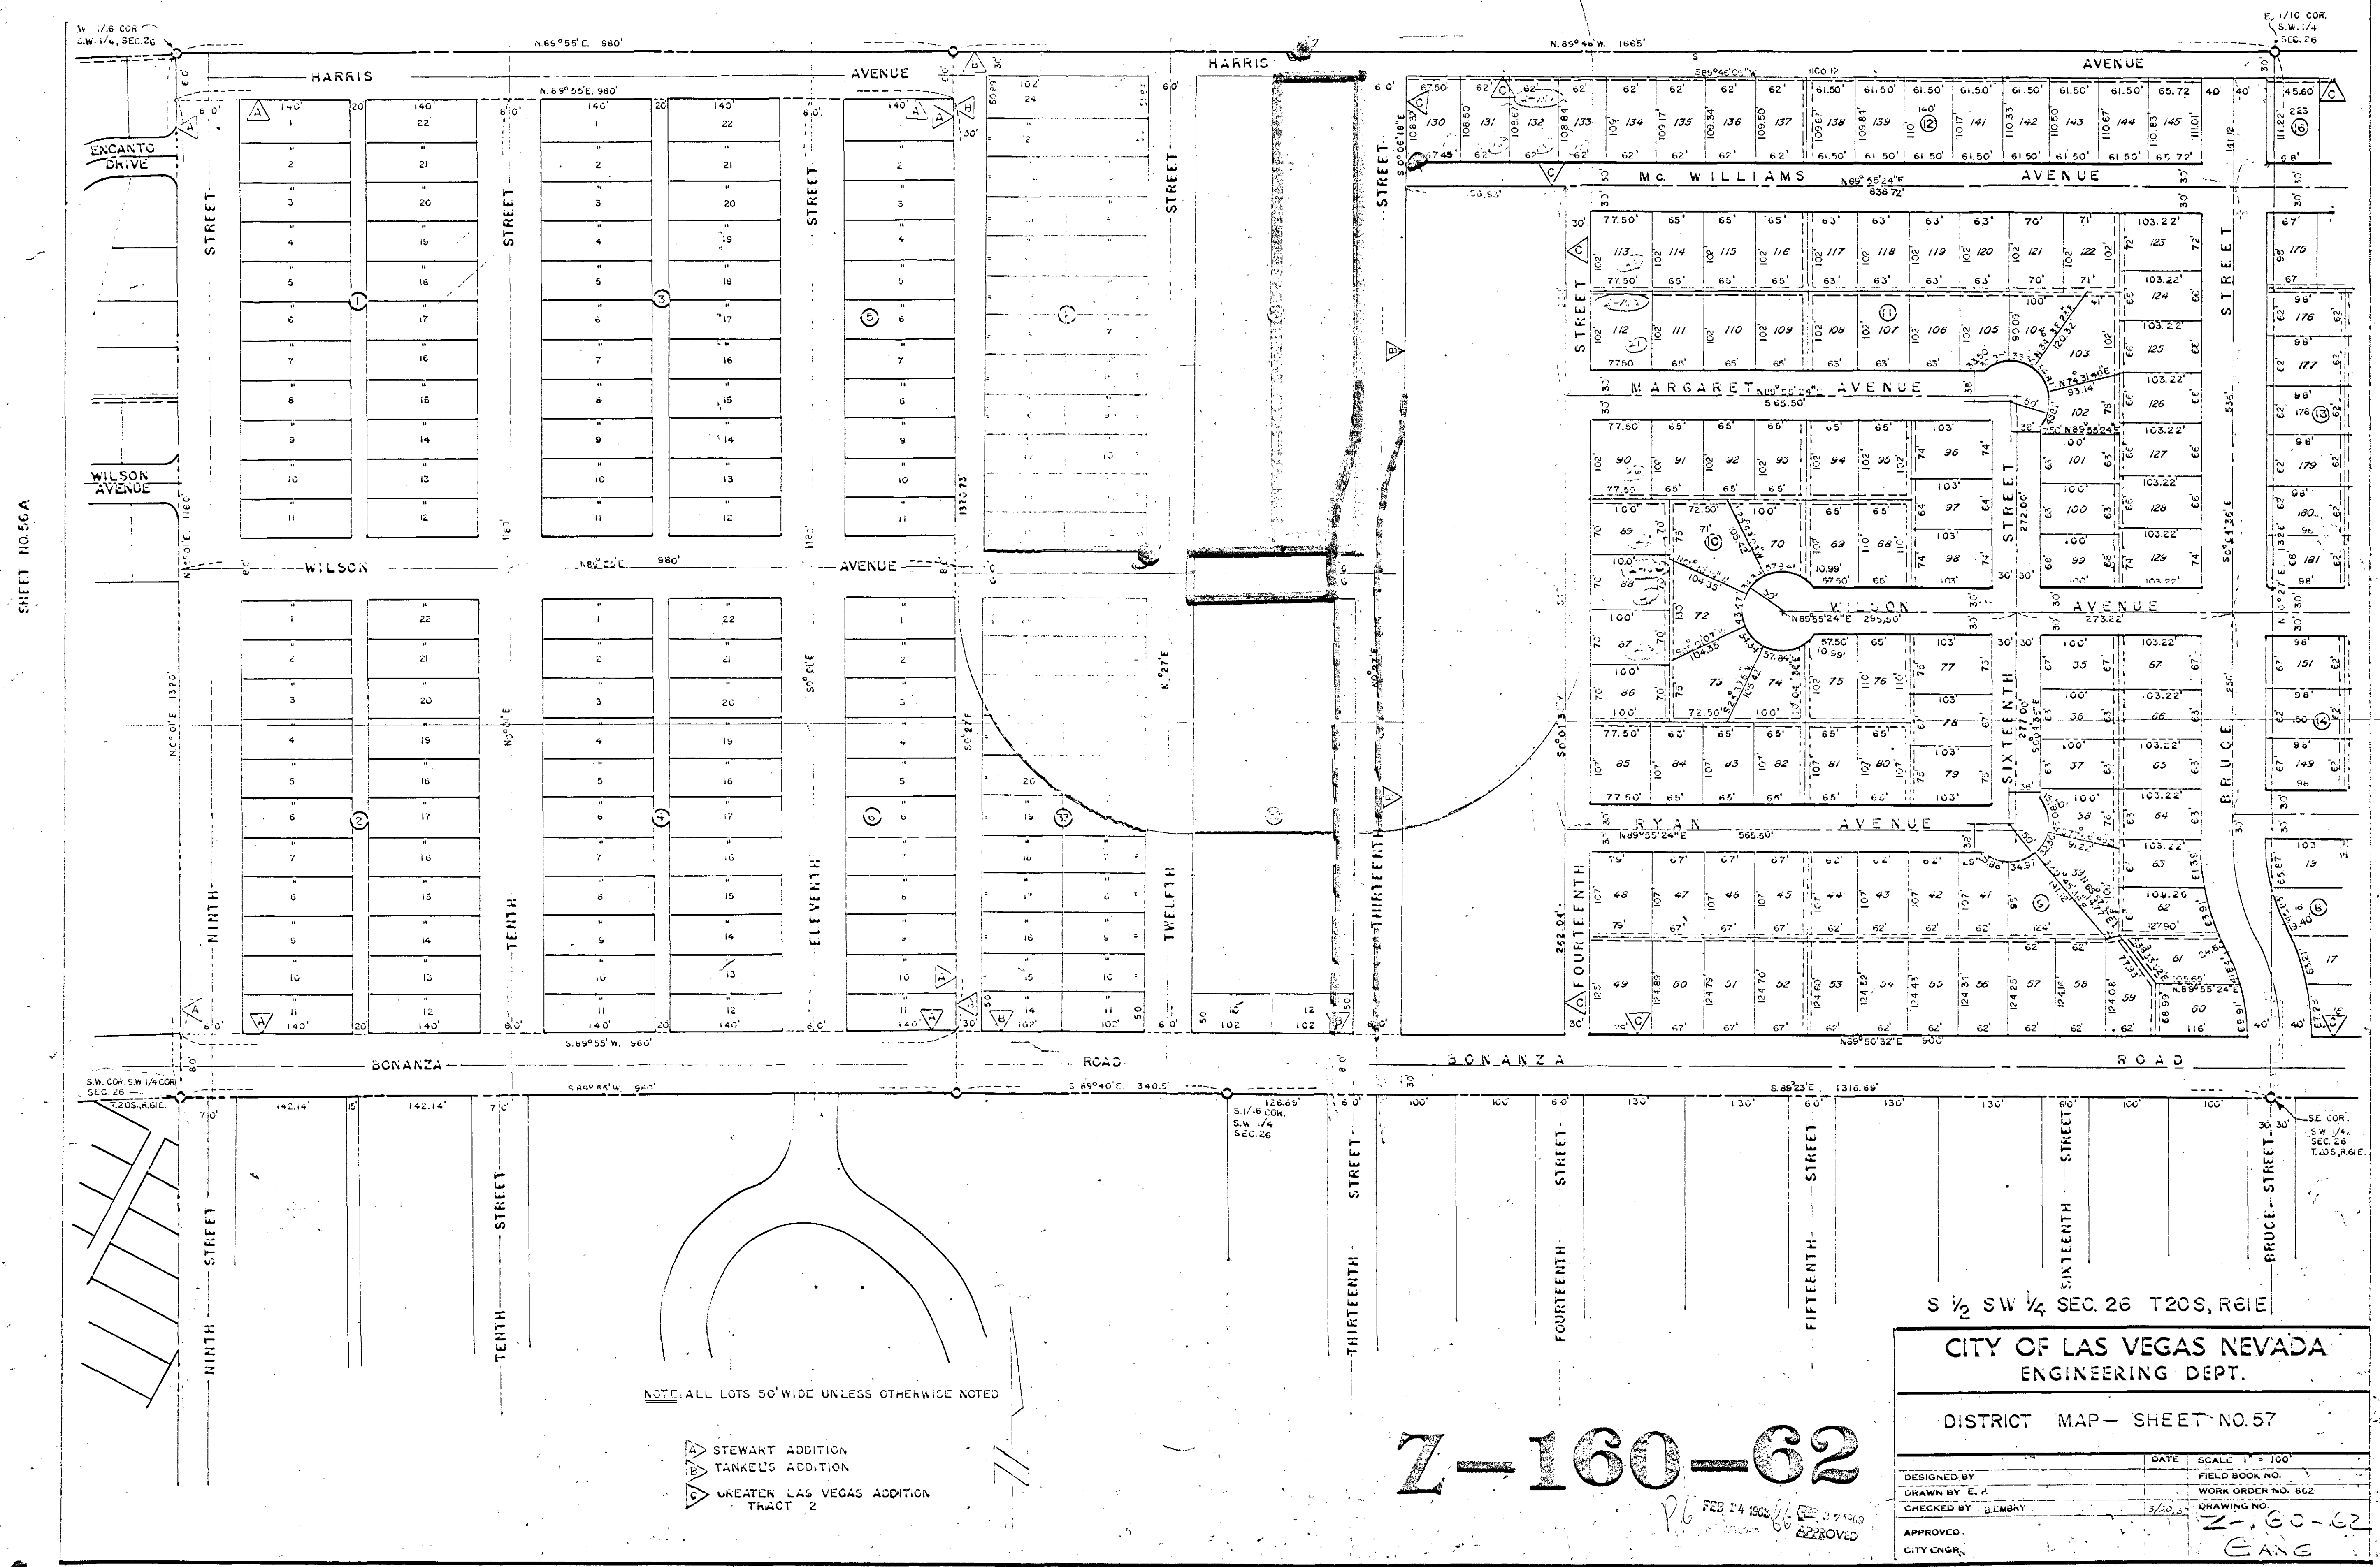



NOTE: ALL LOTS 50' WIDE UNLESS OTHERWISE NOTED

- STEWART ADDITION
- TANKELO'S ADDITION
- GREATER LAS VEGAS ADDITION TRACT 2

Z-160-62

S 1/2 SW 1/4 SEC. 26 T20S, R61E

CITY OF LAS VEGAS NEVADA
ENGINEERING DEPT.

DISTRICT MAP - SHEET NO. 57

DESIGNED BY	DATE	SCALE 1" = 100'
DRAWN BY E. P.		FIELD BOOK NO.
CHECKED BY G. L. MARY	3/20/57	WORK ORDER NO. 662
APPROVED		DRAWING NO.
CITY ENGR.		Z-160-62
		EANG

Z-160

SHEET NO. 6