
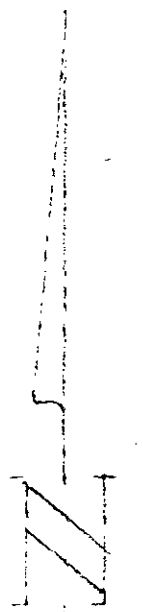


SANTA CLARA DRIVE

SUBMIT LINE
SIDEWALK
75' CURB

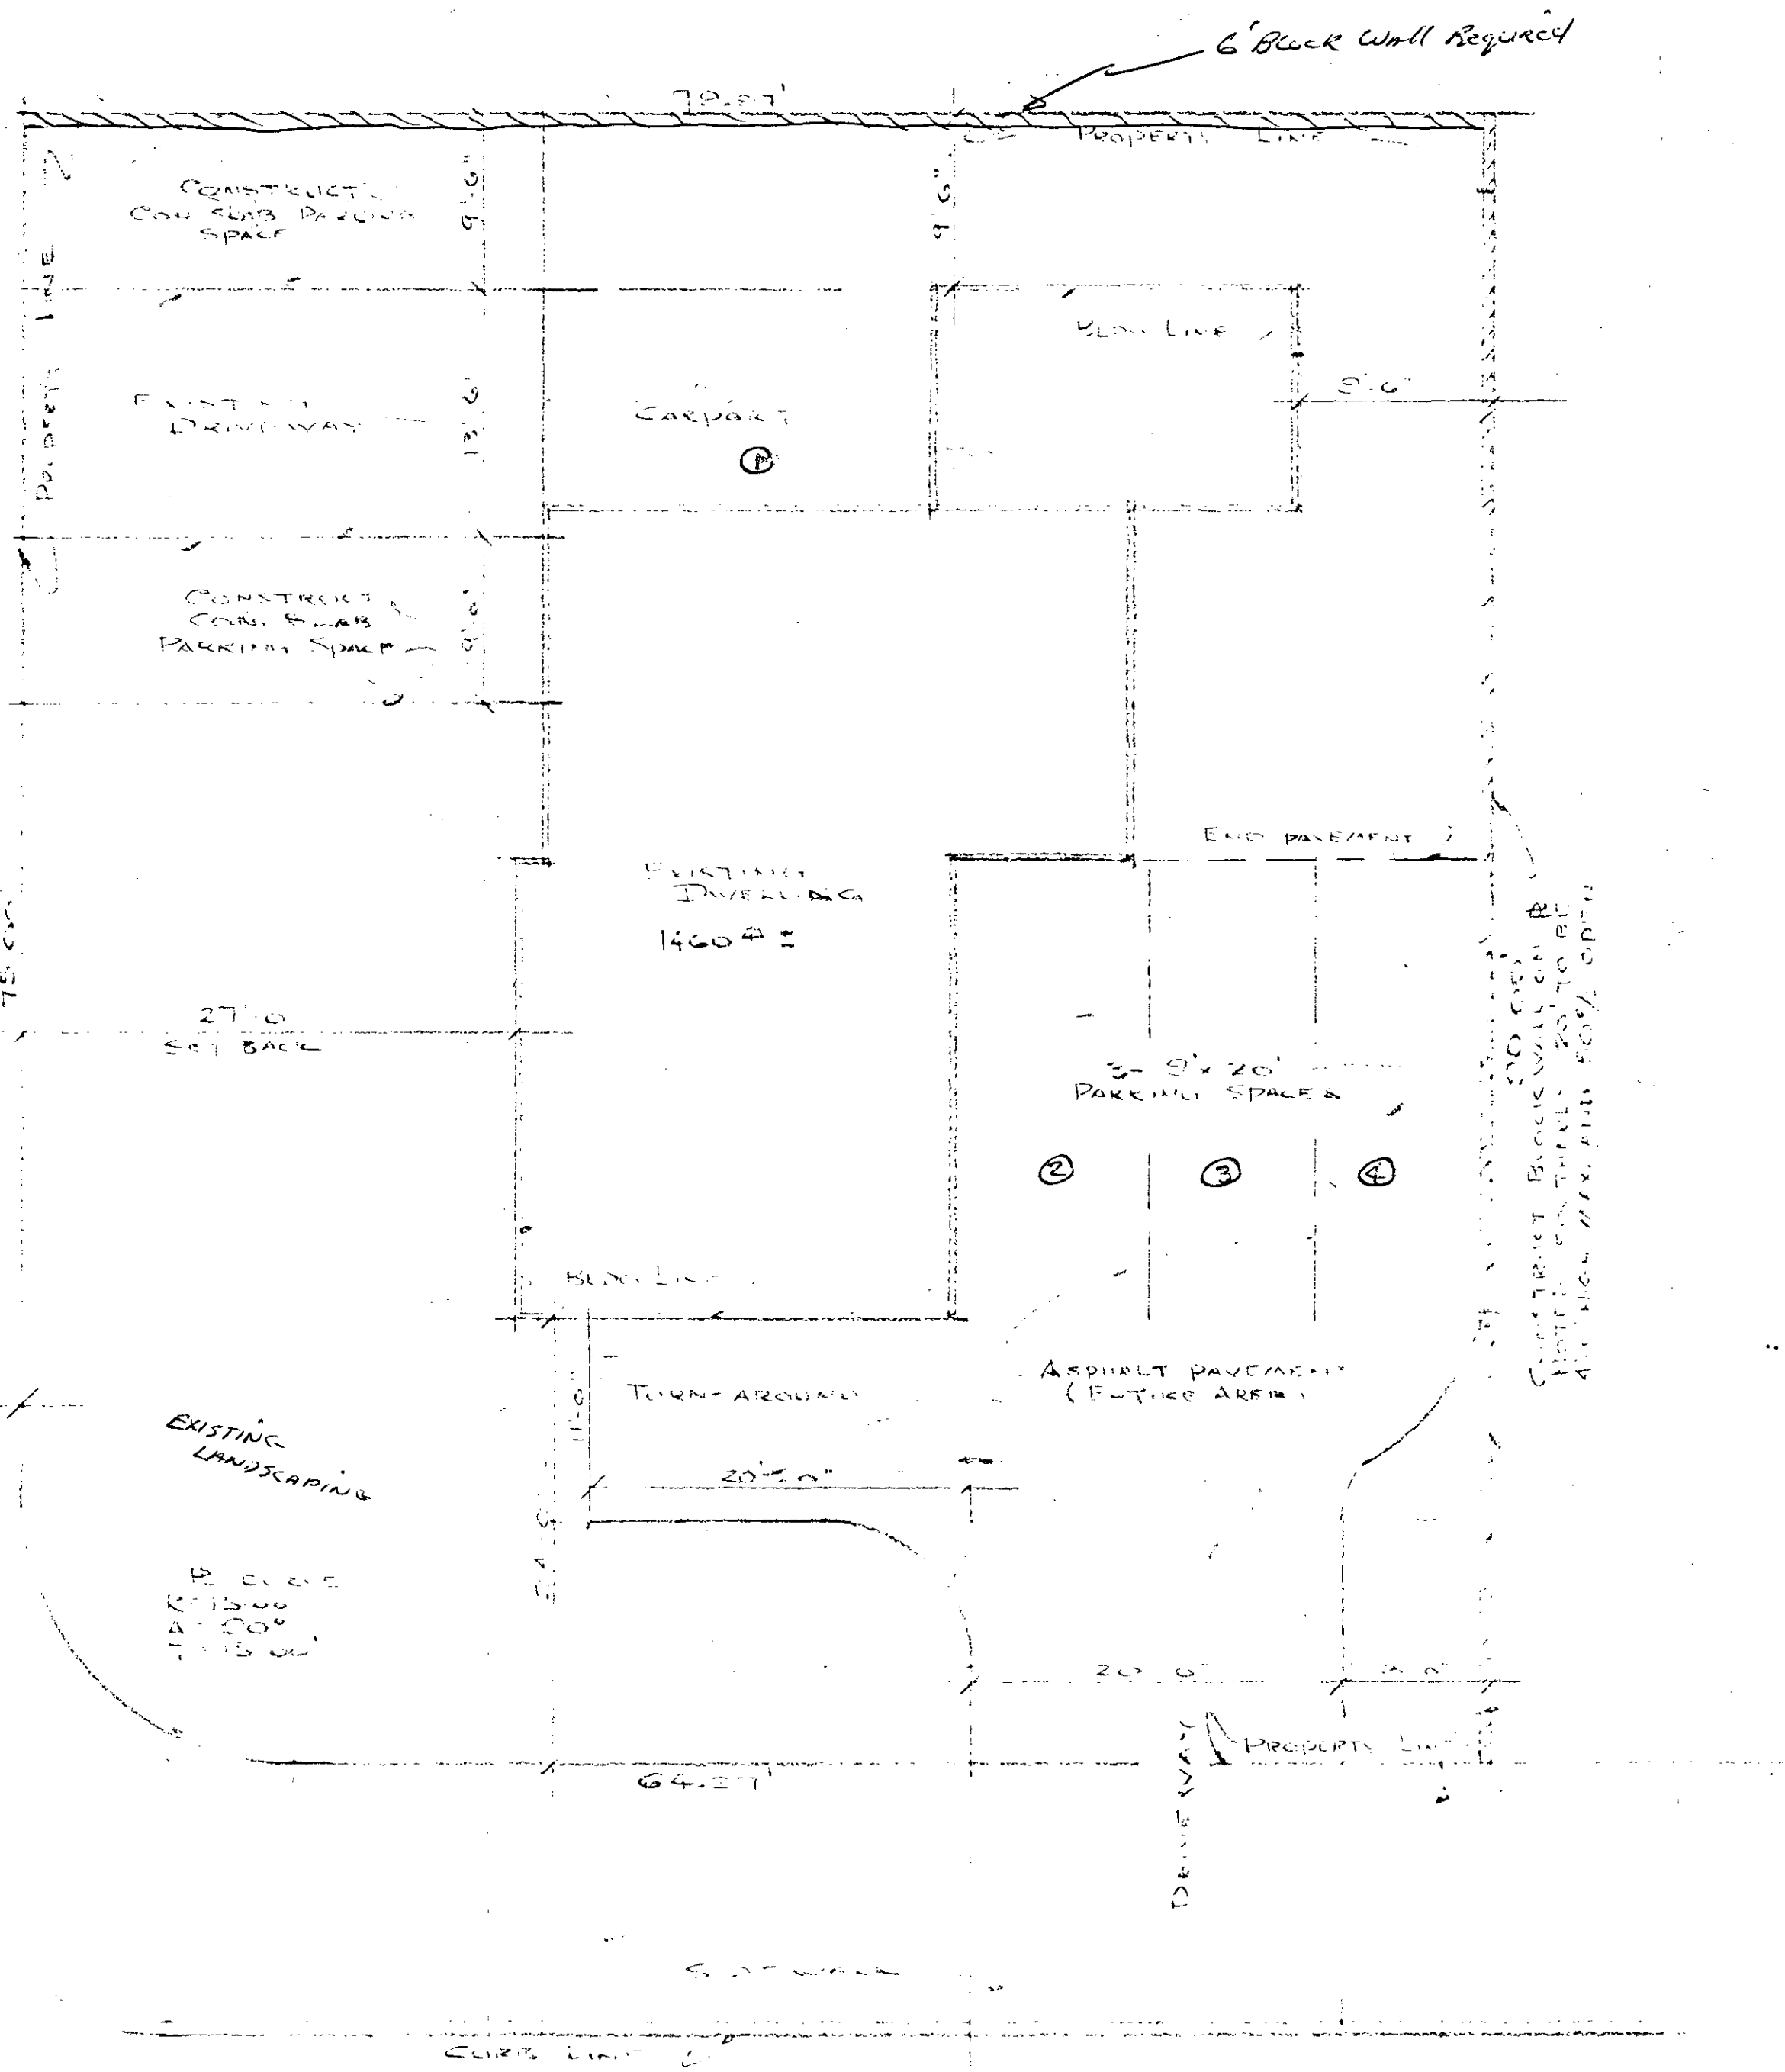

SCALE 1/8" = 1' 0"

LEGAL DESCRIPTION
 LOT 4, BLOCK 2
 PARADISE VILLAGE
 TRACT NO 2
 LAS VEGAS NEVADA

30' CURB
 CONSTRUCT BLOCK WALL ON R
 SIDE FOR THE 20' TO BE
 AVOIDED MAX. 40' 50% OPTIM

166

E. SAHARA BOULEVARD

| | | |
|---|--------------|------------------|
| MAP TO ACCOMPANY APPLICATION OF D.H. BROCKLEY FOR ZONE CHANGE | | |
| SCALE: 1/8" = 1' 0" | APPROVED BY: | DRAWN BY J. & L. |
| DATE: DEC 1963 | | REVISED |
| 2413 SANTA CLARA DRIVE LAS VEGAS NEVADA. | | |
| | | DRAWING NUMBER |

