


NOTE: ALL BLOCKS 300' X 400'
 ALL LOTS 25' X 140'
 ALL STREETS 80' WIDE
 ALL ALLEYS 5' WIDE
 EXCEPT AS OTHERWISE INDICATED.

CLARK'S LAS VEGAS TOWNSITE
 SOUTH ADDITION
 UNION PACIFIC RR RIGHT OF WAY

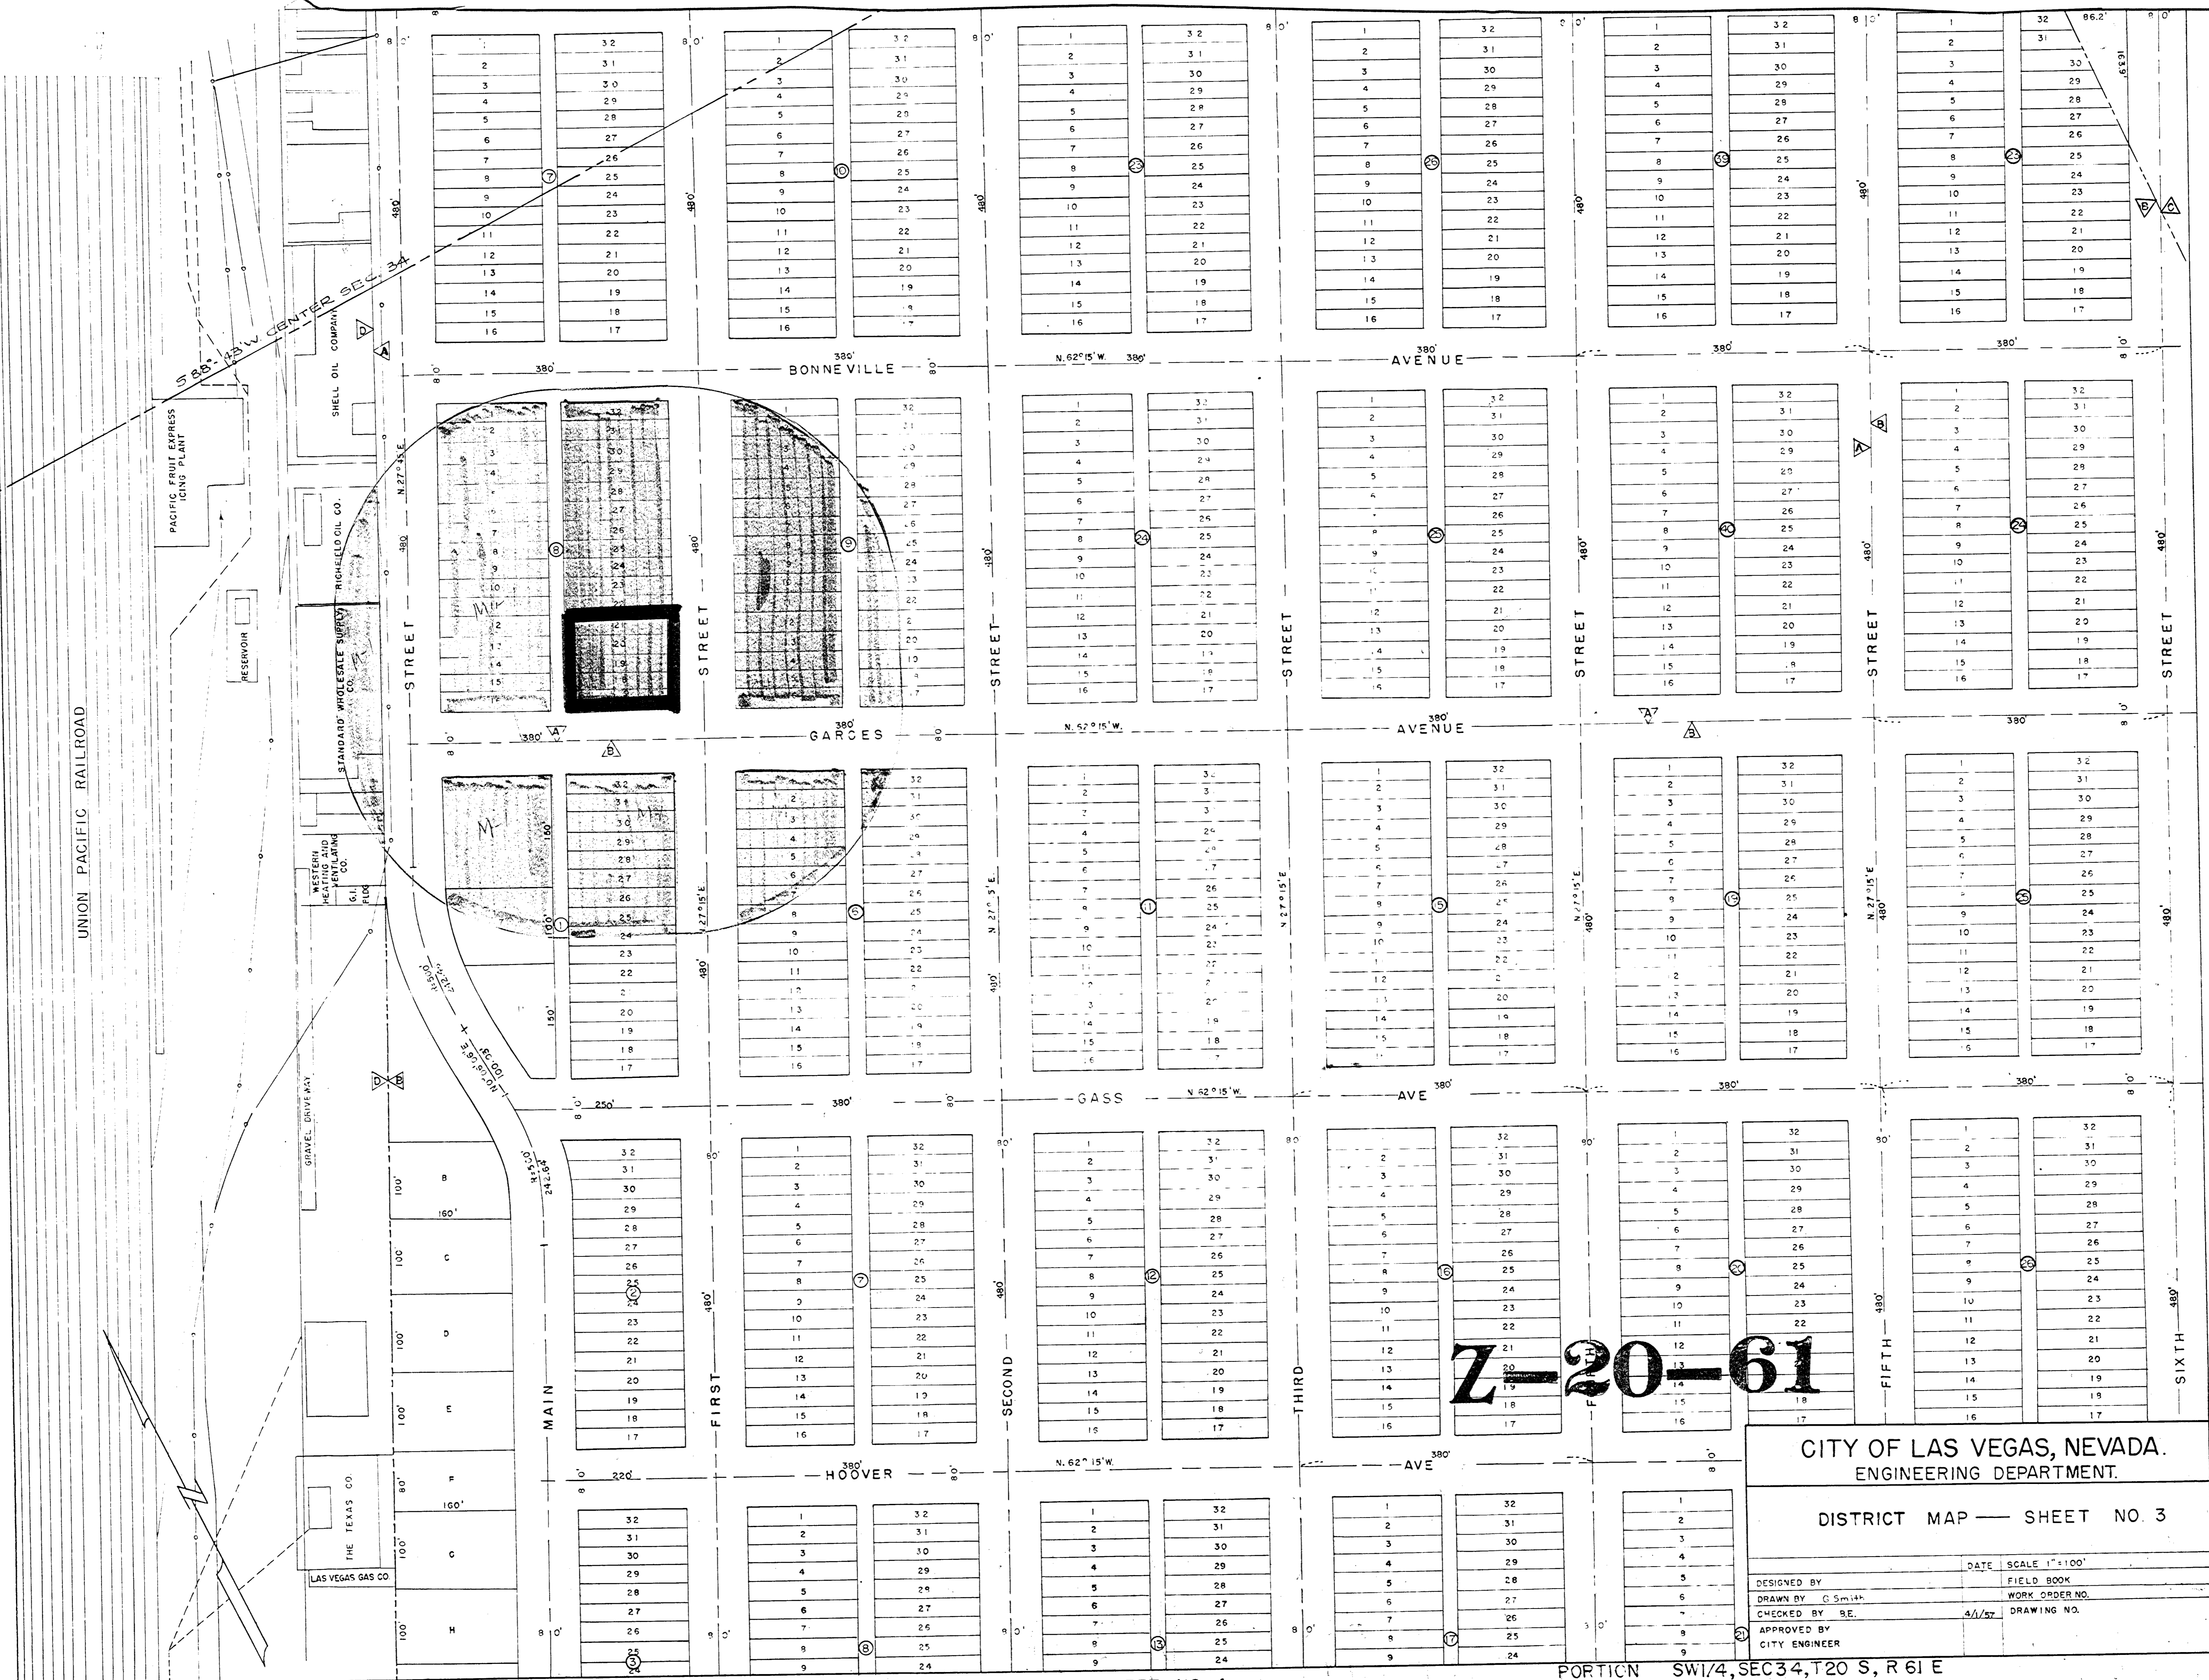

CITY OF LAS VEGAS, NEVADA.
 ENGINEERING DEPARTMENT.

DISTRICT MAP — SHEET NO. 3

DESIGNED BY	DATE	SCALE 1"=100'
DRAWN BY C Smith		FIELD BOOK
CHECKED BY B.E.	4/1/57	WORK ORDER NO.
APPROVED BY		DRAWING NO.
CITY ENGINEER		

PORTION SW1/4, SEC 34, T20 S, R 61 E

Z-20

Z-20-61
 WEINER
 R-4 to M-1