


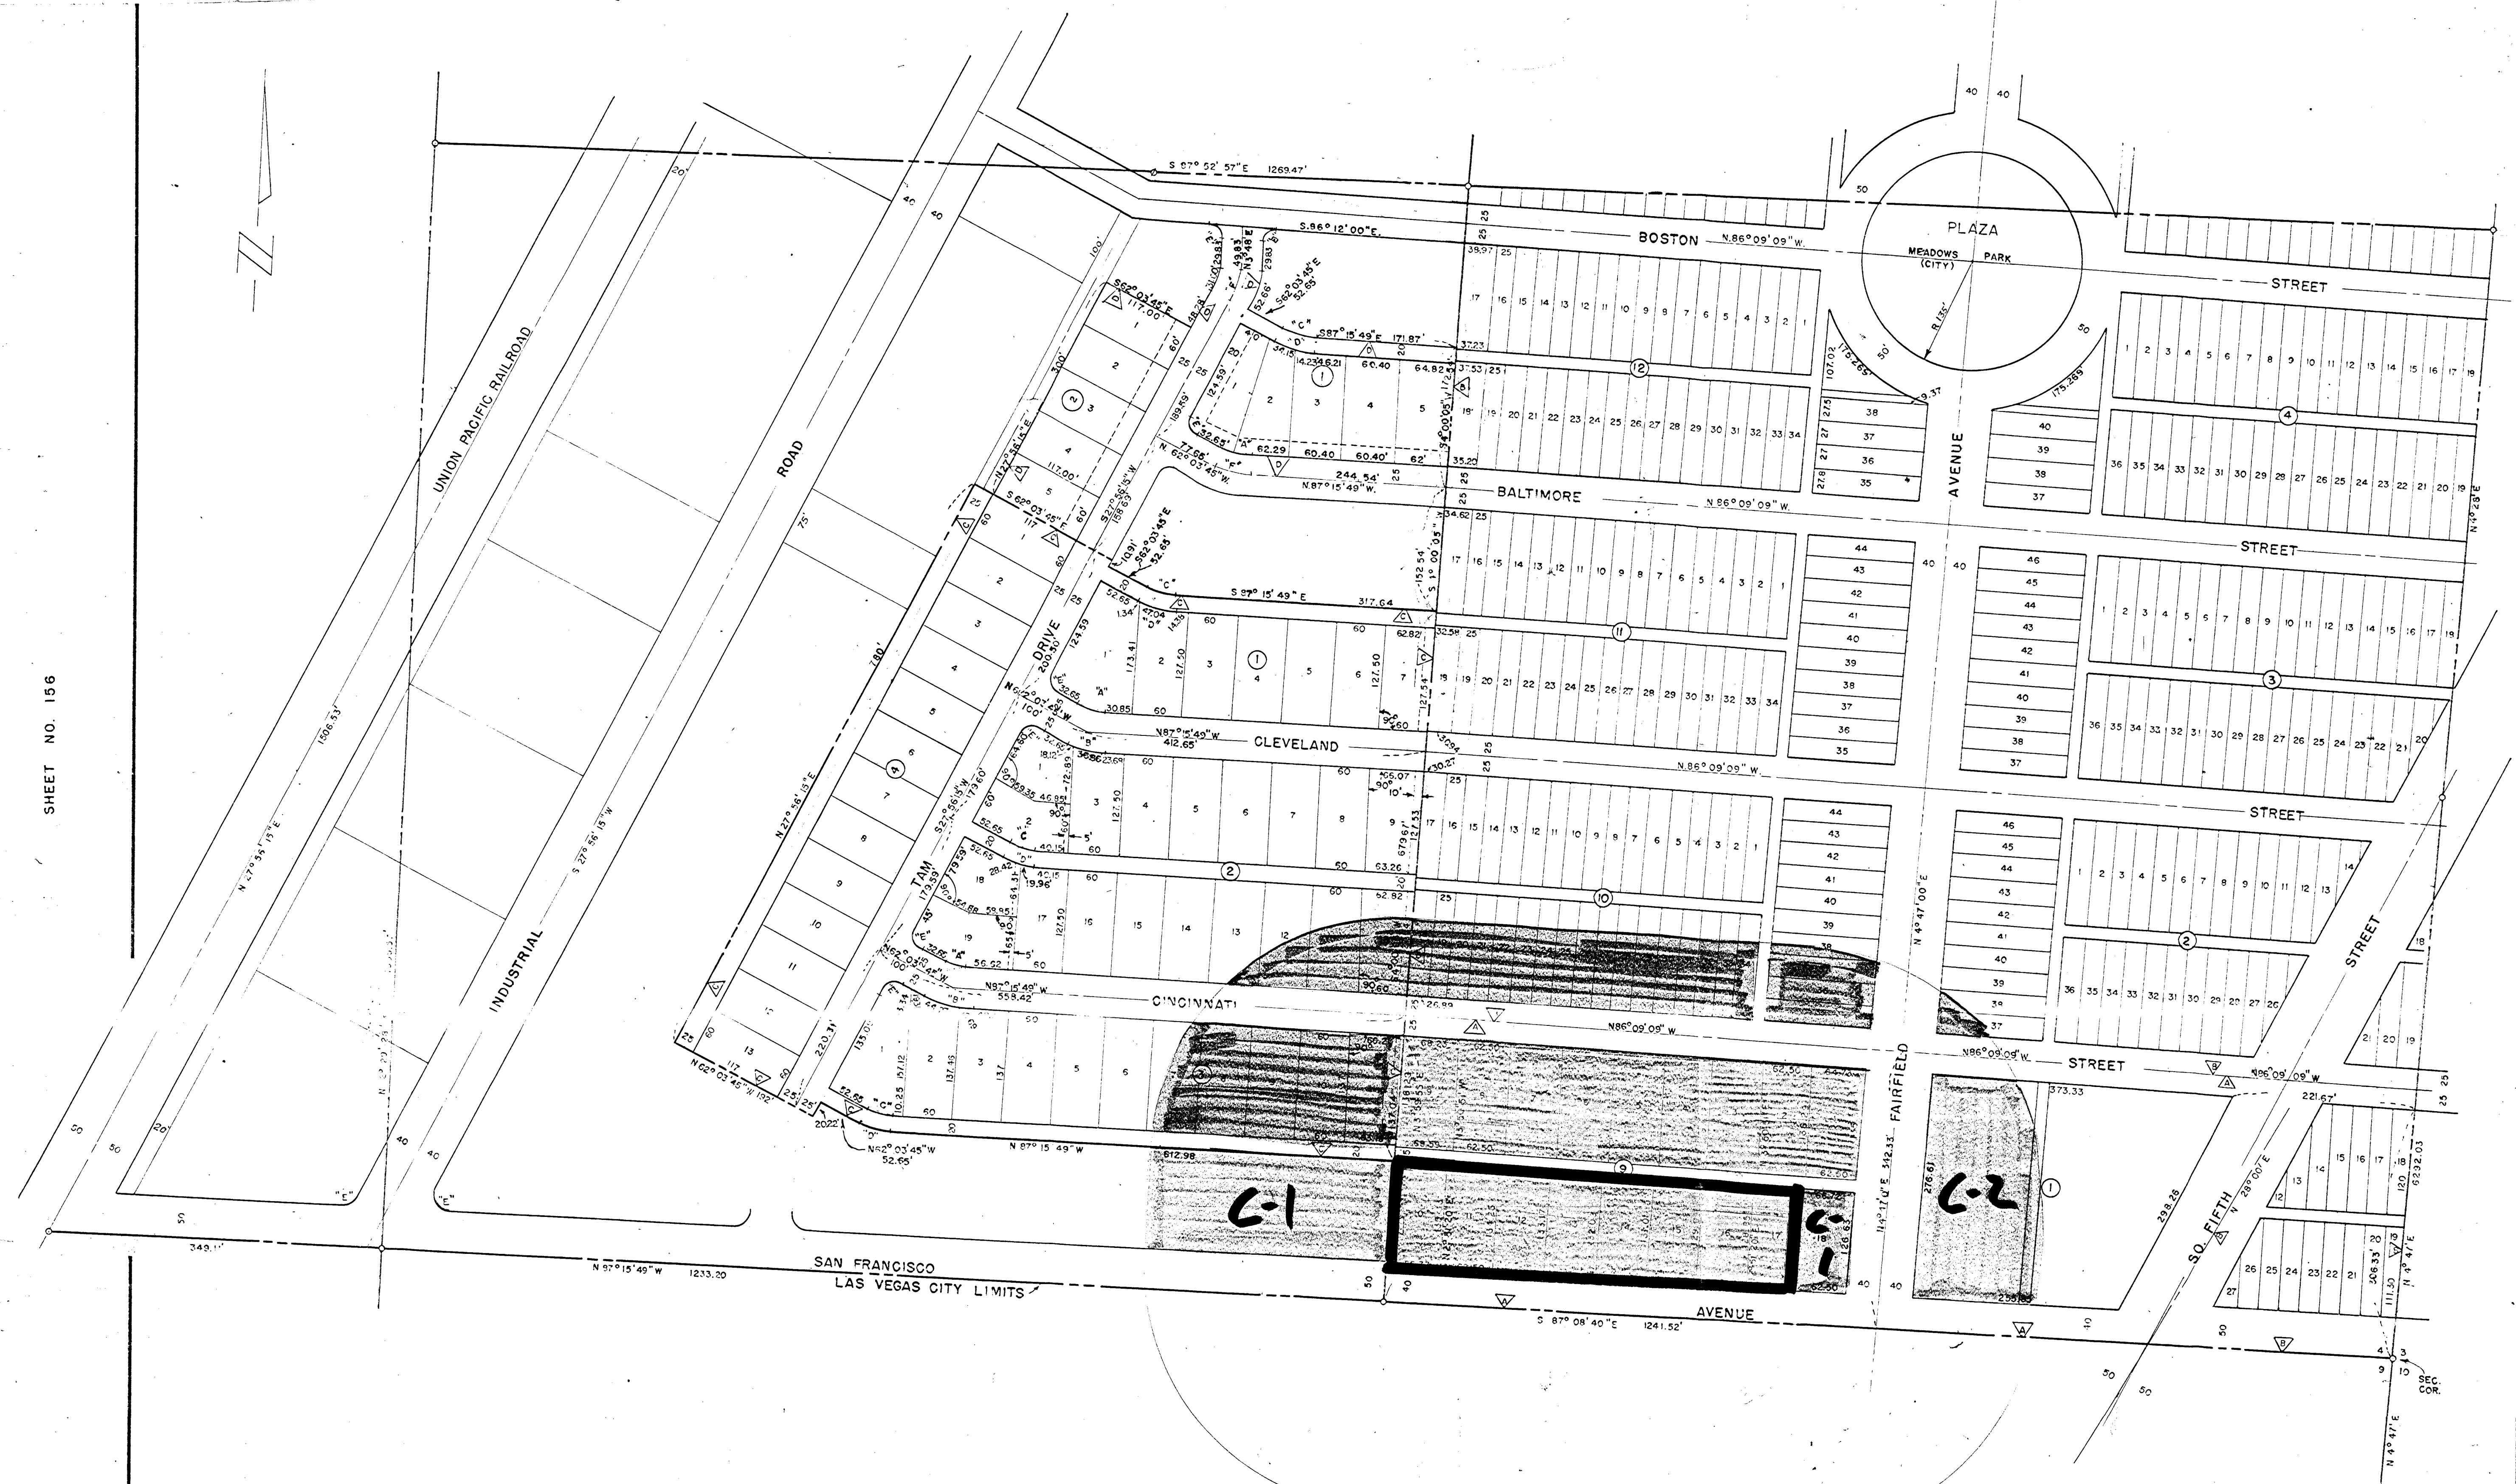

A = R 75' L: 32.988'
 B = R 125' L: 54.980'
 C = R 90' L: 39.596'
 D = R 110' L: 48.382'
 E = R 20' L: 15.708'
 F = R 100' L: 42.13'

MEADOWS-ADDITION (RE-SUB)
 MEADOWS ADDITION
 JUDY RICH TRACT
 JUDY RICH TRACT II

NOTE: ALL LOTS FACING
 FAIRFIELD 27.5 X 130.
 OTHERS 25 X 130.
 AVENUES 80' WIDE
 STREETS 50' WIDE
 ALLEYS 15' WIDE

Z-26-61

S1/2 SE1/4 SEC 4 T21S R61E

CITY OF LAS VEGAS NEVADA
ENGINEERING DEPT.

DISTRICT MAP — SHEET NO. 157

DESIGNED BY <i>L. Lewis</i>	DATE	SCALE 1"=100'
DRAWN BY <i>J. Mc MILLAN</i>	7-12-4	FIELD BOOK NO.
CHECKED BY		WORK ORDER NO.
APPROVED		DRAWING NO.
CITY ENGR.		

Z-26-61
Robinson
R-3 to C-1
7-13-61