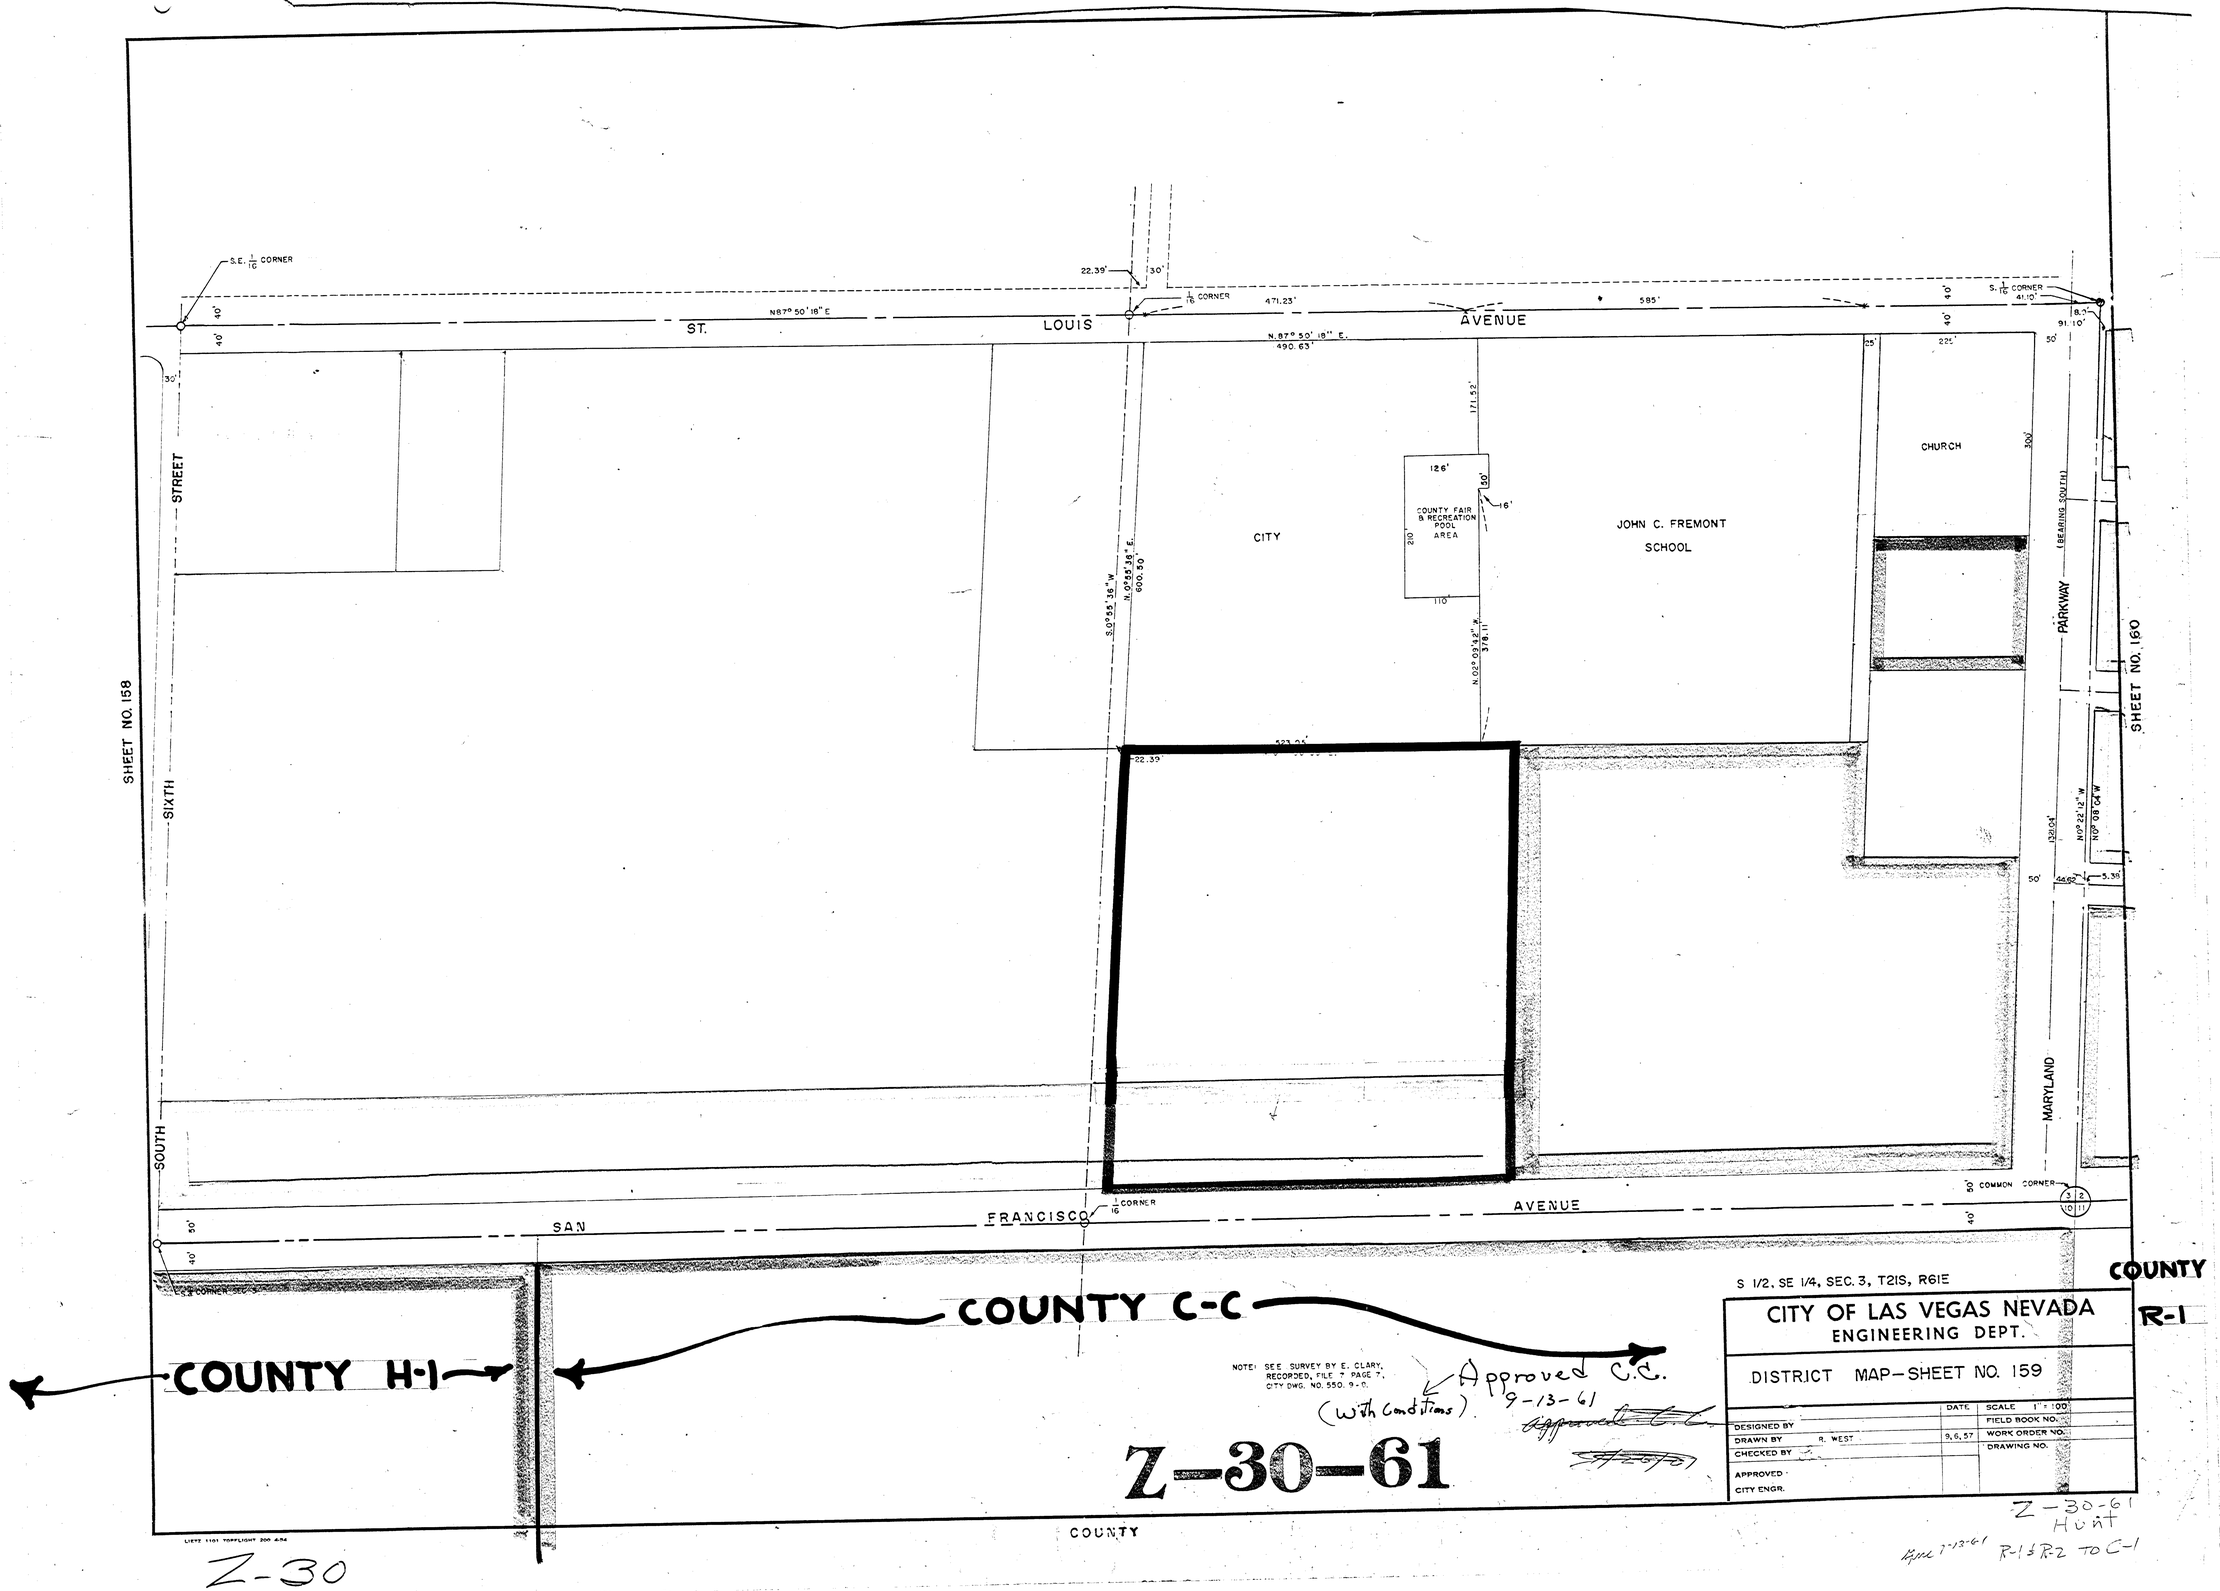
S.E. 1/16 CORNER
N87° 50' 18" E
ST.
LOUIS
AVENUE
22.39'
30'
1/16 CORNER
471.23'
595'
S. 1/16 CORNER
41.10'
91.10'
N.87° 50' 18" E.
490.63'
171.52'
126'
COUNTY FAIR & RECREATION POOL AREA
16'
CITY
JOHN C. FREMONT SCHOOL
CHURCH
225'
300'
PARKWAY
(BEARING SOUTH)
S.0°55' 38" W
N.0°55' 38" E.
600.50'
N.02° 09' 42" W.
378.11'
523.25'
132.04'
N.0° 22' 12" W
N.0° 08' 00" W
44.62'
5.38
MARYLAND
STREET
SIXTH
SOUTH
SHEET NO. 158
SHEET NO. 160
50' COMMON CORNER
1/16 CORNER
SAN
FRANCISCO
AVENUE
E.S. CORNER SEC. 3
COUNTY C-C
COUNTY H-1
COUNTY R-1
COUNTY
NOTE: SEE SURVEY BY E. CLARY, RECORDED, FILE 7 PAGE 7, CITY DWG. NO. 550. 9-0.
Approved C.C. 9-13-61 (with Conditions)
Z-30-61
S 1/2, SE 1/4, SEC. 3, T21S, R61E
CITY OF LAS VEGAS NEVADA
ENGINEERING DEPT.
DISTRICT MAP-SHEET NO. 159
DATE
SCALE 1" = 100'
DESIGNED BY
FIELD BOOK NO.
DRAWN BY R. WEST
9.6.57
WORK ORDER NO.
CHECKED BY
DRAWING NO.
APPROVED
CITY ENGR.
Z-30-61 Hunt
R-1 & R-2 TO C-1
Z-30