


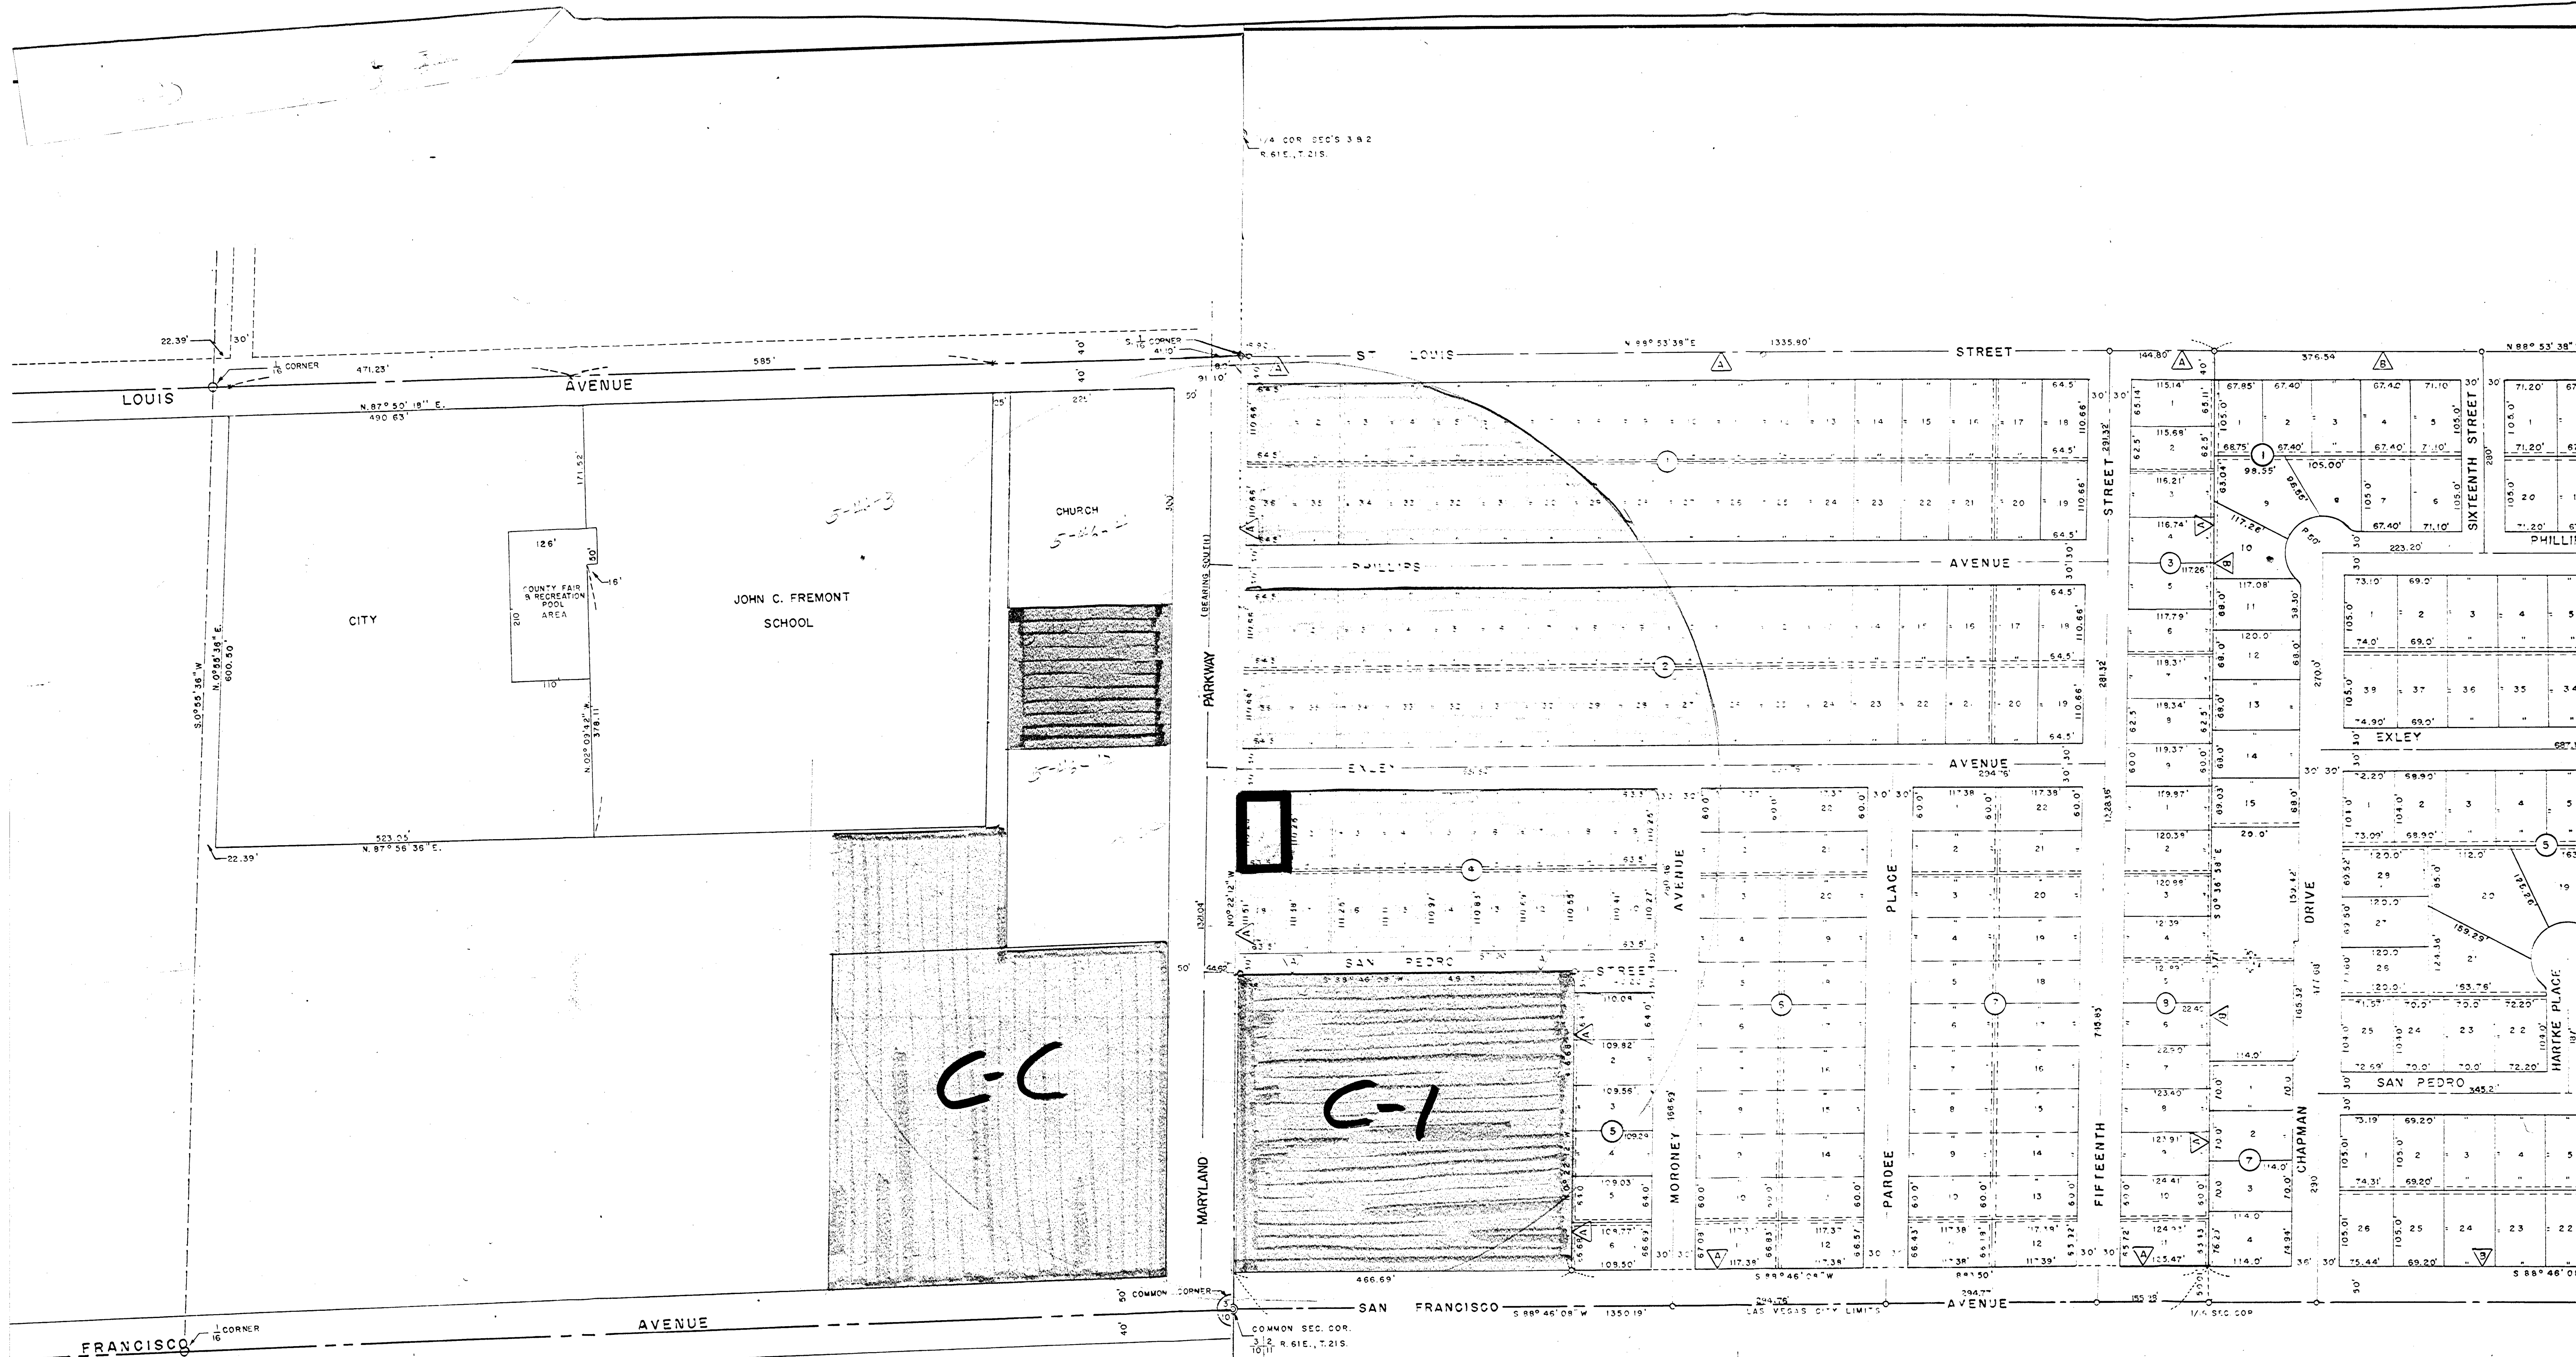

NOTE: SEE SURVEY BY E. CLARY,
RECORDED, FILE 7 PAGE 7,
CITY DWG. NO. 550, 9-0.

S 1/2, SE 1/4, SEC. 3, T21S, R61E

CITY OF LAS VEGAS NEVADA
ENGINEERING DEPT.

DISTRICT MAP-SHEET NO. 159

DESIGNED BY	DATE	SCALE	1" = 100'
DRAWN BY	9.6.57	FIELD BOOK NO.	
CHECKED BY		WORK ORDER NO.	
APPROVED		DRAWING NO.	
CITY ENGR.			

Z-31-61

DENIED - C.C.
7/24/01

Z-31-61
Provenzano
R-2 TO R-4

COUNTY

7-12-61