


R  
S  
T  
U  
V  
W  
X  
Y

SEC. 35

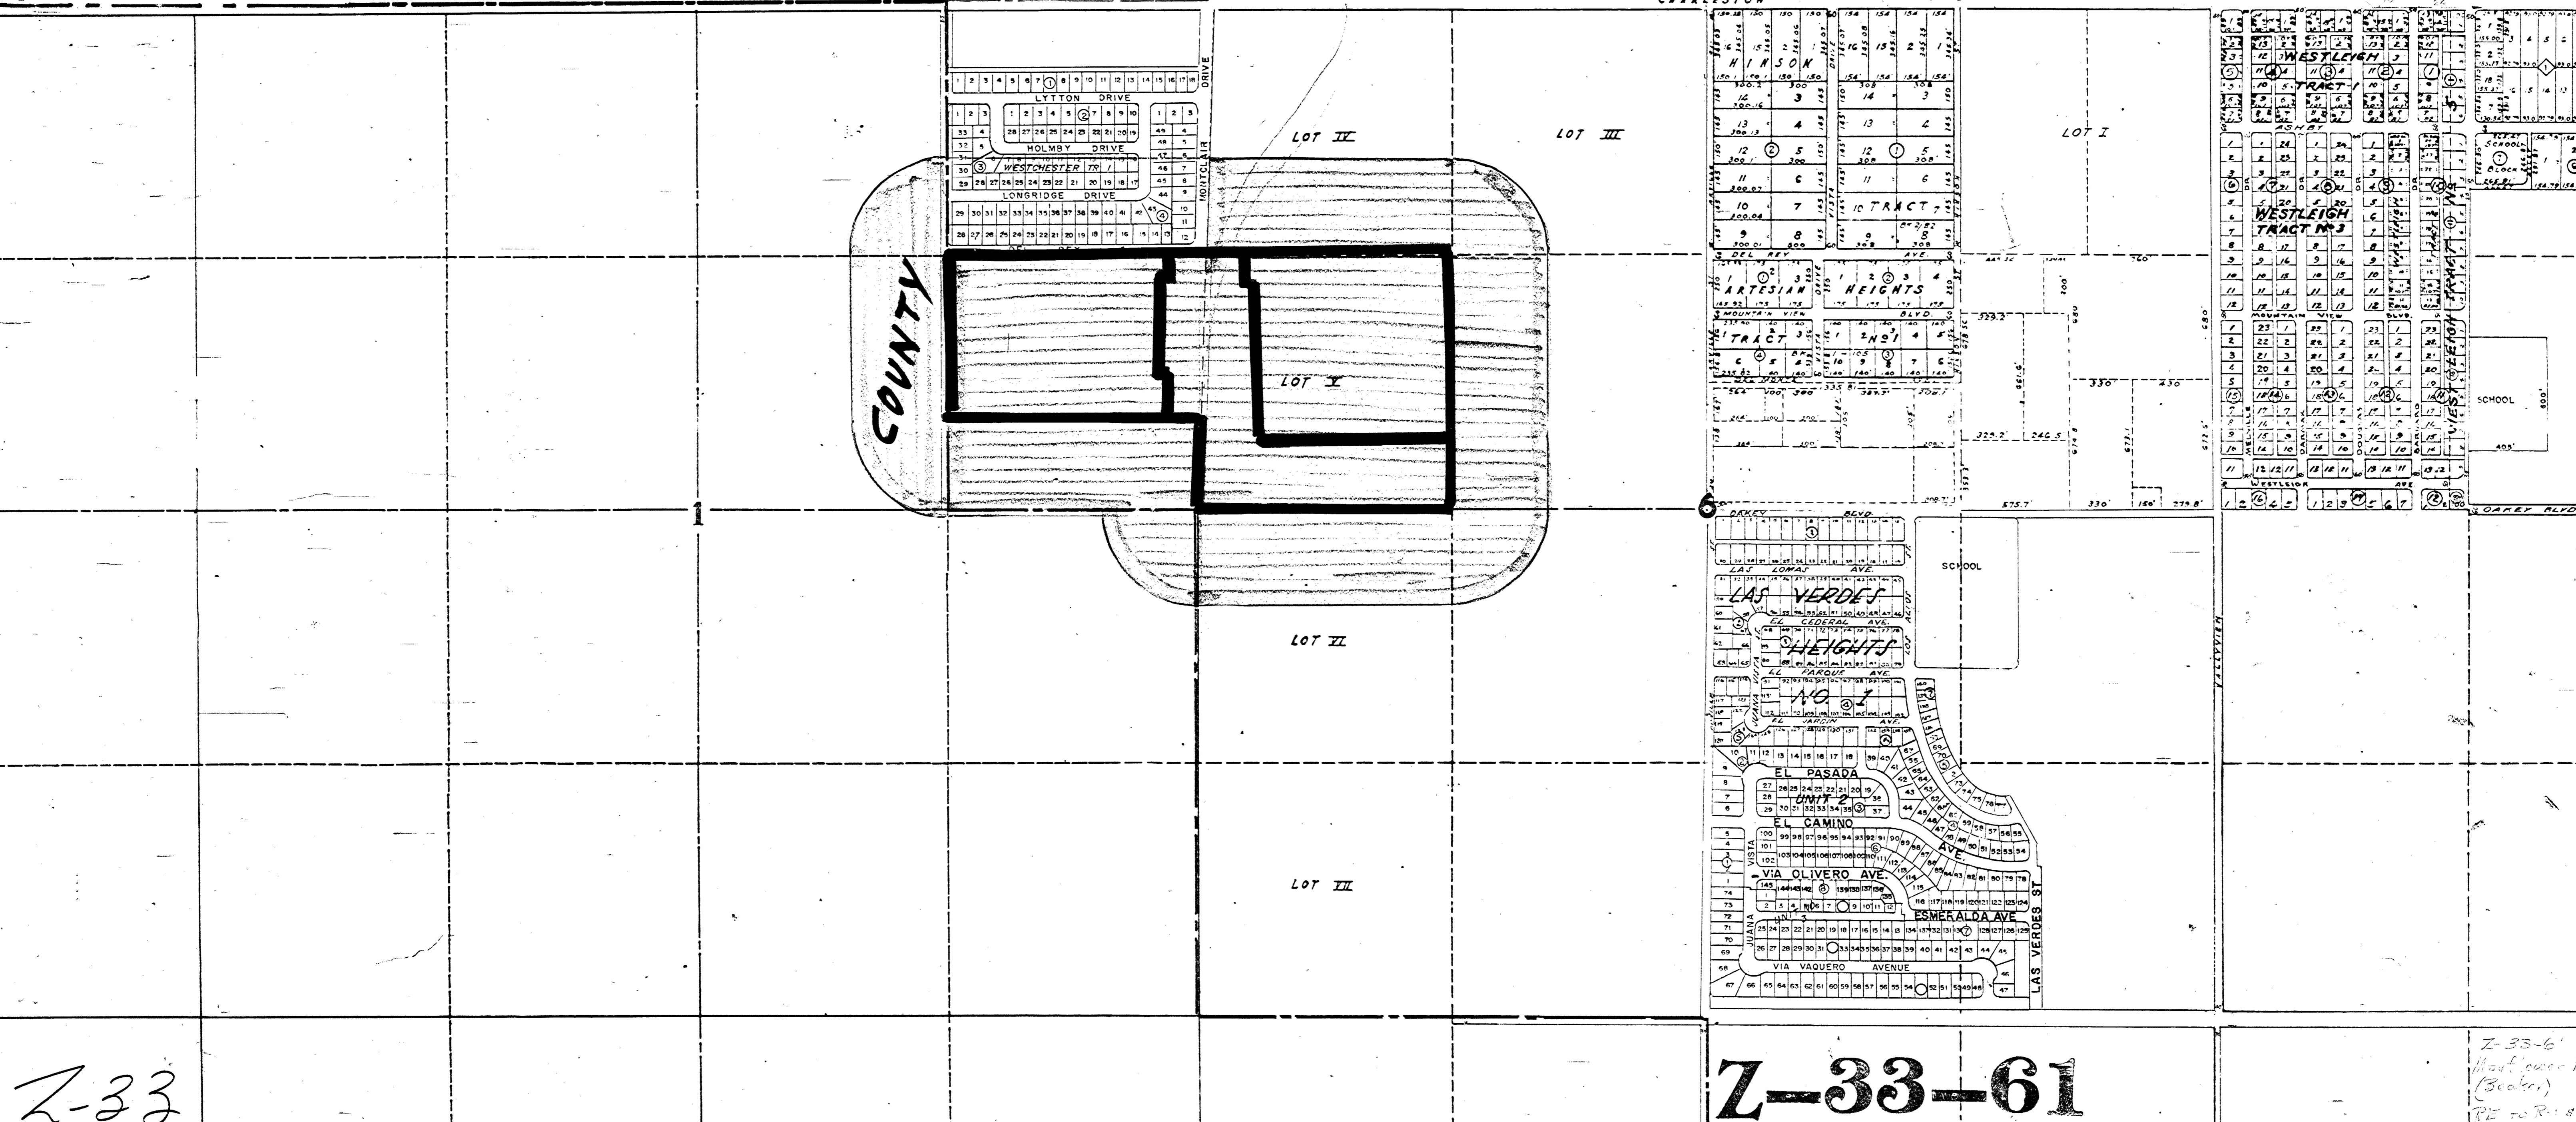

Z-33

Z-33-61

R. 60 E.

Jan 7-13-61 Approved C.C. 7/26/61

Z-33-61  
West corner East  
(Becker)  
RE to R-1 & R-2