


SHEET NO. 70

Z-35

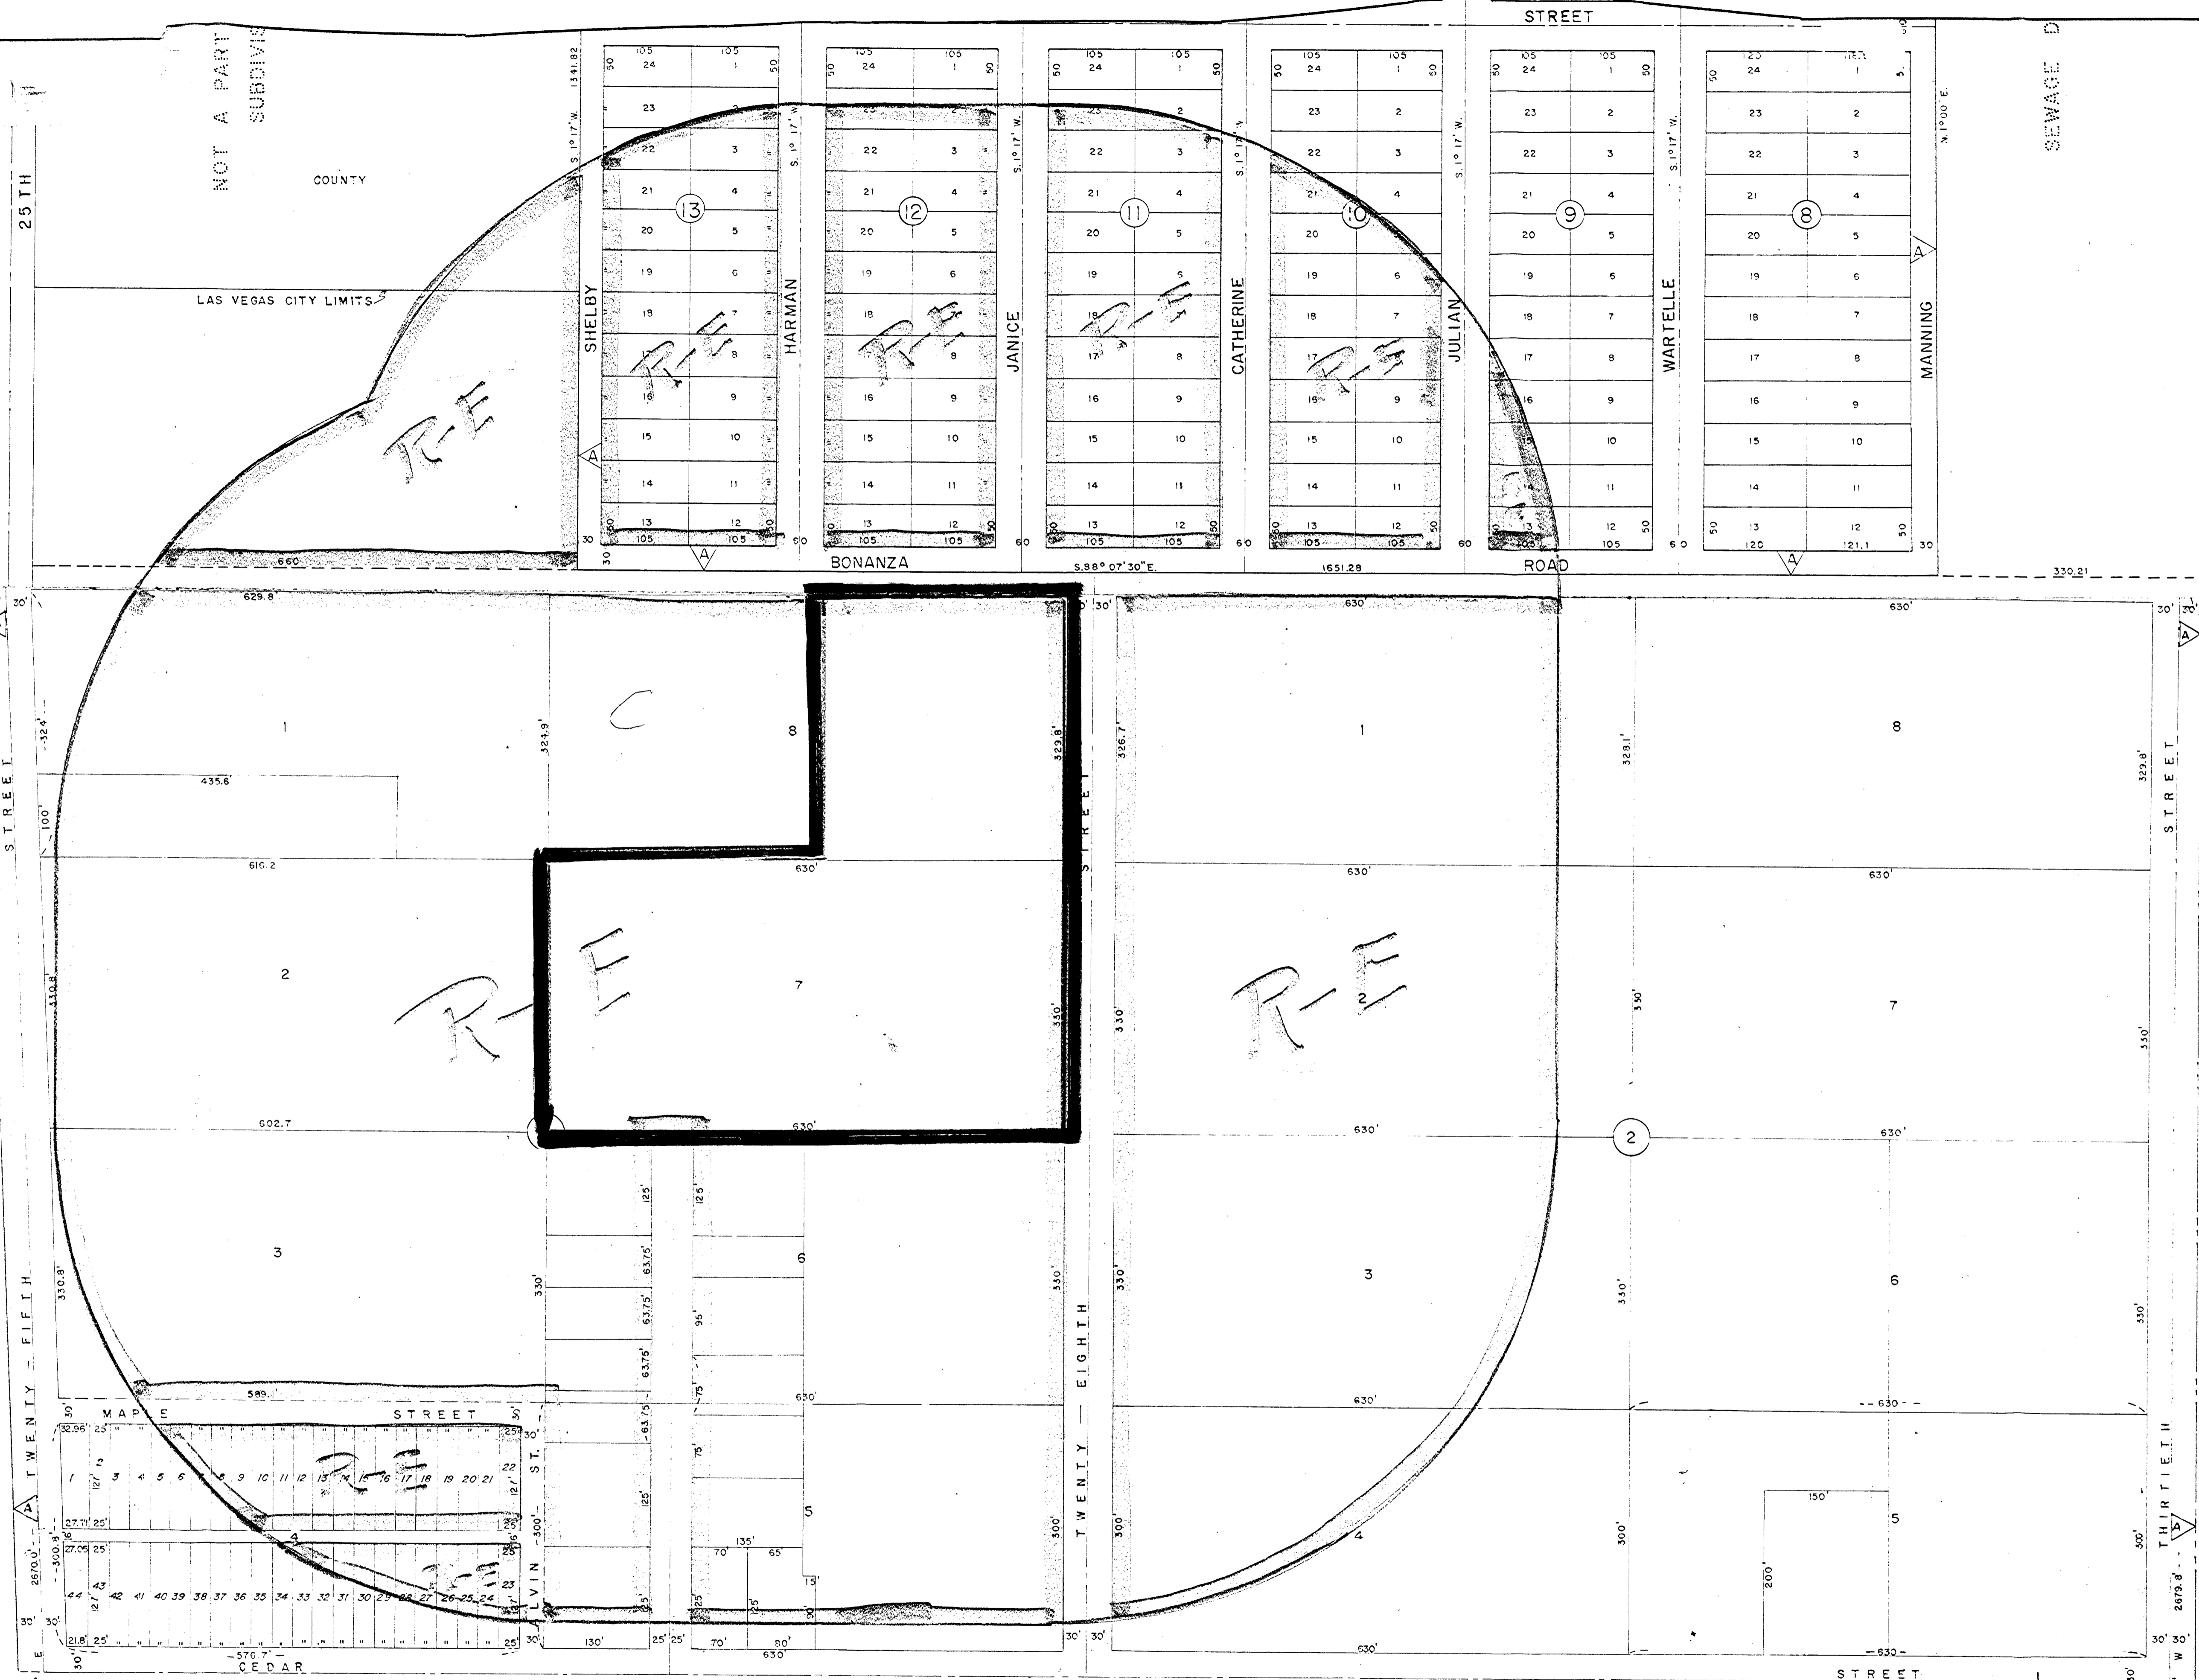

ARTESIAN ACRES

Z-35-61

Denied
C.C. 9-13-61

N 1/2 NW 1/4 SEC. 36 T20S, R61E

CITY OF LAS VEGAS NEVADA

SHEET NO. 72

Z-35-61
Gatewood
PE to R-2-T

APR 7-10-61