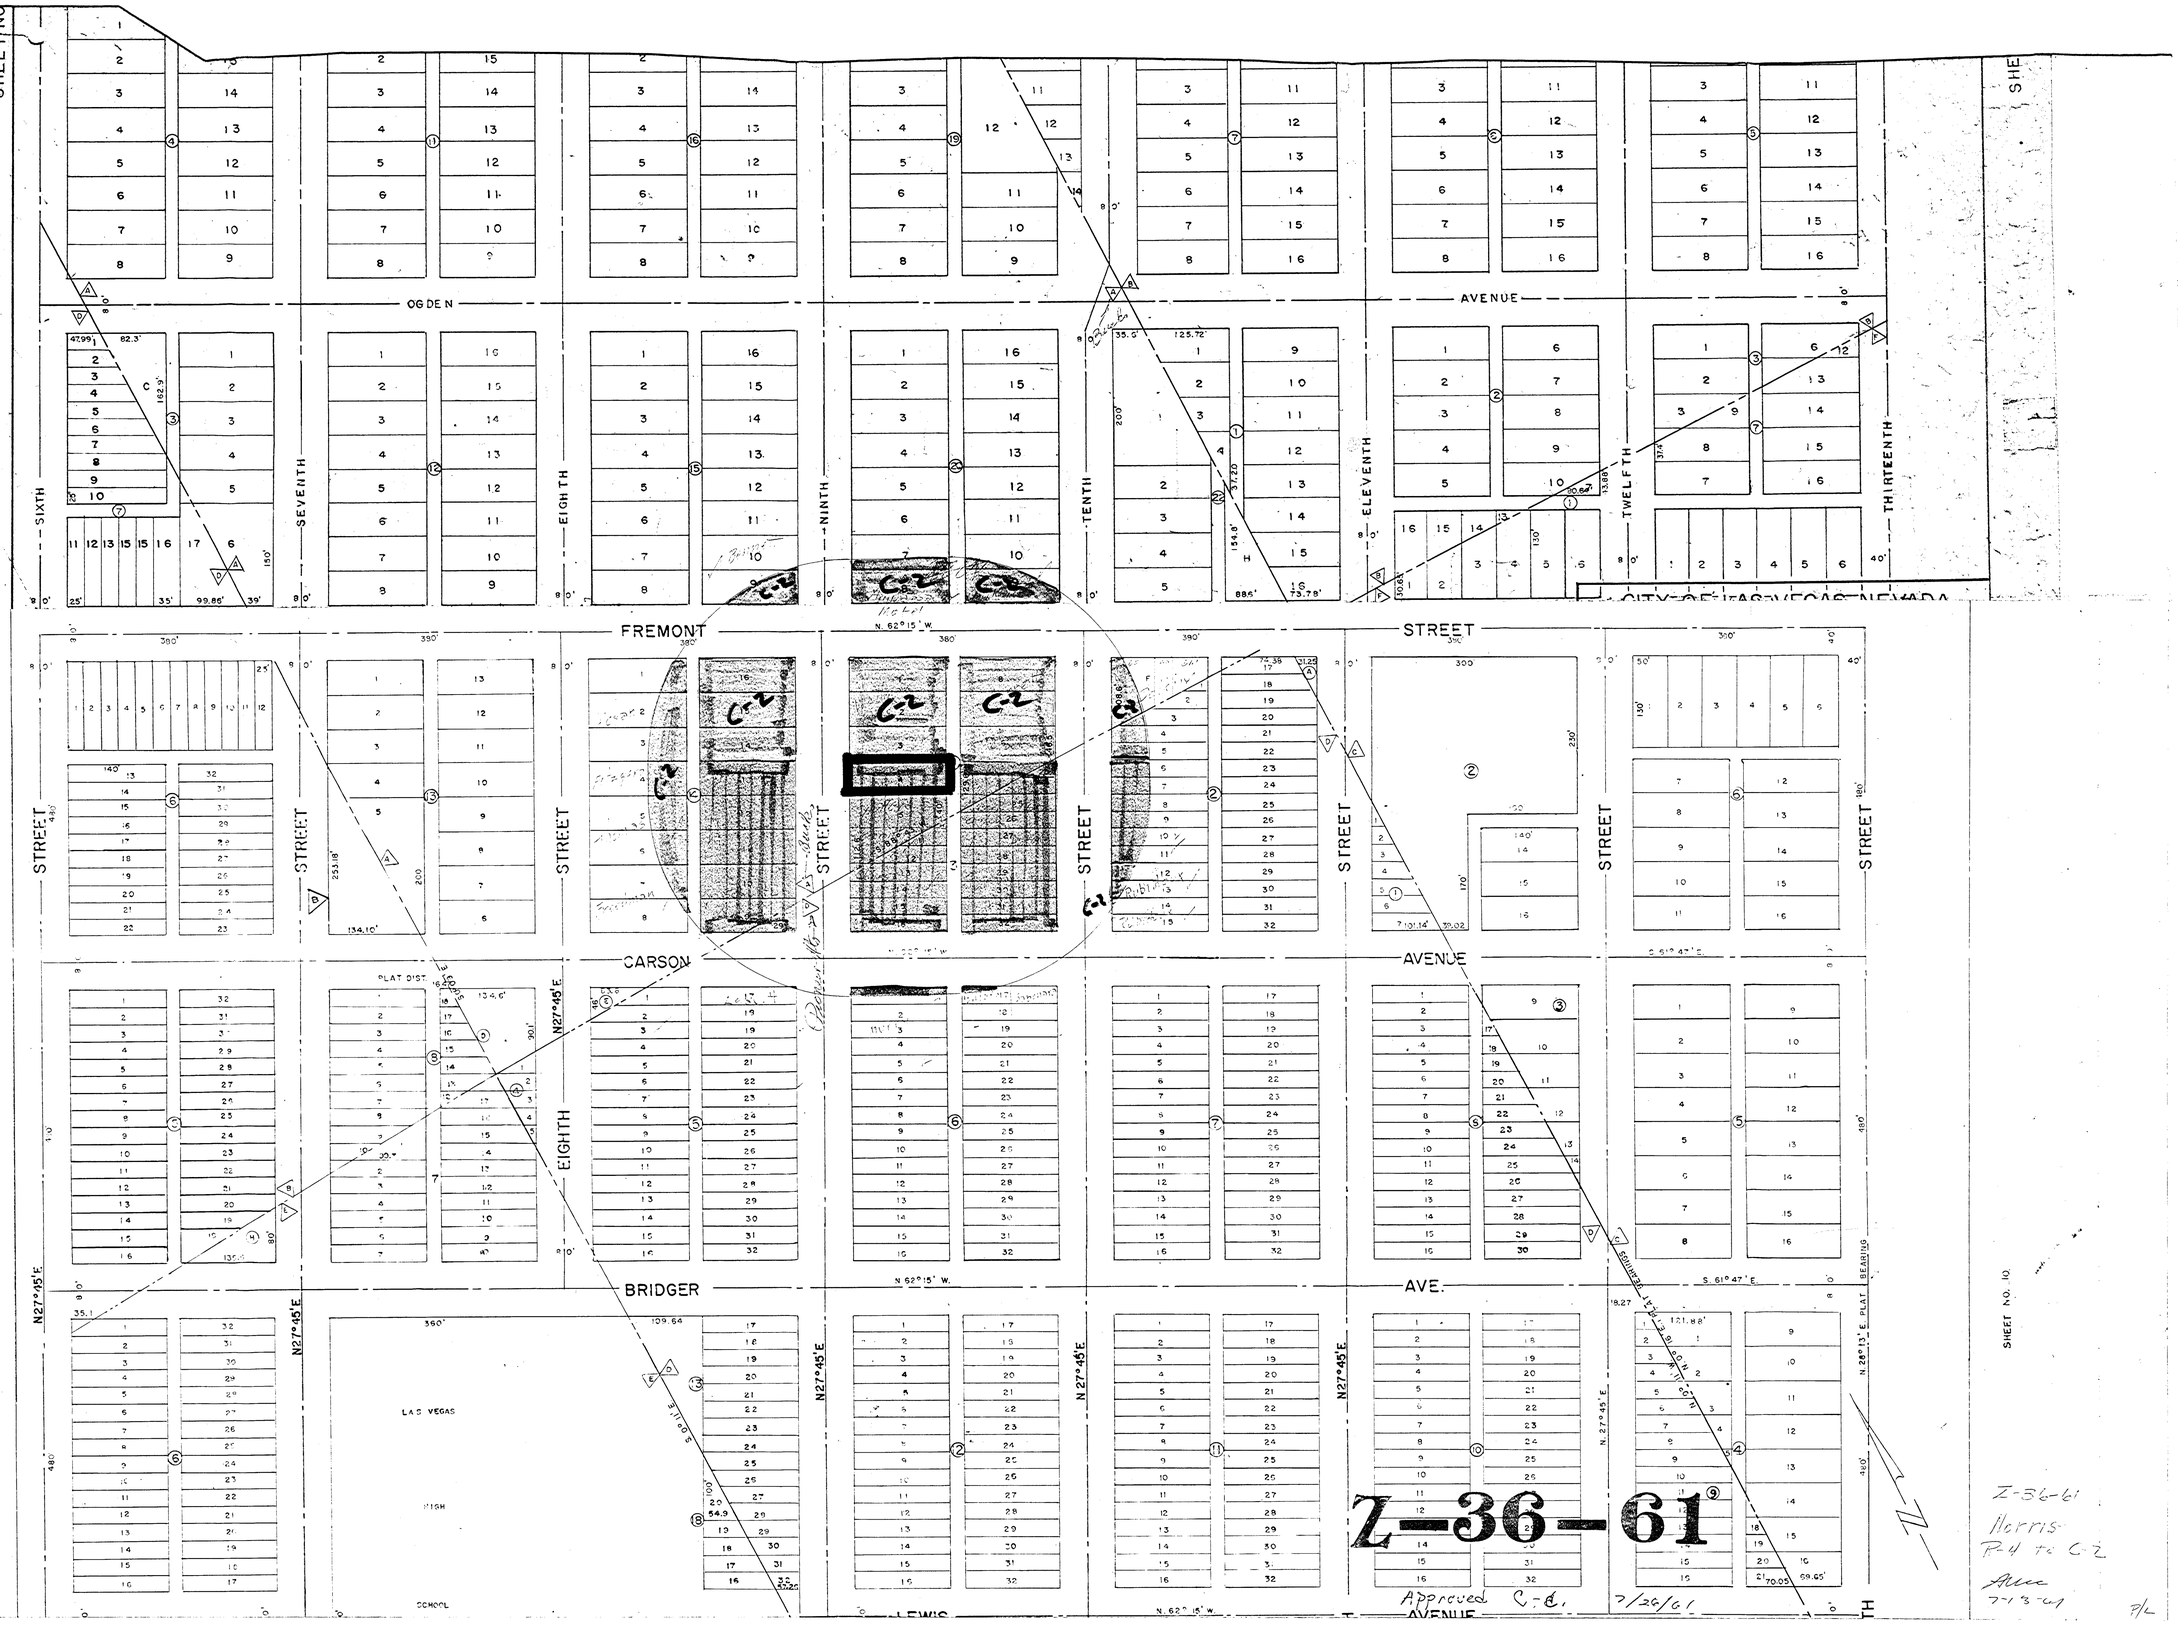
SHEET NO
SHEET NO. 10
SHEET NO 2.
OGDEN
AVENUE
SIXTH
SEVENTH
EIGHTH
NINTH
TENTH
ELEVENTH
TWELFTH
THIRTEENTH
CITY OF LAS VEGAS NEVADA
FREMONT
STREET
CARSON
BRIDGER
AVE.
LEWIS
N. 62°15' W.
S. 61°47' E.
N 27°45' E
N 27°45' E.
N 28°13' E. PLAT BEARING
LAS VEGAS
HIGH
SCHOOL
PLAT DIST.
Z-36-61
Approved C-2.
7/26/61
Z-36-61
Harris
Pd to C-2
Alice
7-13-69
Z-36