


SHEET NO. 113

SHEET NO. 115

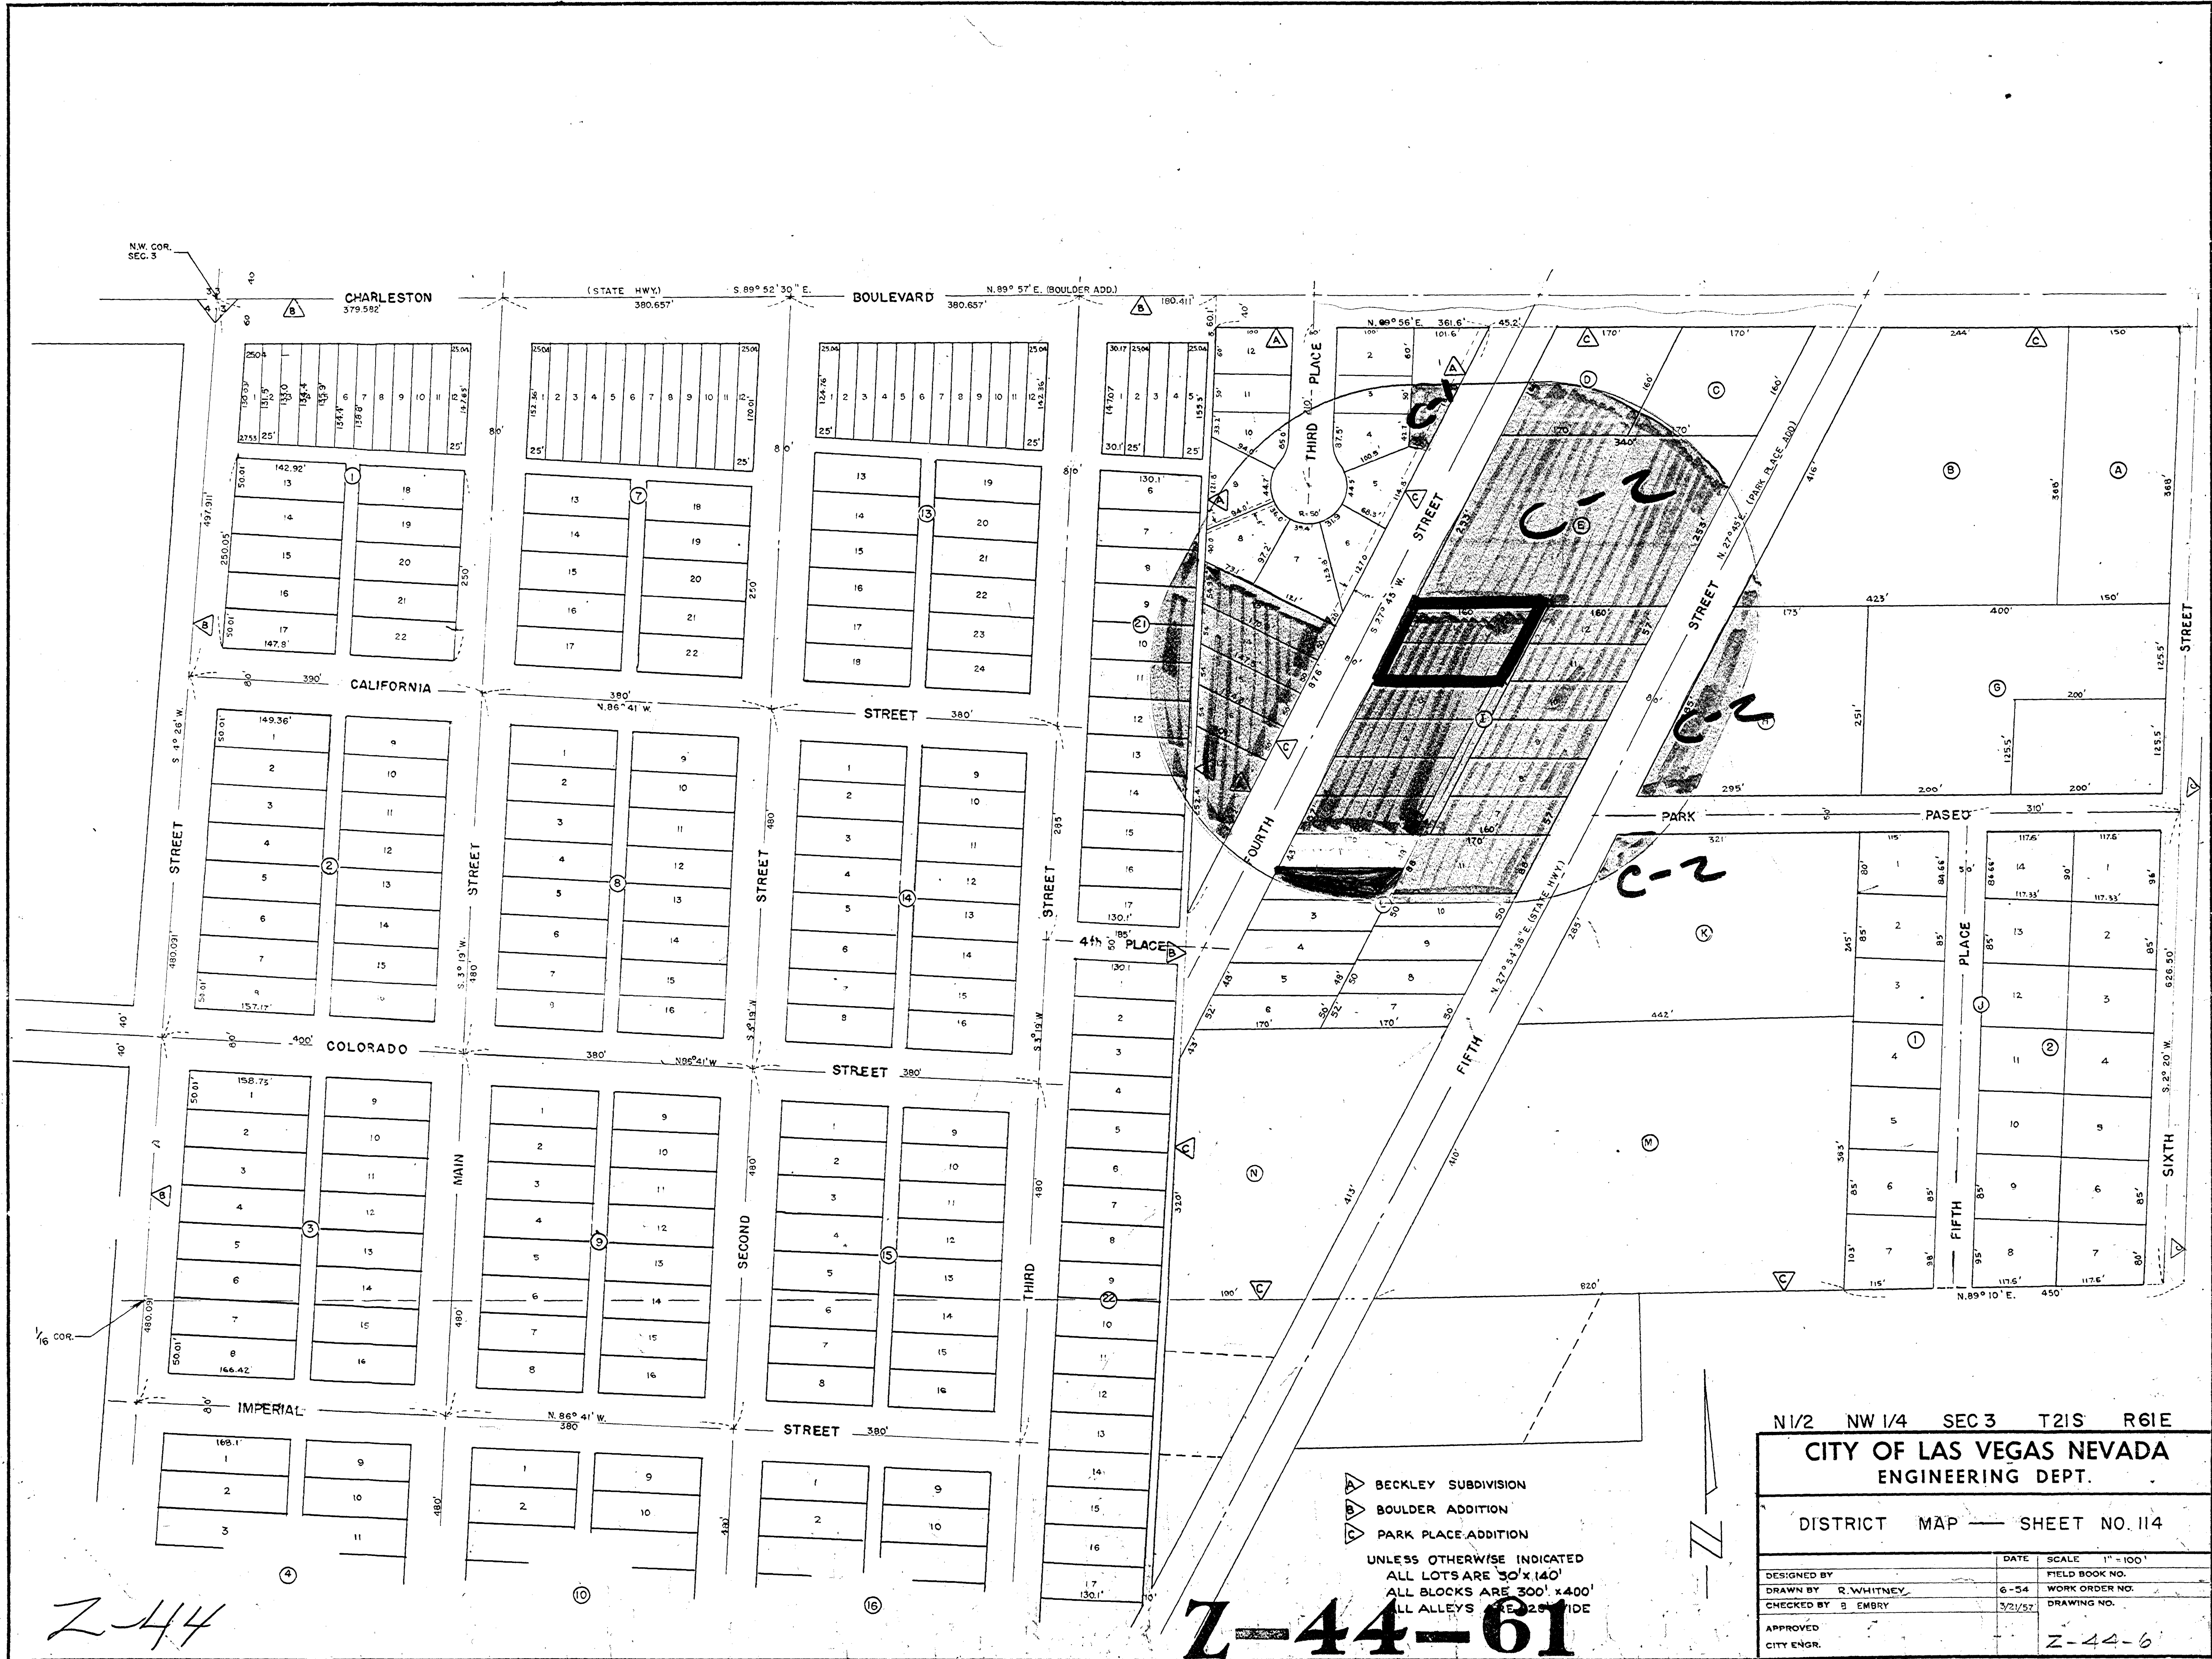

▲ BECKLEY SUBDIVISION  
 ▲ BOULDER ADDITION  
 ▲ PARK PLACE ADDITION  
 UNLESS OTHERWISE INDICATED  
 ALL LOTS ARE 30' x 140'  
 ALL BLOCKS ARE 300' x 400'  
 ALL ALLEYS ARE 20' WIDE

N1/2 NW 1/4 SEC 3 T21S R61E	
CITY OF LAS VEGAS NEVADA	
ENGINEERING DEPT.	
DISTRICT MAP - SHEET NO. 114	
DESIGNED BY	DATE
DRAWN BY R. WHITNEY	3/21/57
CHECKED BY B. EMBRY	
APPROVED	SCALE 1" = 100'
CITY ENGR.	FIELD BOOK NO.
	WORK ORDER NO.
	DRAWING NO.
	Z-44-61

Z-44

Z-44-61

SHEET NO. 130

Approved to C-1  
C.C. 9-27-61

E. Allen  
R-4 to C-2