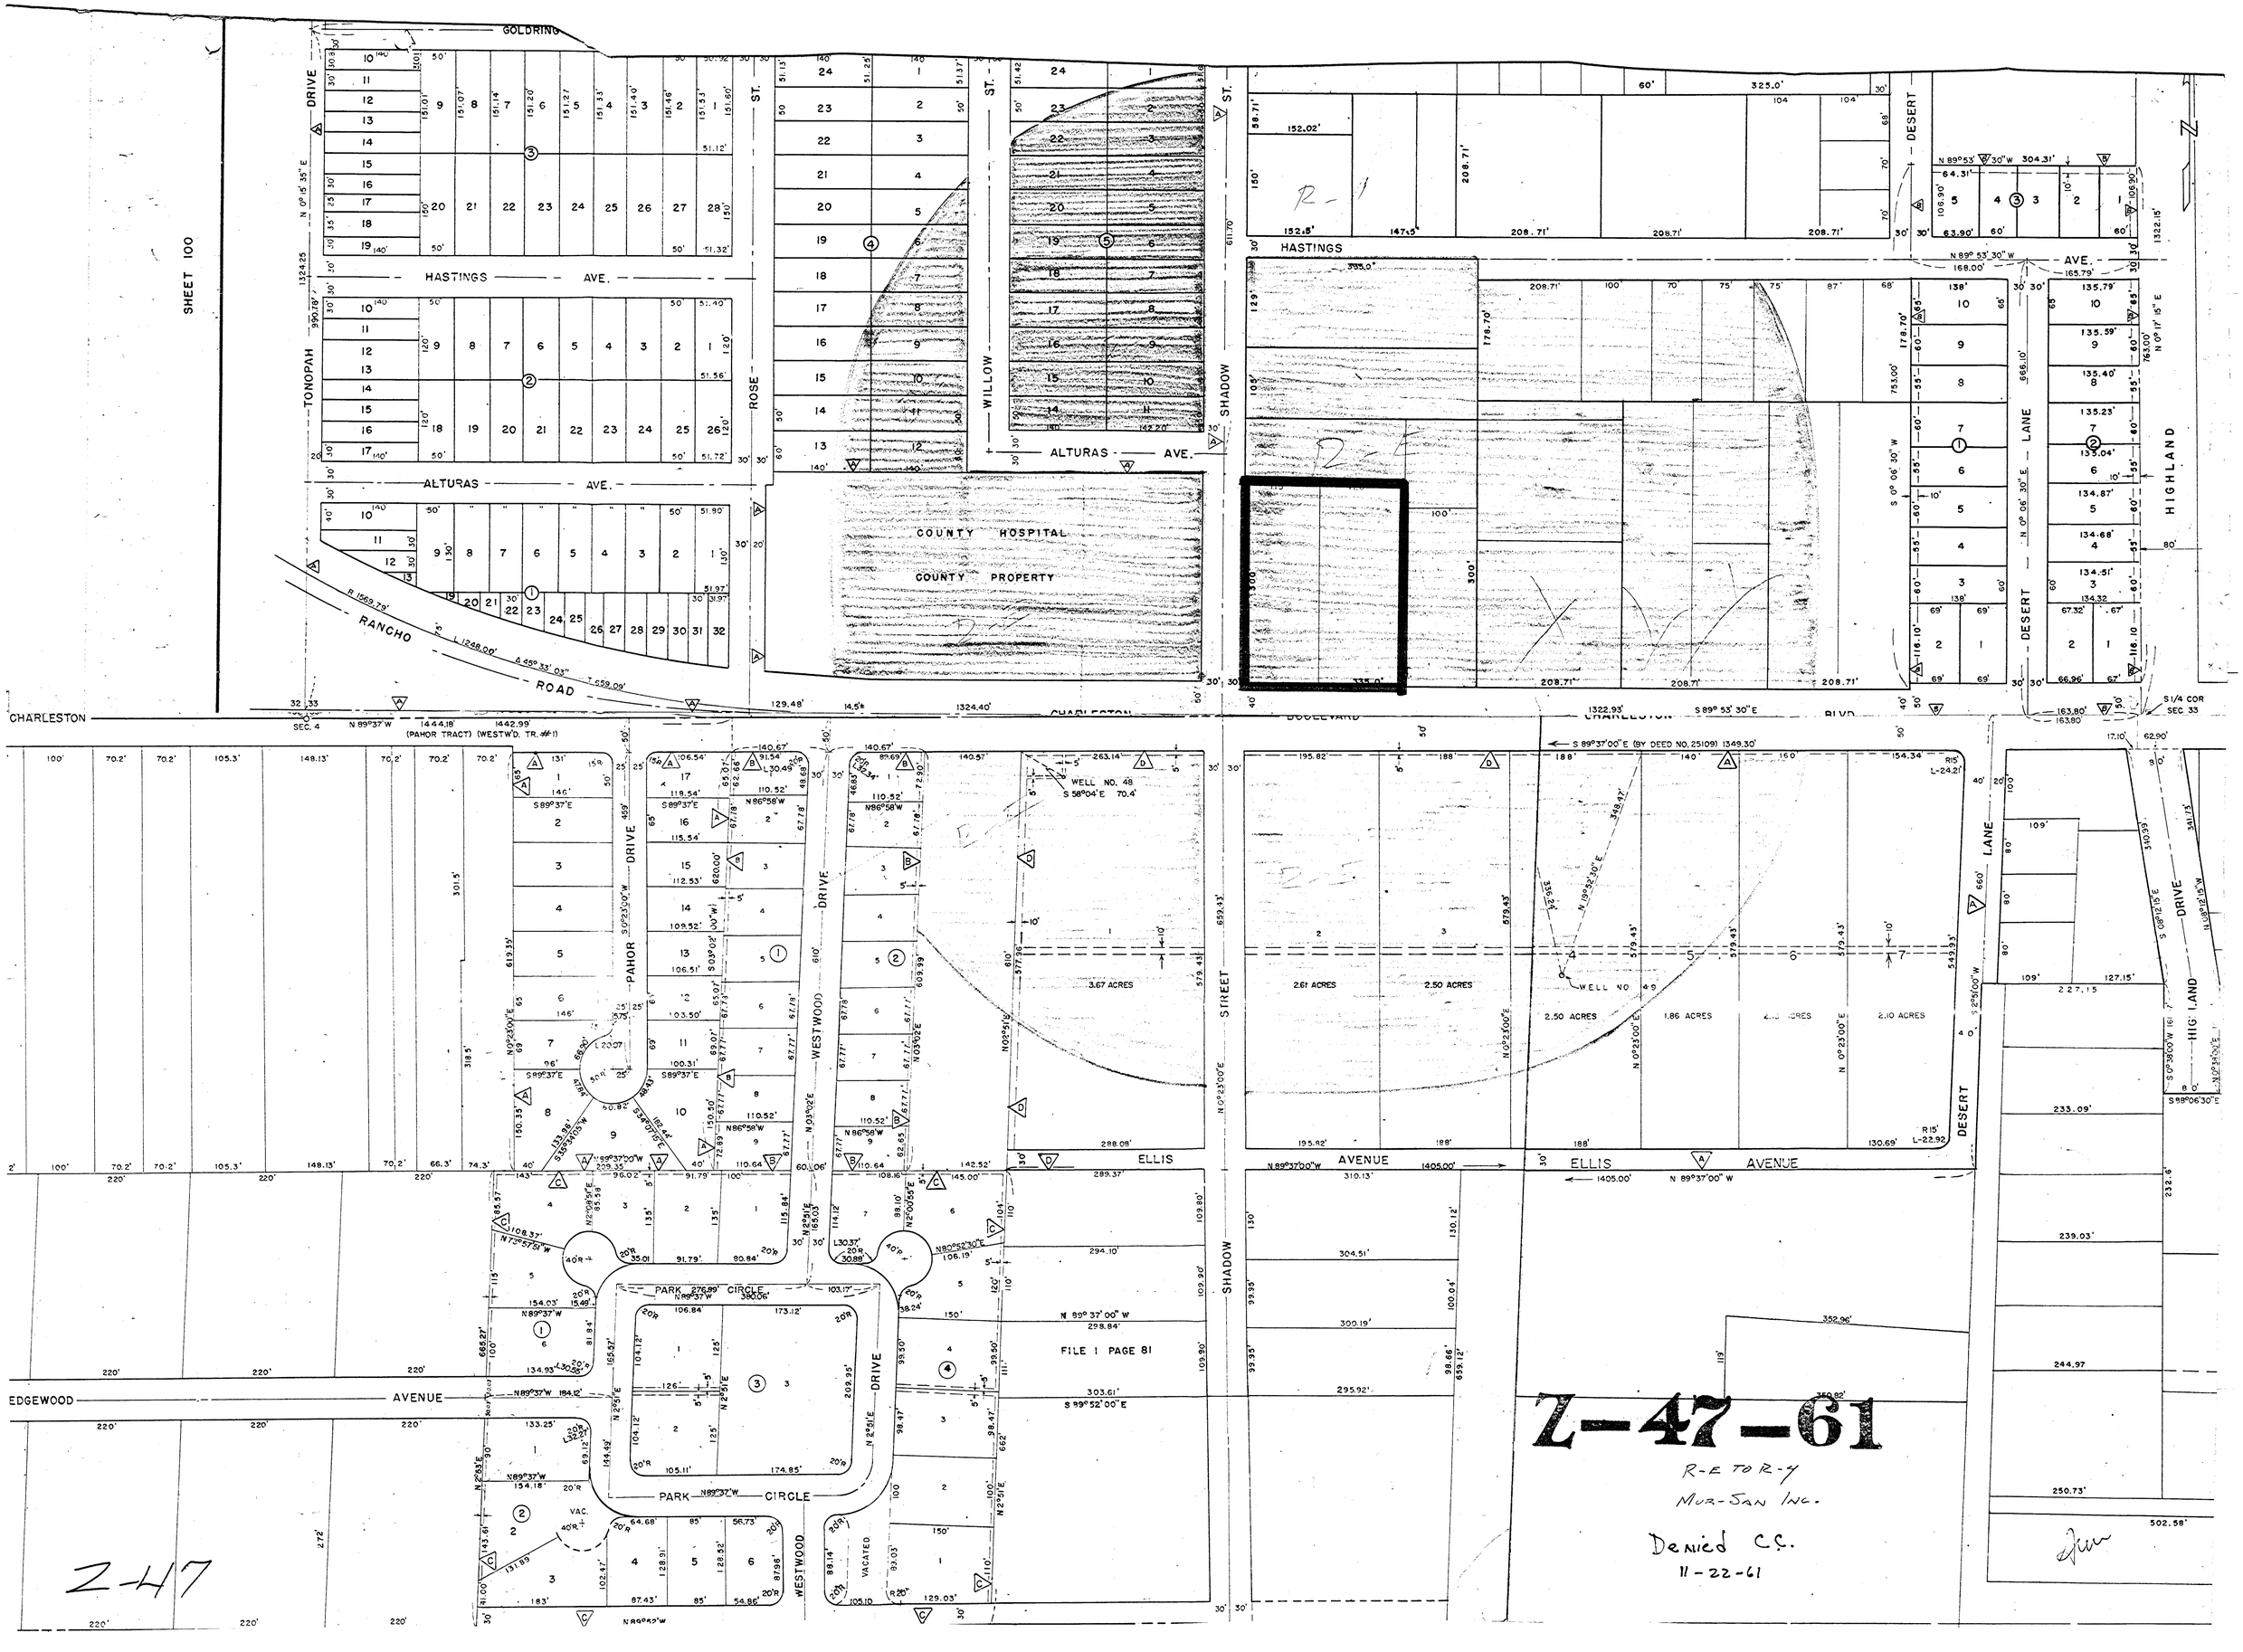
SHEET 100
GOLDRING
DRIVE
TONOPAH
HASTINGS AVE.
ALTURAS AVE.
ROSE ST.
WILLOW ST.
SHADOW ST.
DESERT LANE
HIGHLAND
COUNTY HOSPITAL
COUNTY PROPERTY
RANCHO ROAD
CHARLESTON BOULEVARD
S 89° 53' 30" E
S 1/4 COR SEC 33
SEC. 4
N 89°37' W
1444.18'
1442.99'
(PAHOR TRACT) (WESTW'D. TR. #1)
PAHOR DRIVE
WESTWOOD DRIVE
PARK CIRCLE
WELL NO. 48
S 58°04' E 70.4'
3.67 ACRES
ELLIS AVENUE
EDGEWOOD AVENUE
FILE 1 PAGE 81
S 89°37'00" E (BY DEED NO. 25109) 1349.30'
2.61 ACRES
2.50 ACRES
1.86 ACRES
2.10 ACRES
WELL NO 49
HIG. LAND DRIVE
R-1
R-4
Z-47
Z-47-61
R-E TO R-4
MUR-SAN INC.
Denied C.C.
11-22-61