


Proposed Development Of  

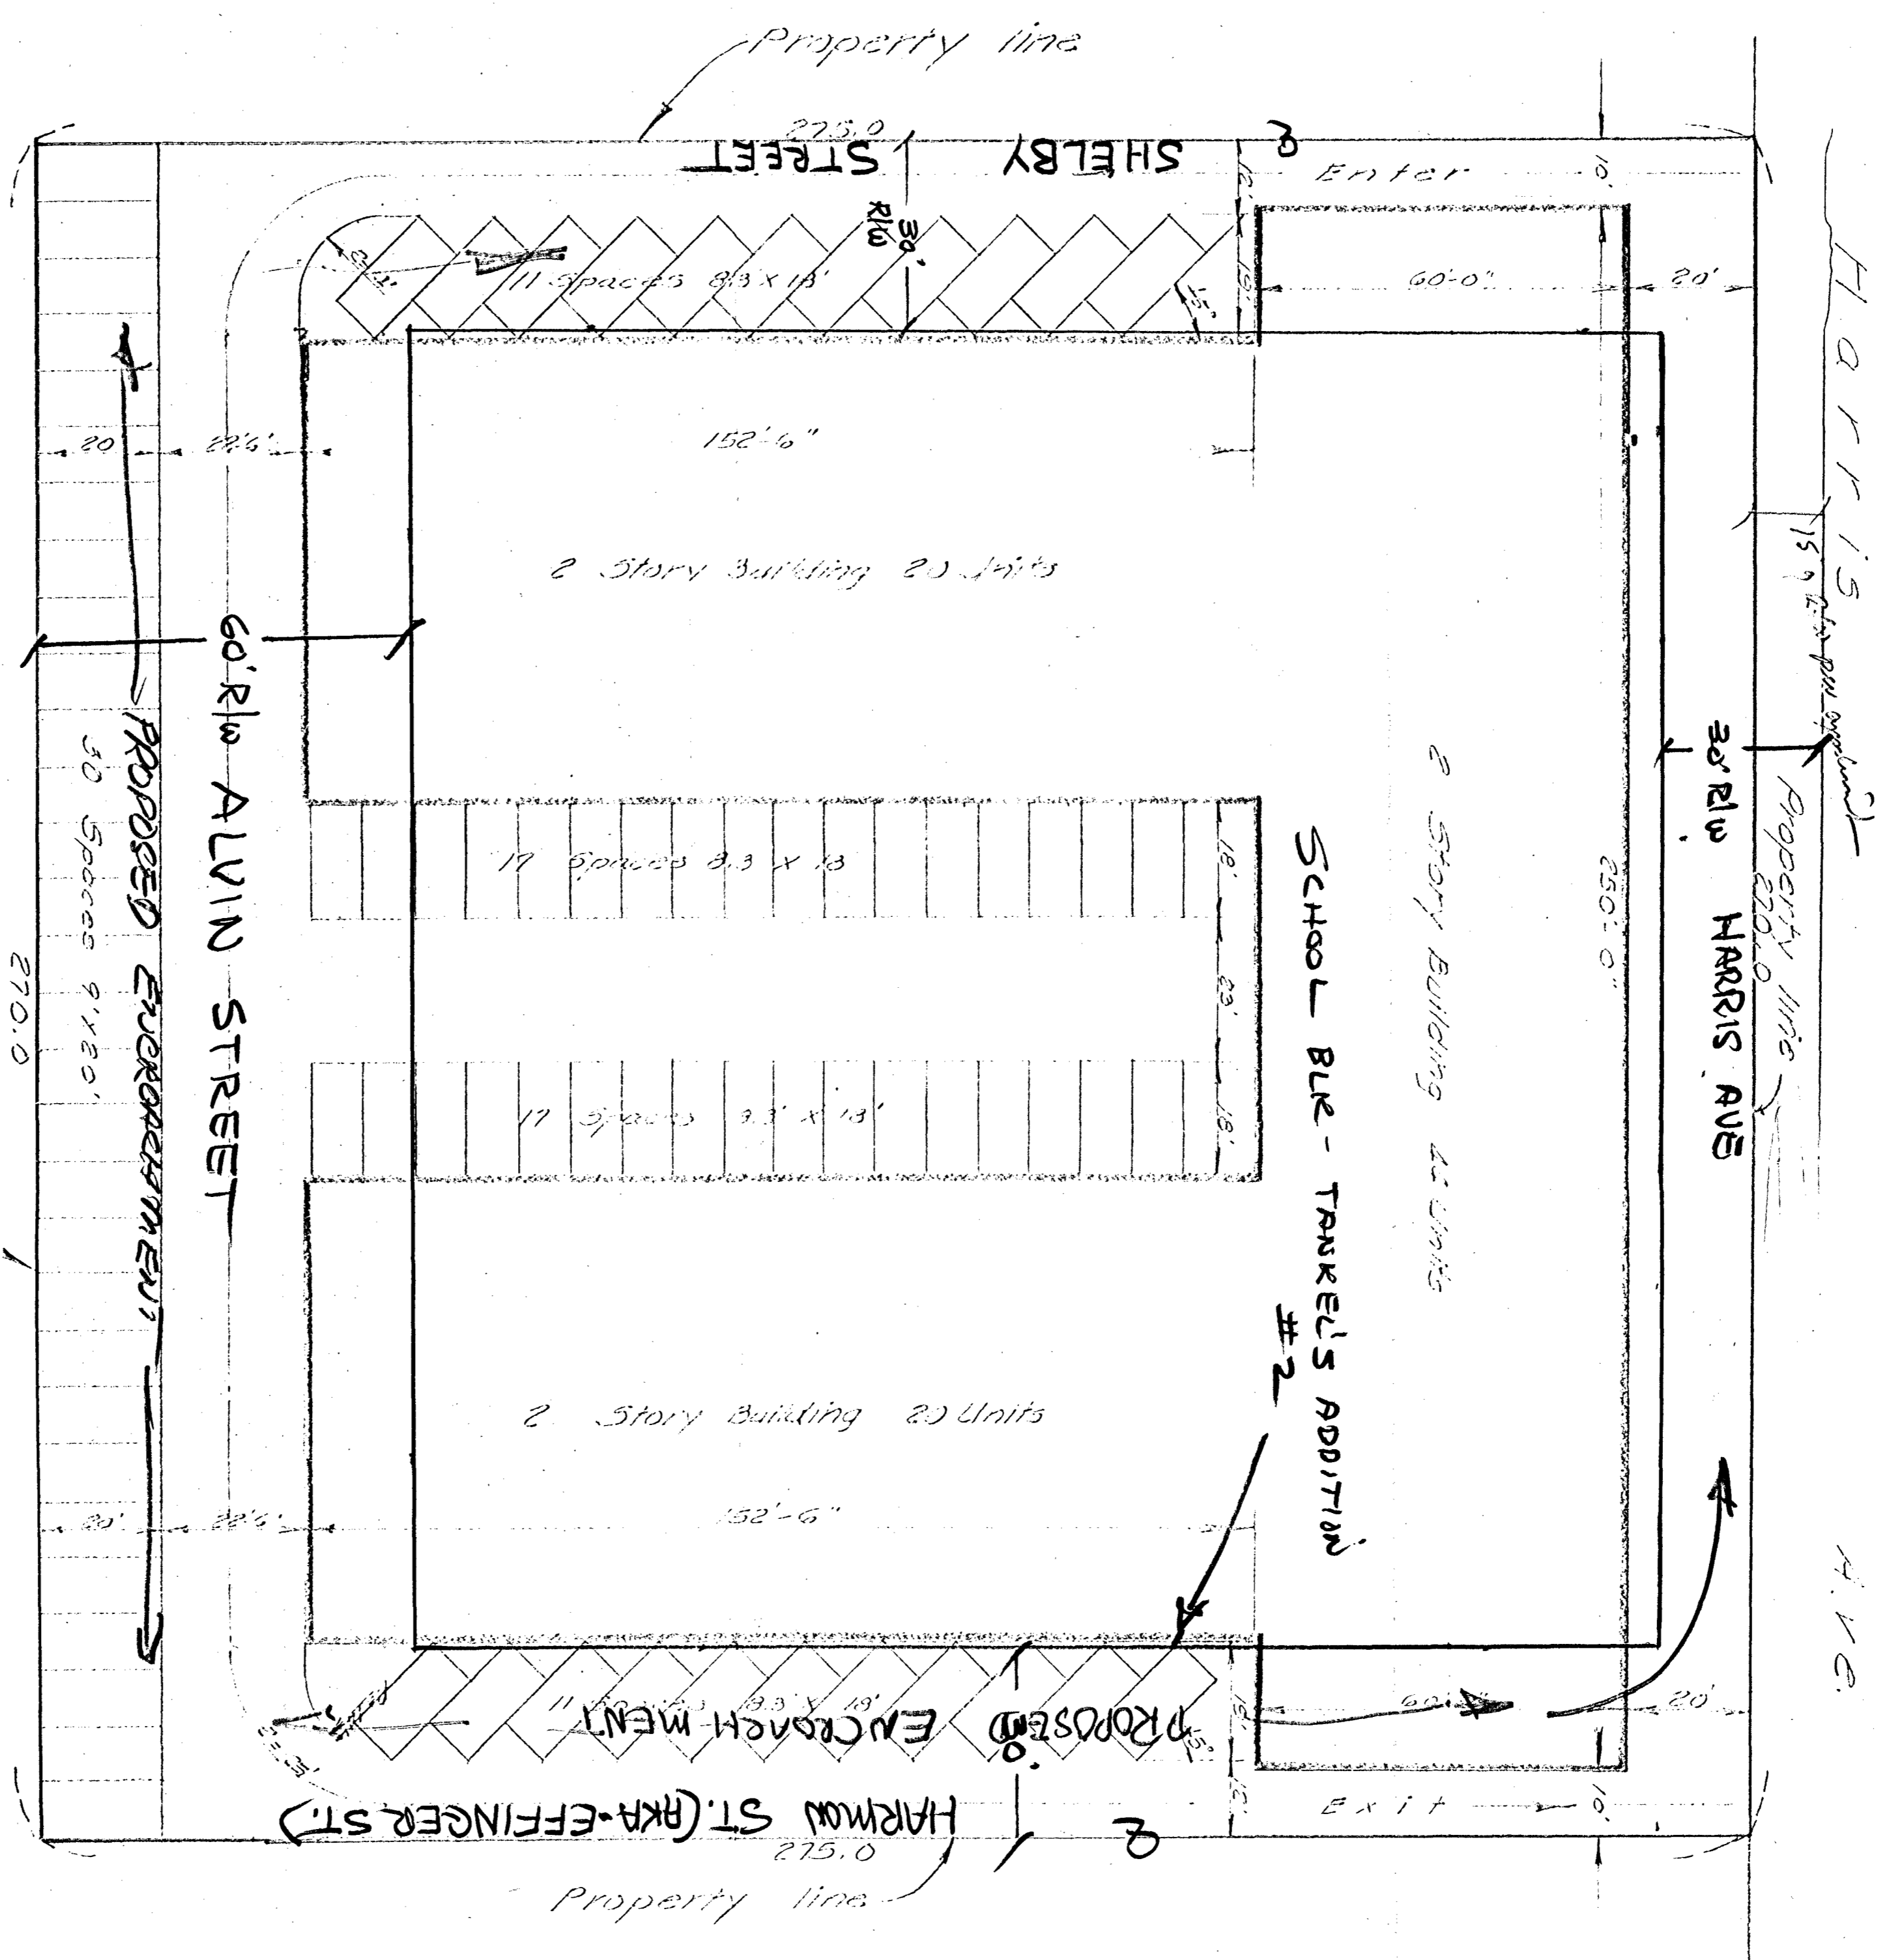

84 Units  
36 Parking Spaces

SCALE: 1 inch equals 20 feet


275  
275  
522.50  
522.50  
1750  
1750  
147000  
147000

Staff Copy

47

DATE	BY	REVISIONS
		APPROVED FOR CONSTRUCTION
		APPROVED FOR PLANNING
		APPROVED FOR ALTIMETER
		APPROVED FOR UTILITY
		APPROVED FOR RECORD

