


R-E      E2      G-1

R-3

R-4

G-1

WENS AVENUE      OWENS AVENUE

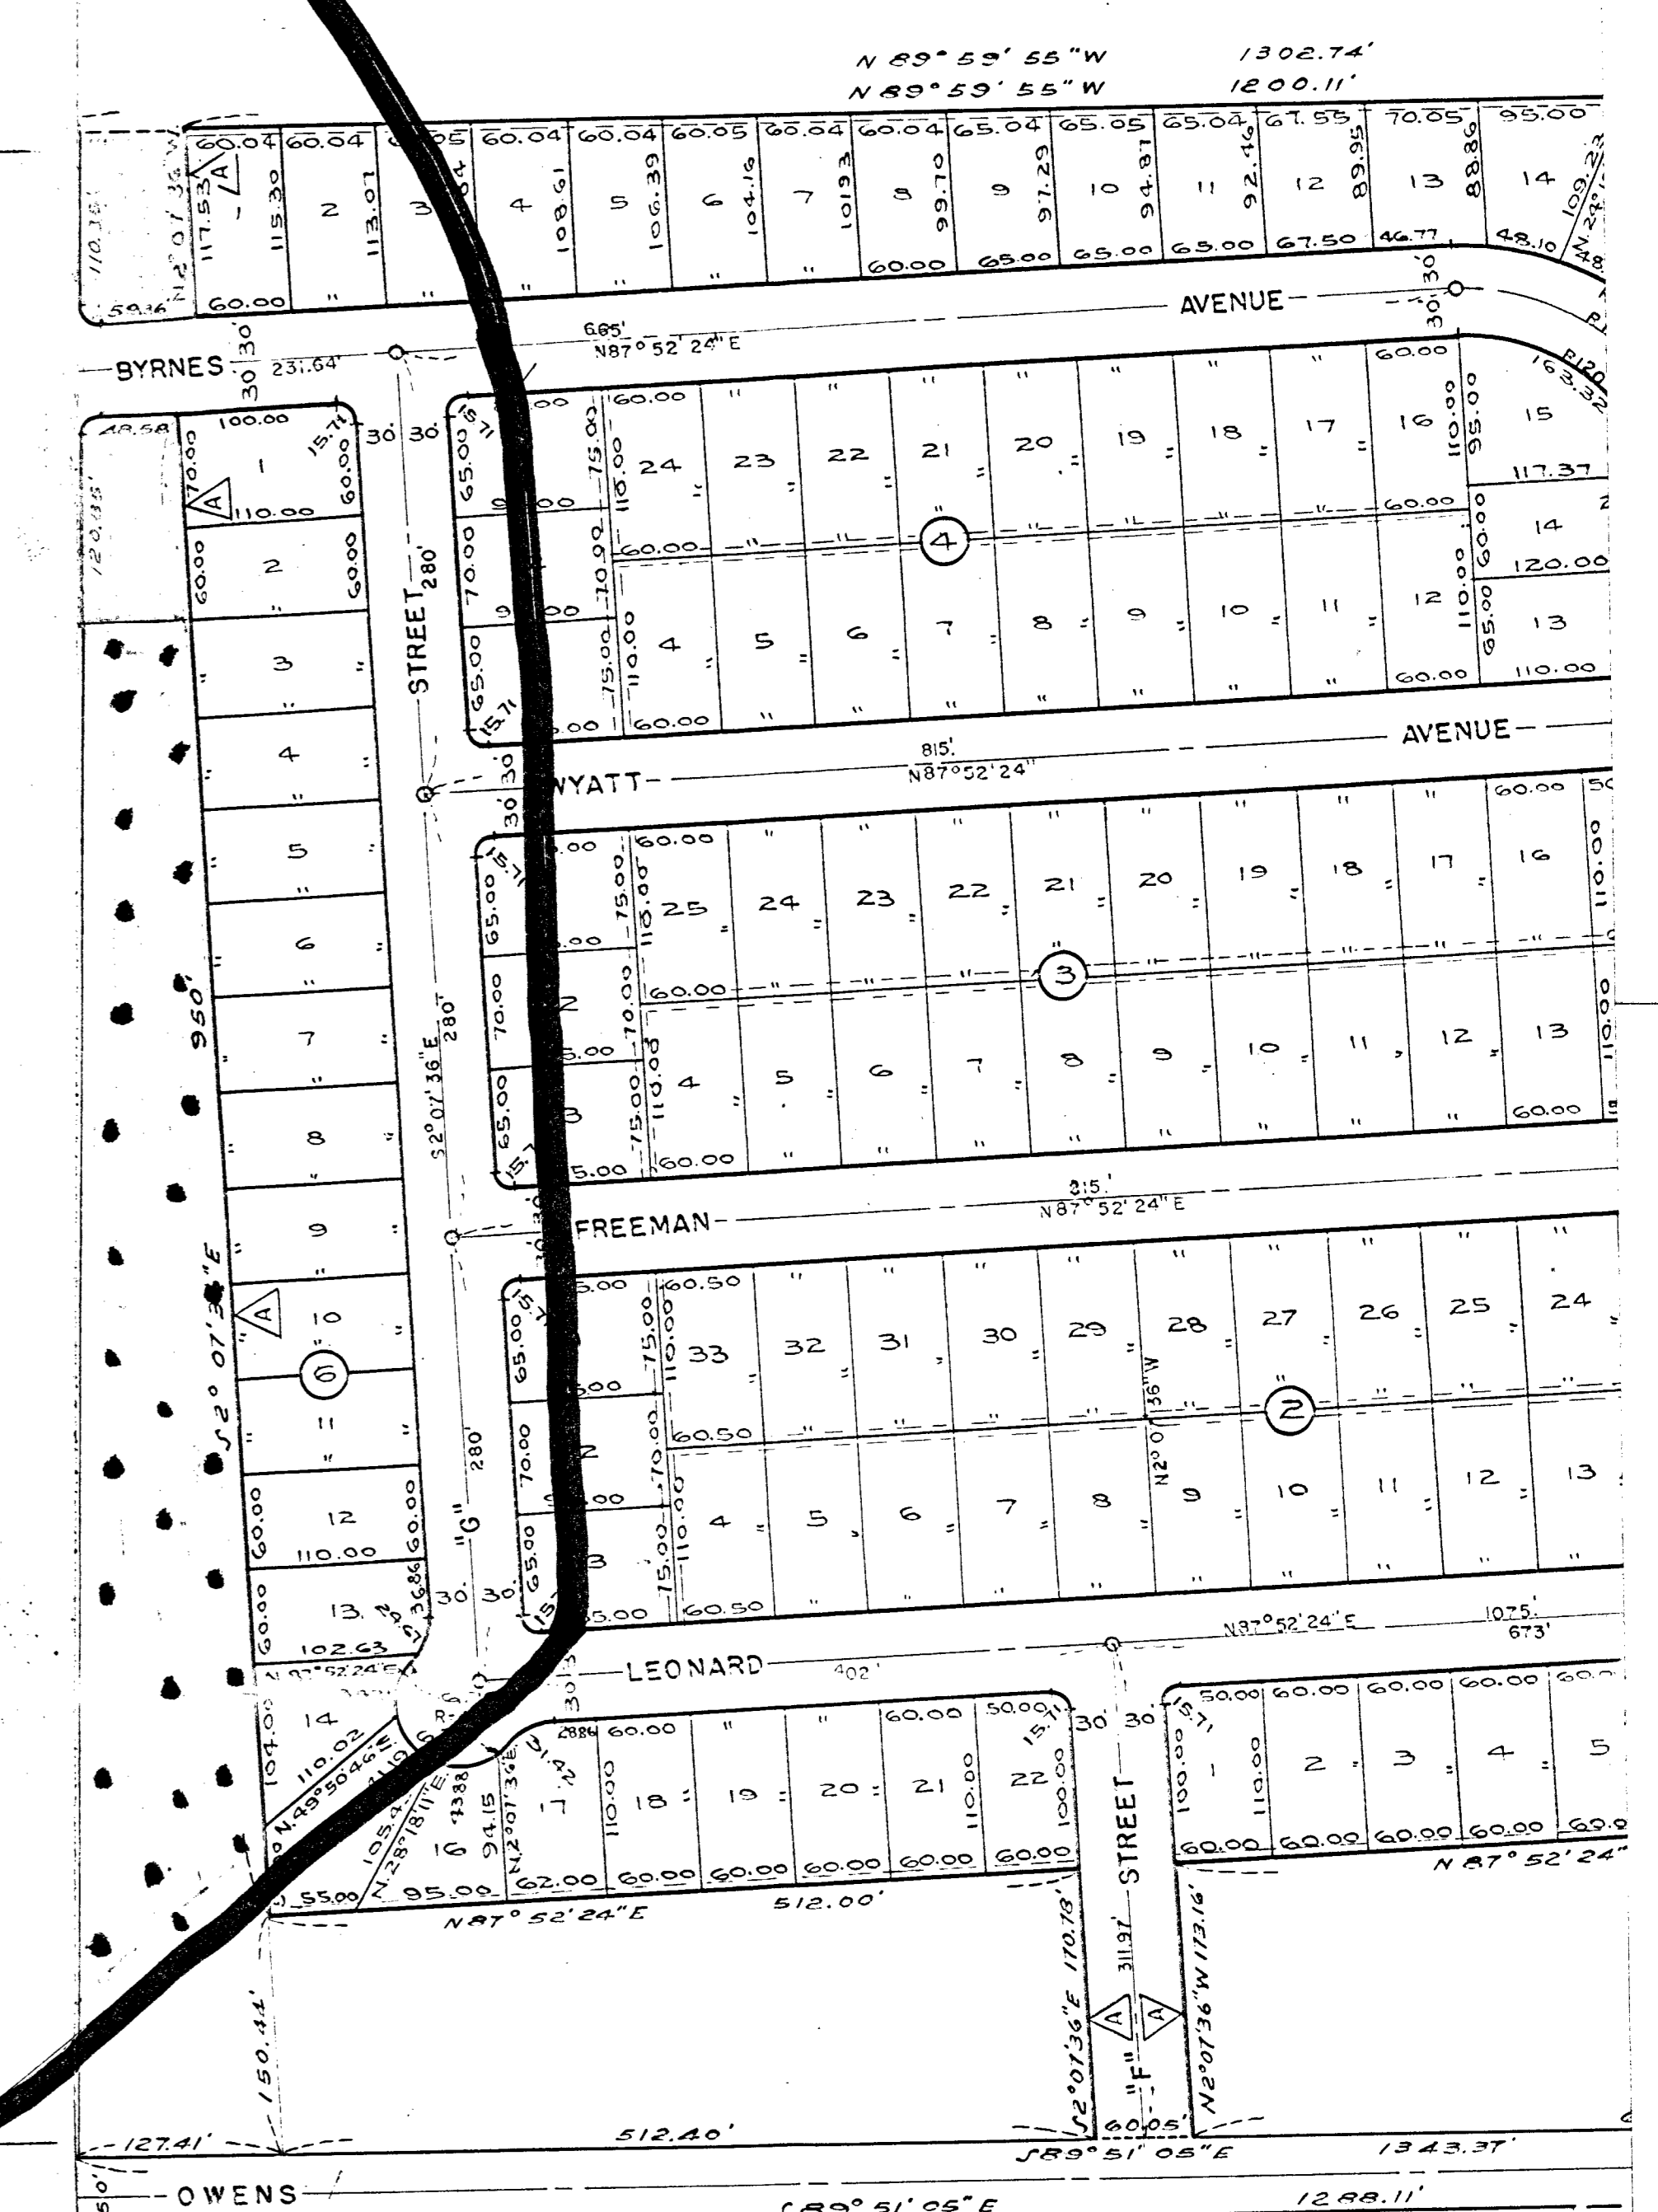

Z-49

HIGHLAND SQUARE

S1/2 SE1/4 SEC21 T20S			
CITY OF LAS VEGAS			
ENGINEERING DEP			
DISTRICT		MAP - SHE	
DESIGNED BY	DATE	SCALE	FIELD
DRAWN BY D. Stark	12-20-55		WORK
CHECKED BY			DRAW
APPROVED			
CITY ENGR.			

**Z-49-61**

Approved C.C. 9-27-61

Z-49-61  
GAMBARANA  
R-3E to R-3T