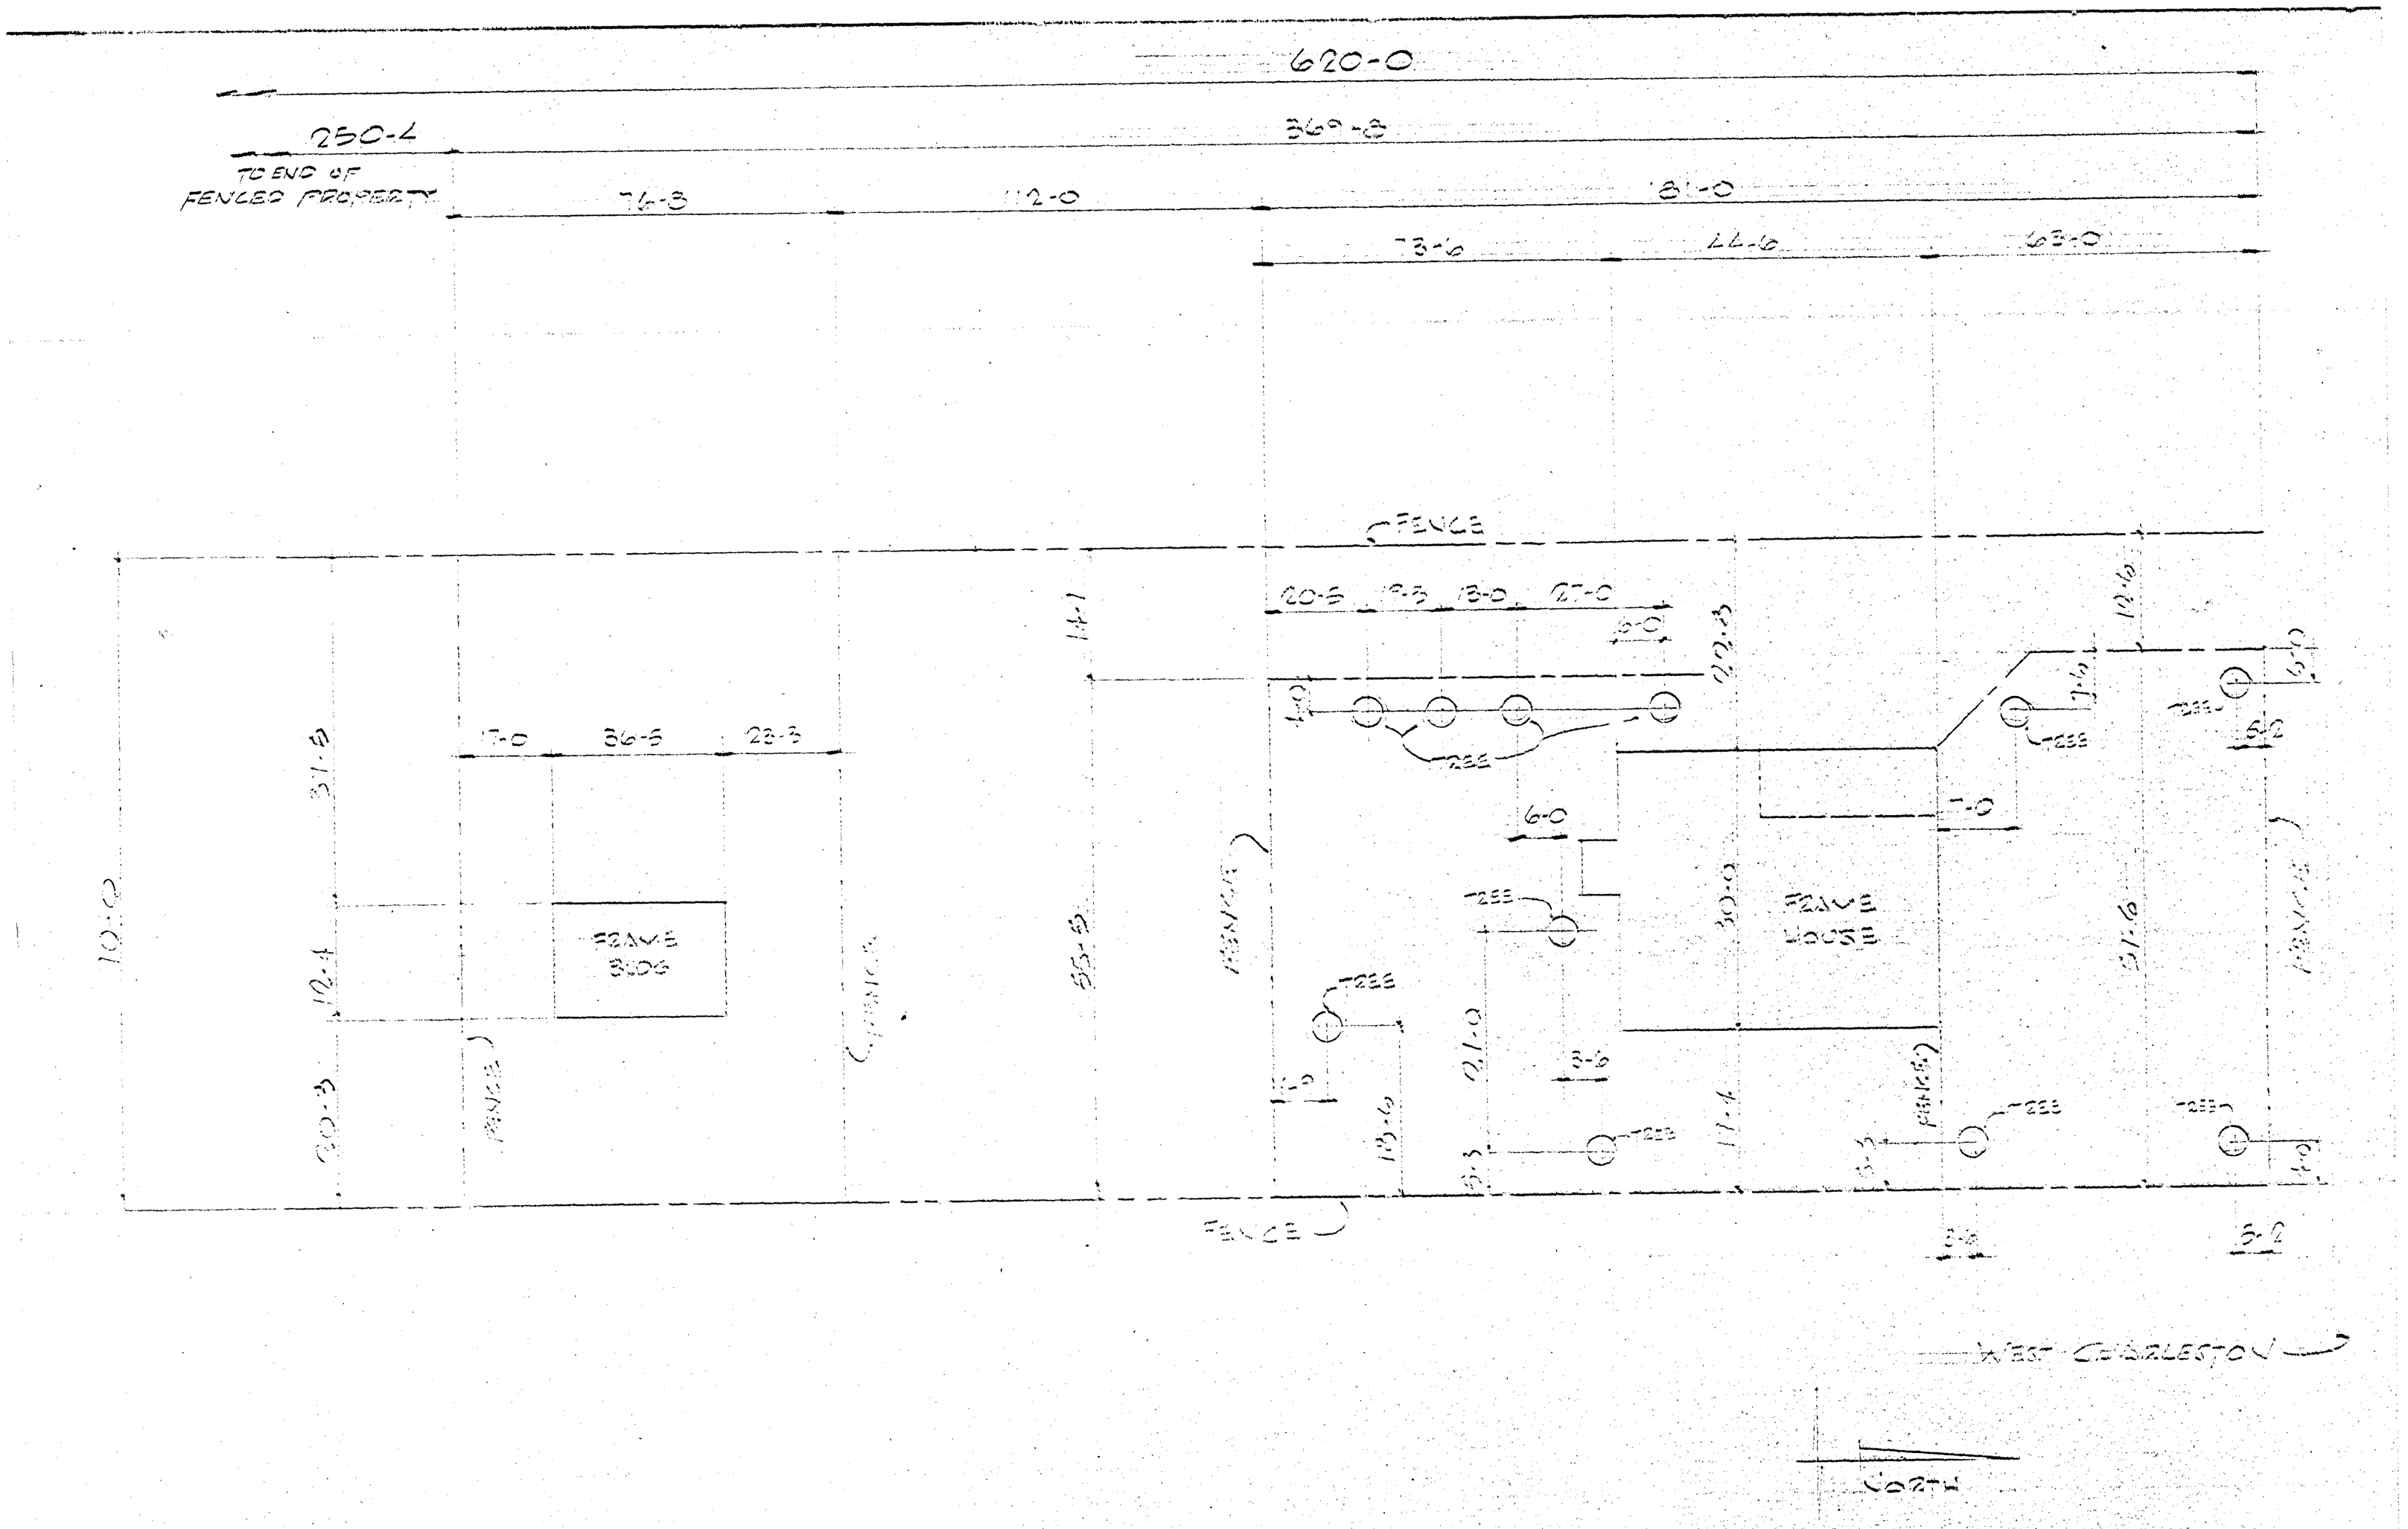

PLOT PLAN
2030 WEST CHARLESTON BLVD
LAS VEGAS, NEVADA

54