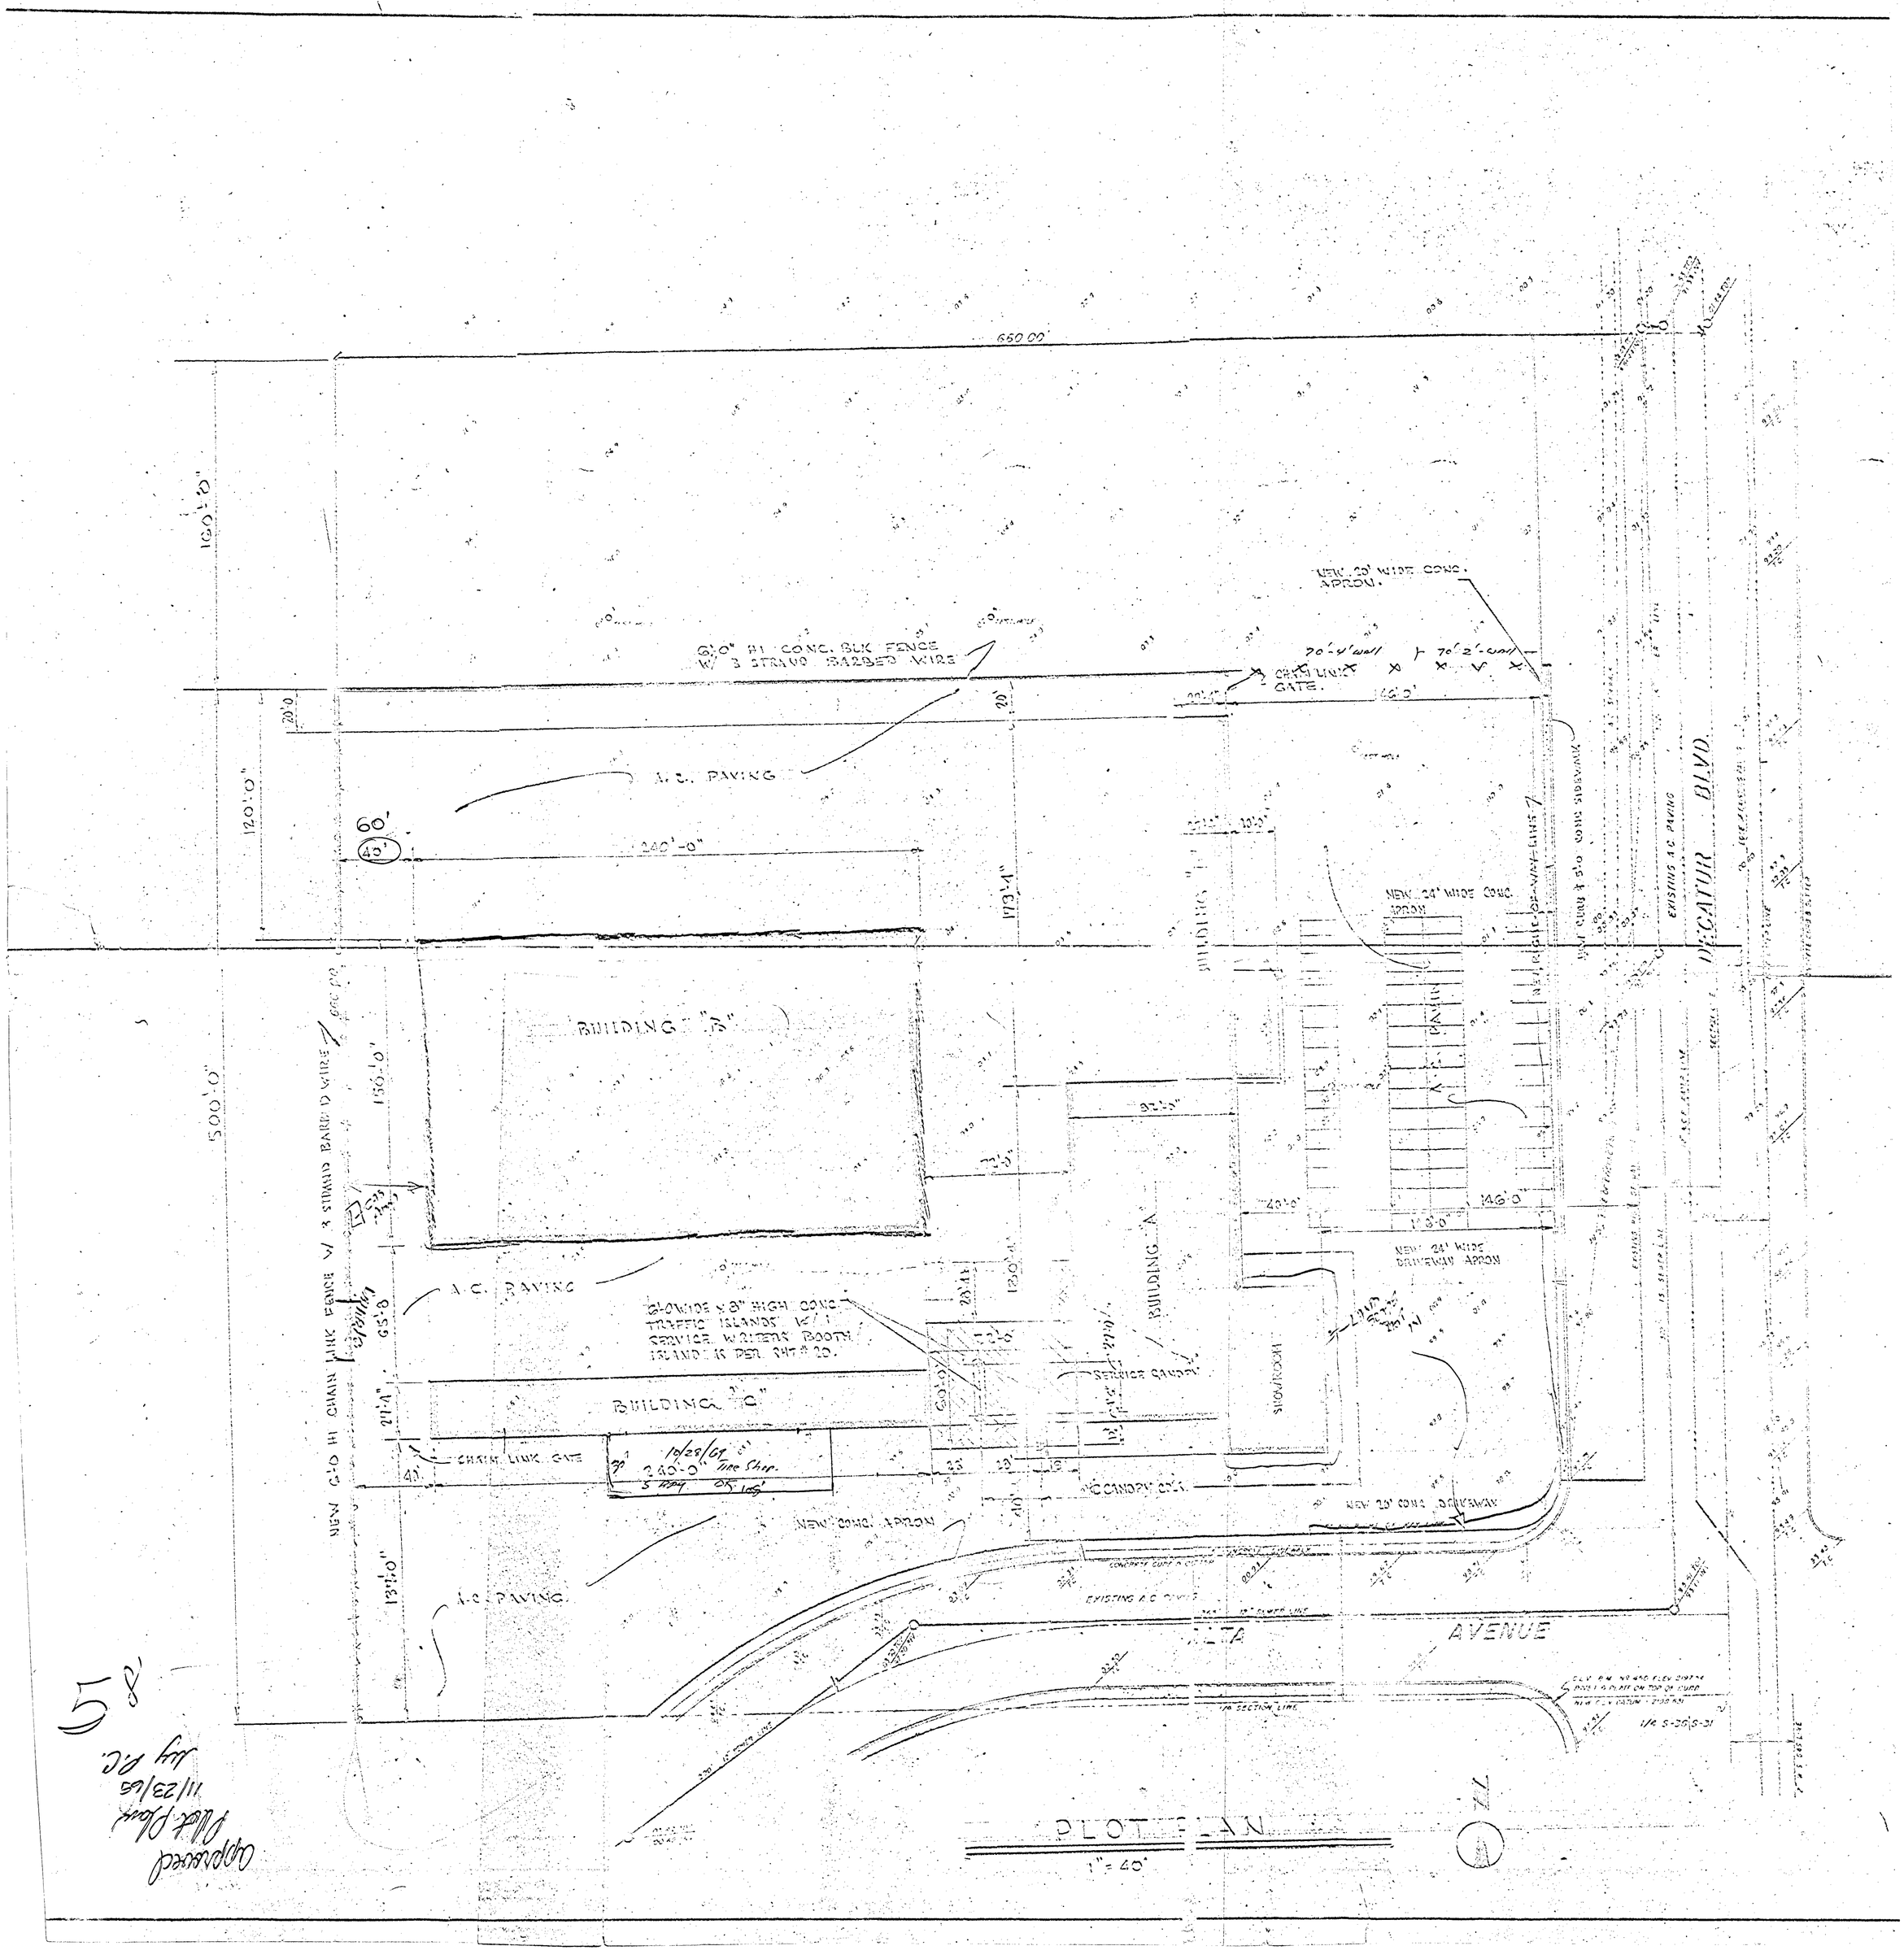
650.00'
120'-0"
6'-0" HI CONC. BLK FENCE W/ 3 STRAND BARBED WIRE
NEW 20' WIDE CONC. APRON.
70'-4" wall
70'-2" wall
CHAIN LINK GATE.
A.C. PAVING
60'
40'
240'-0"
NEW 24' WIDE CONC. APRON
BUILDING "B"
BUILDING "A"
BUILDING "C"
A.C. PAVING
6'-0" WIDE x 8" HIGH CONC TRAFFIC ISLANDS W/ SERVICE WALTERS BOOTH ISLAND IS PER SHT # 20.
SERVICE CANOPY
SHOWROOM
CHAIN LINK GATE
10/28/69 Tire Shop.
CANOPY
NEW 24' WIDE DRIVEWAY APRON
NEW 24' CONC. DRIVEWAY
NEW CONC. APRON
A.C. PAVING
NEW 6'-0 HI CHAIN LINK FENCE W/ 3 STRAND BARB'D WIRE
500'-0"
156'-0"
EXISTING A.C. PAVING
DECATUR BLVD.
ALTA AVENUE
PLOT PLAN
1" = 40'
N
Approved Plot Plan 11/23/68 Jay R.C.
58'