


SCALE: 1" = 100'

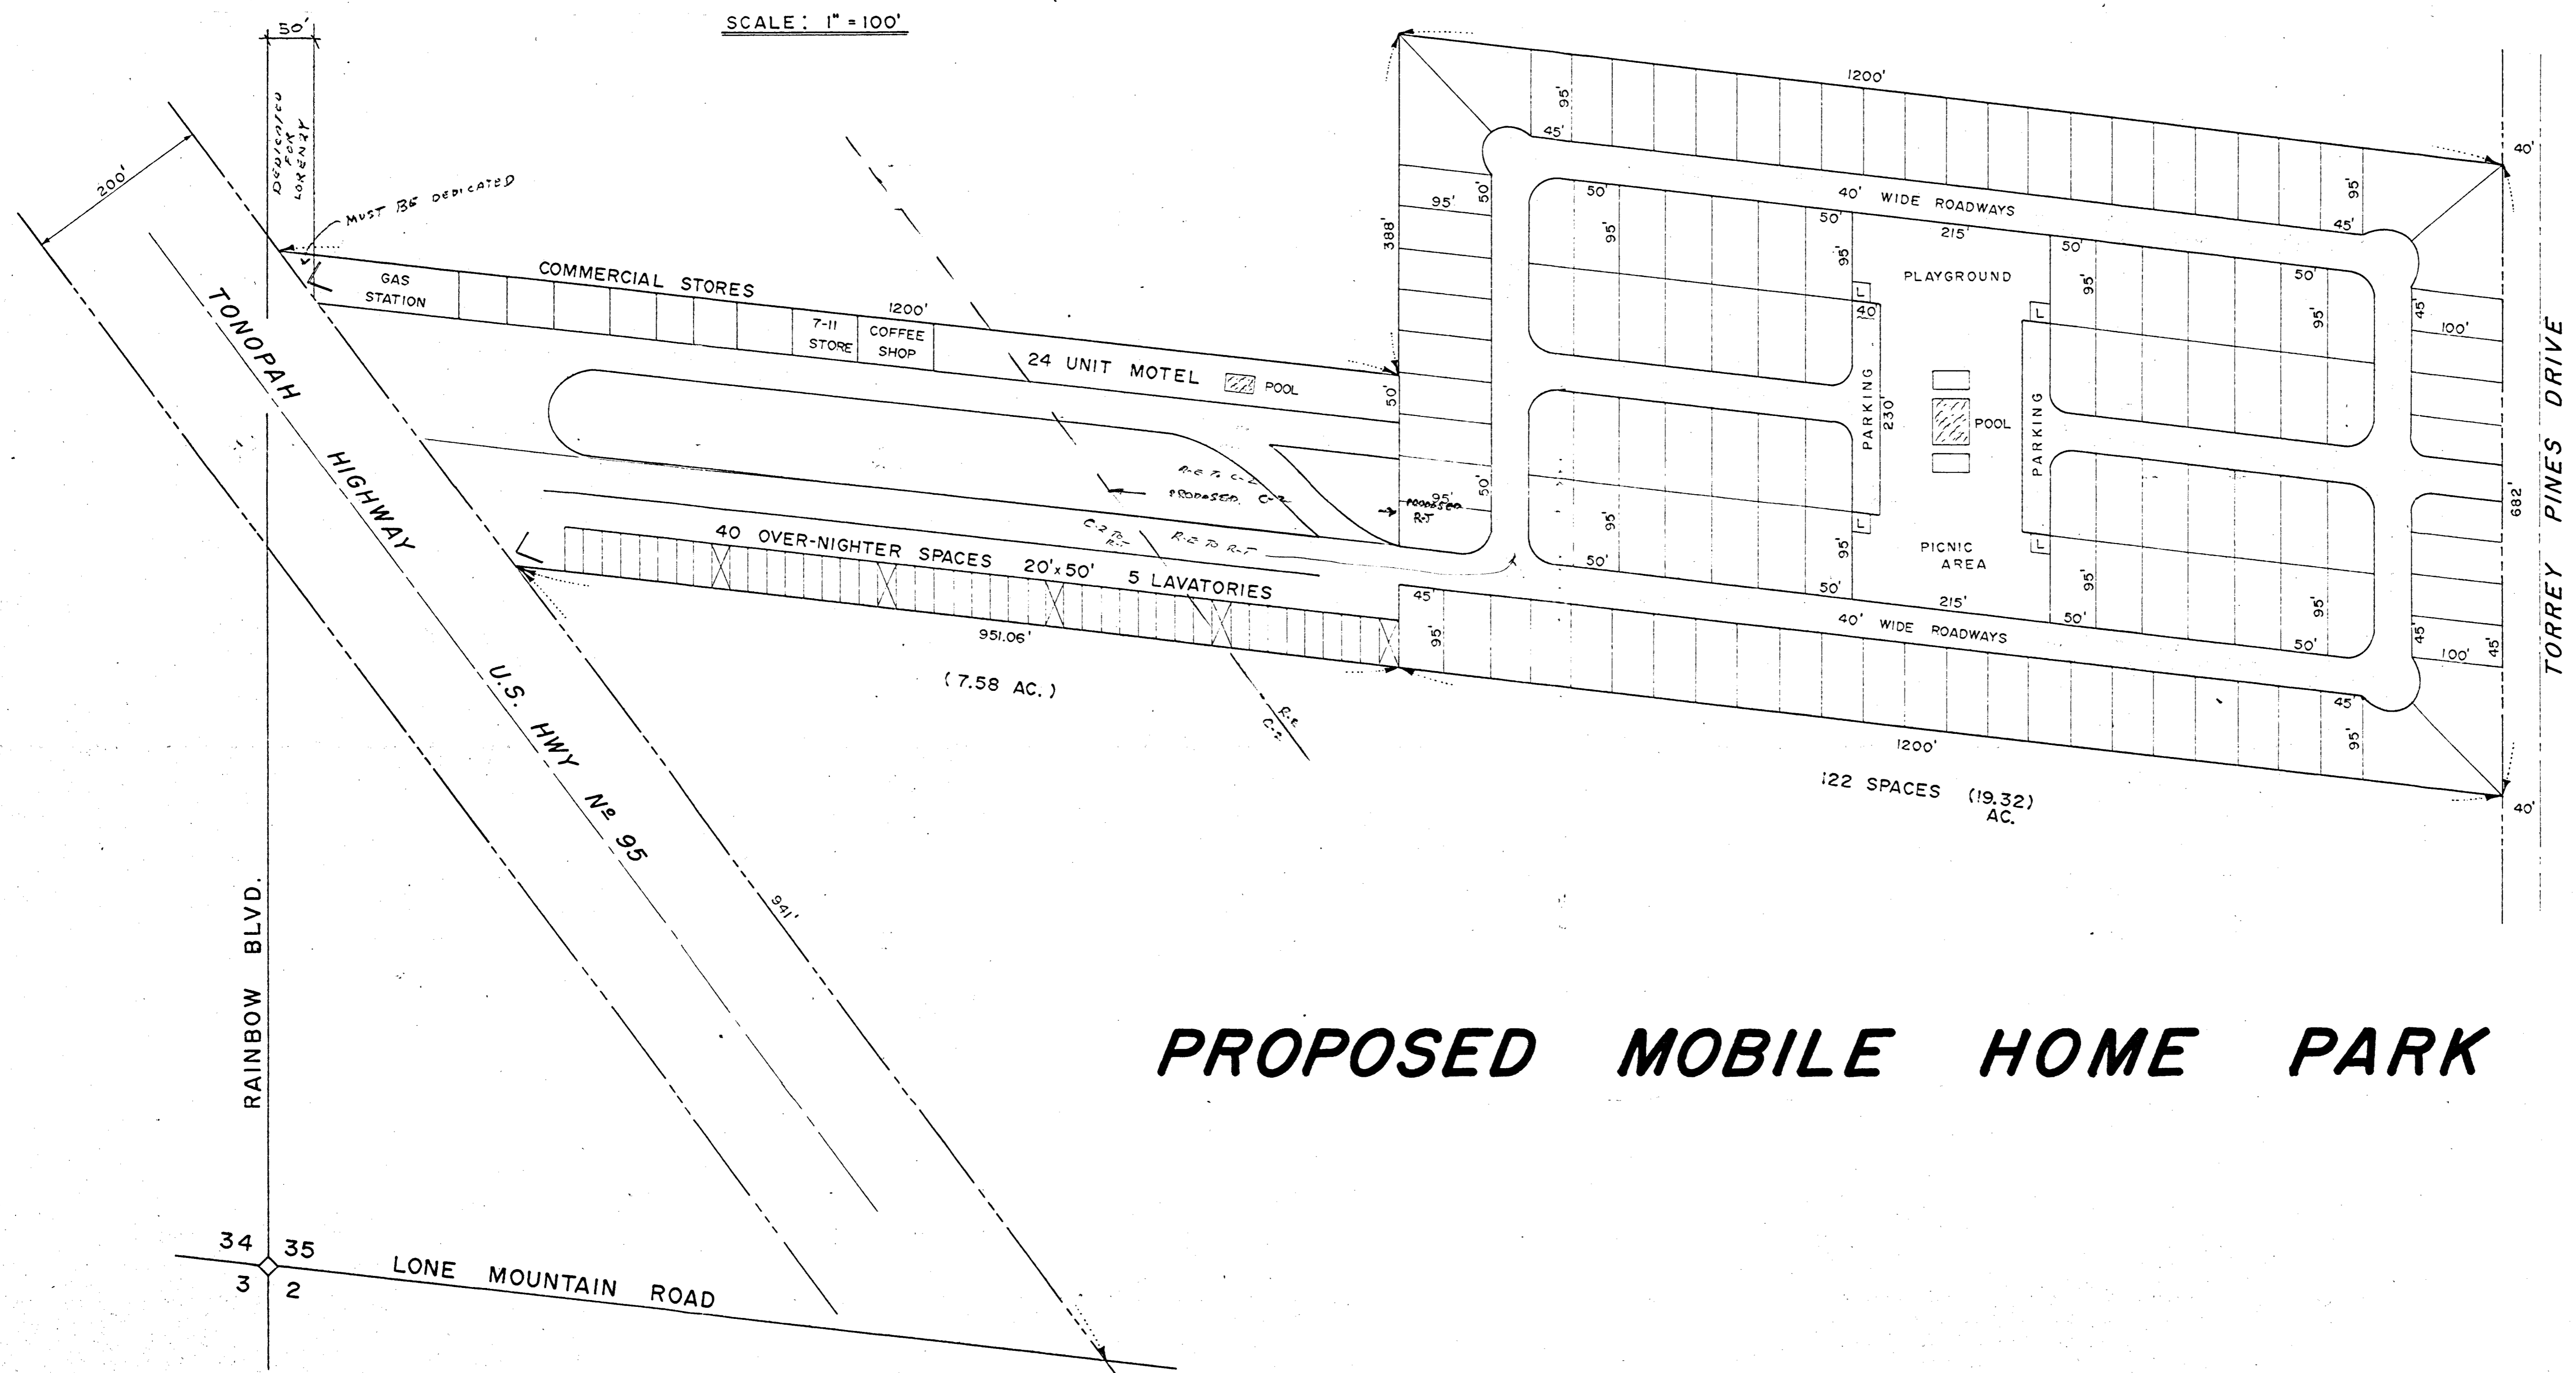

# PROPOSED MOBILE HOME PARK

Subject To  
 Local Ordinance  
 and State Requirements  
 for Mobile Home Parks  
 and for State 130




59

Z-59-69

T.19S.  
T.20S.

R.60E.  
R.61E.

CHEYENNE AVE.

CHEYENNE AVE.

AVE.

AVE.

CHEYENNE AVE.

16

15

14

13

21

22

23

24

28

27

26

25

33

34

35

36

4

3

2

9

10

11

12

FARM ROAD

DEER SPRING WAY

CENTENNIAL PARKWAY

BURRO ROAD

ANN ROAD

WASHBURN ROAD

CRAIG ROAD

ALEXANDER ROAD

OWAN ROAD

CHEYENNE AVE.

LORENZI BLVD.

LAKHORN ROAD

STREET

ROAD

SILVERCREST

ROAD

HOUSE ROAD

STREET

ROAD

RD. VISTA











LORENZI BLVD.

LORENZI BLVD.


















































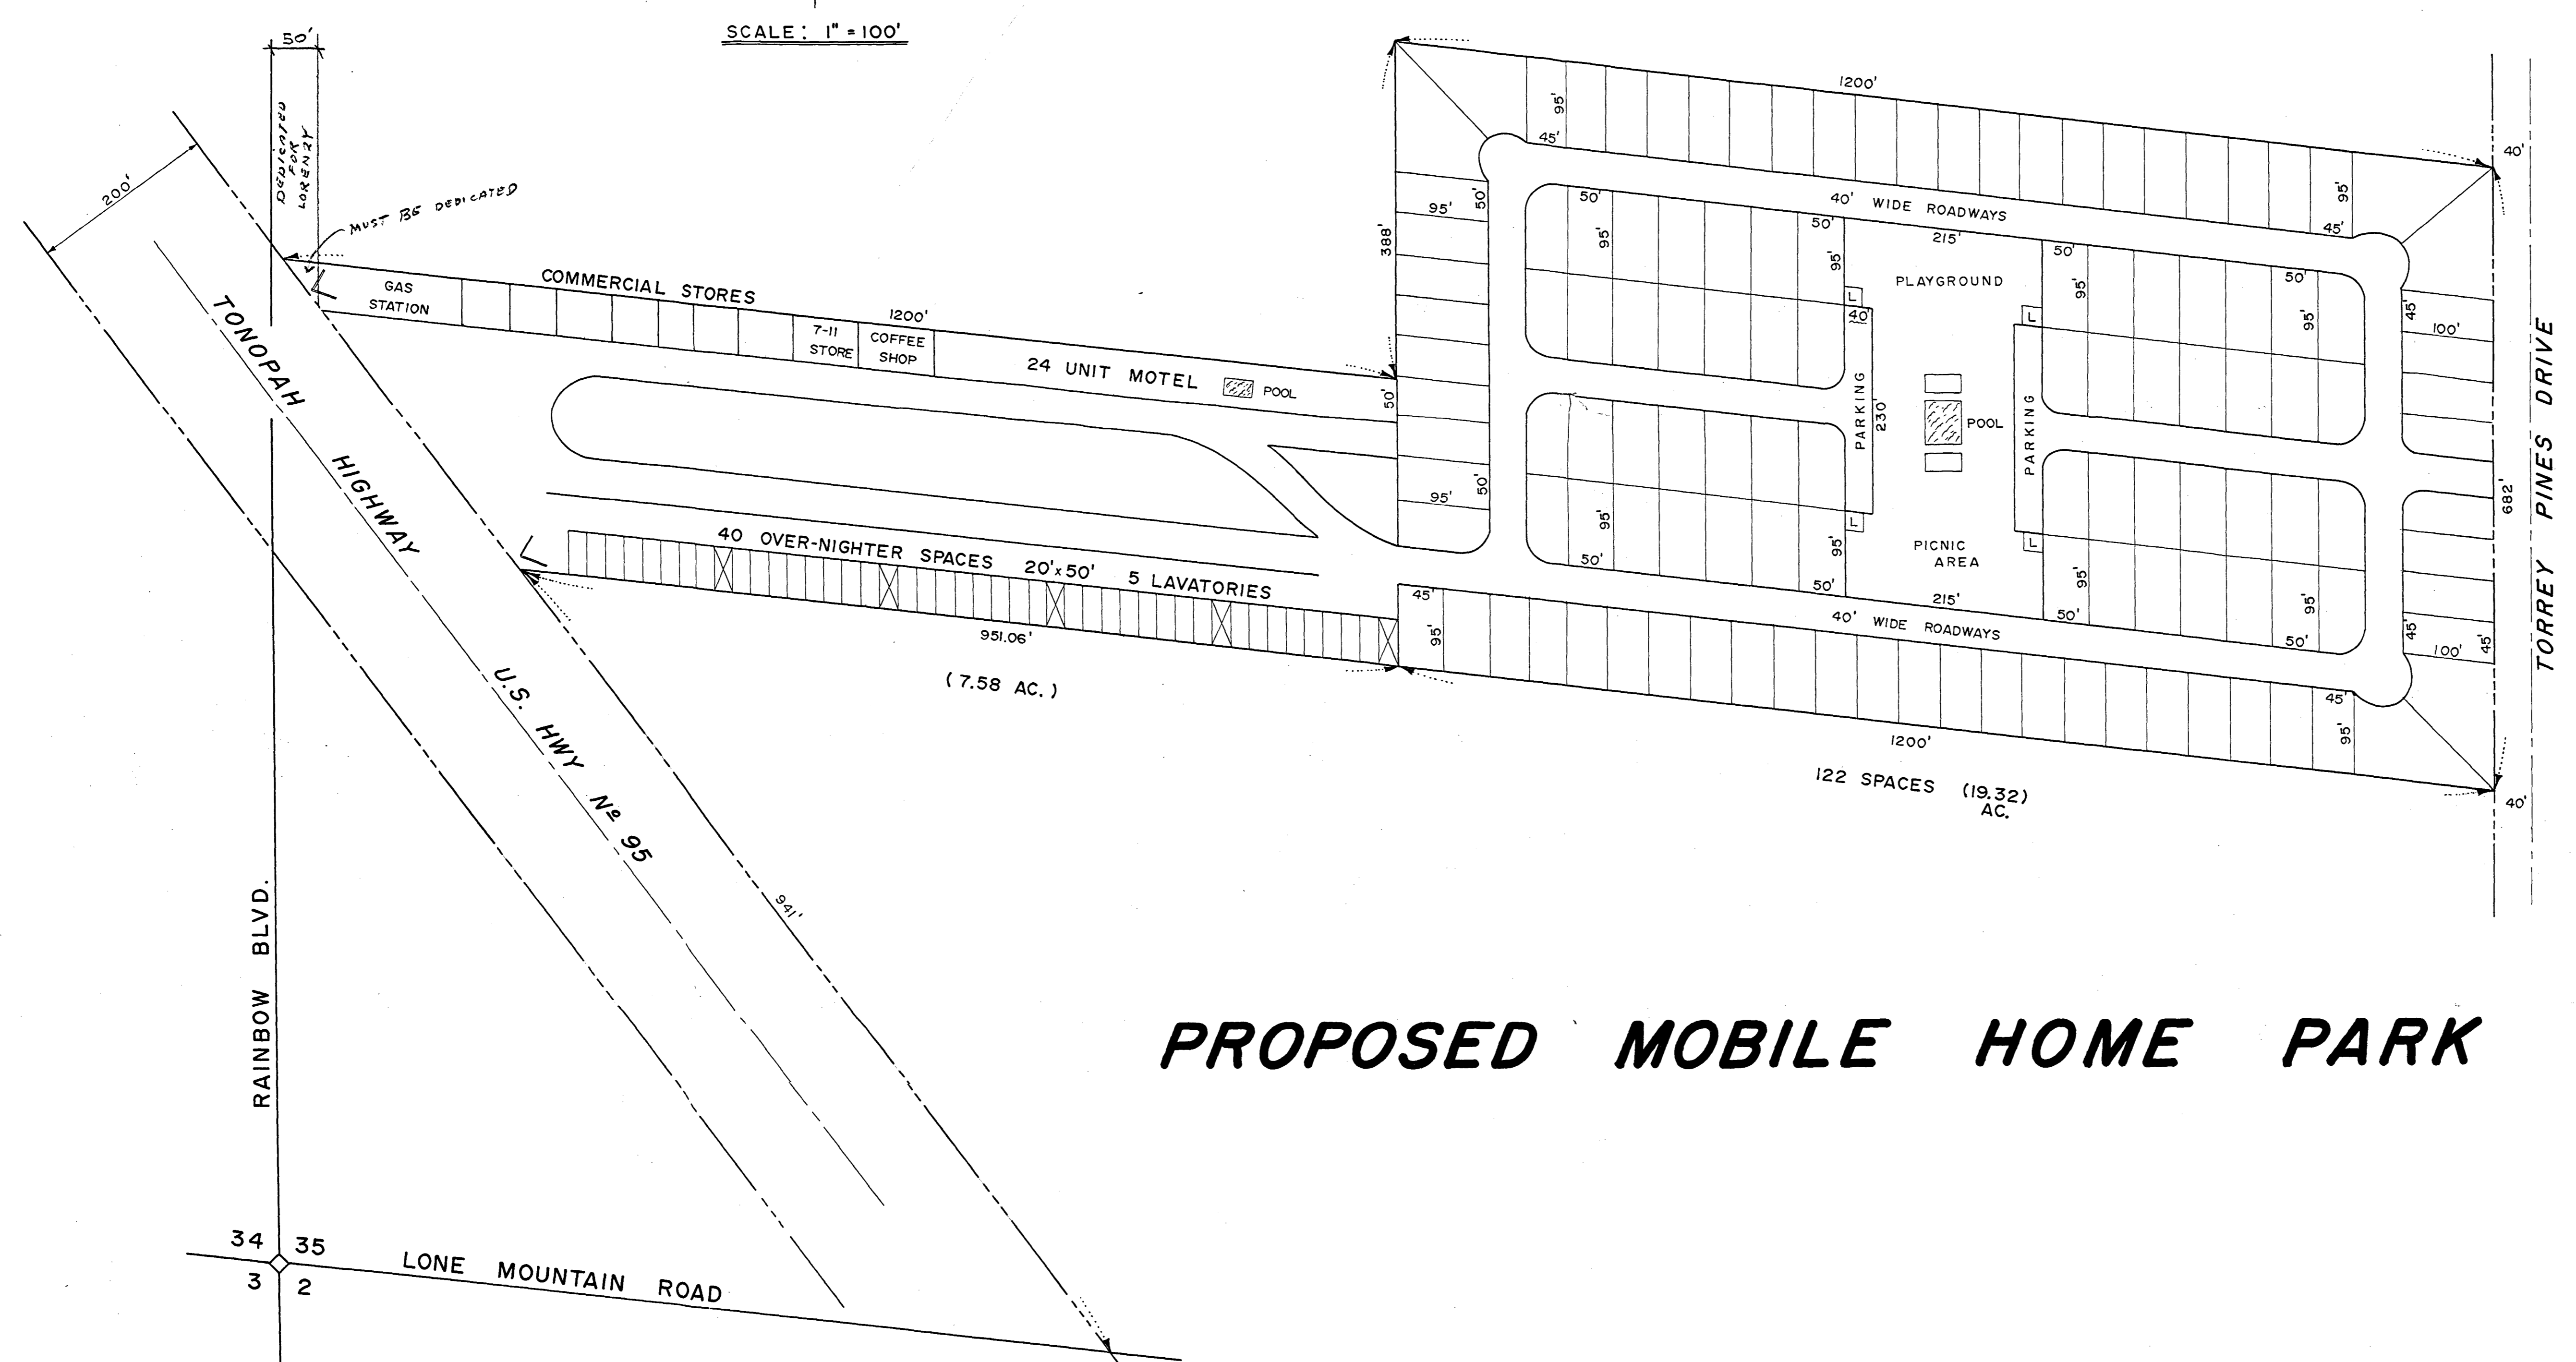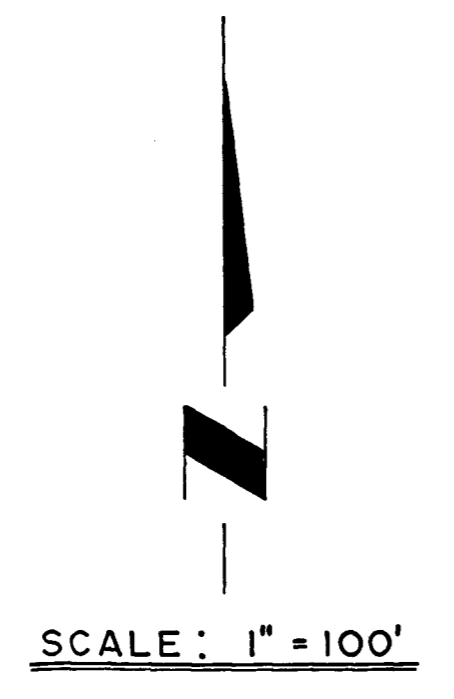

# PROPOSED MOBILE HOME PARK

59