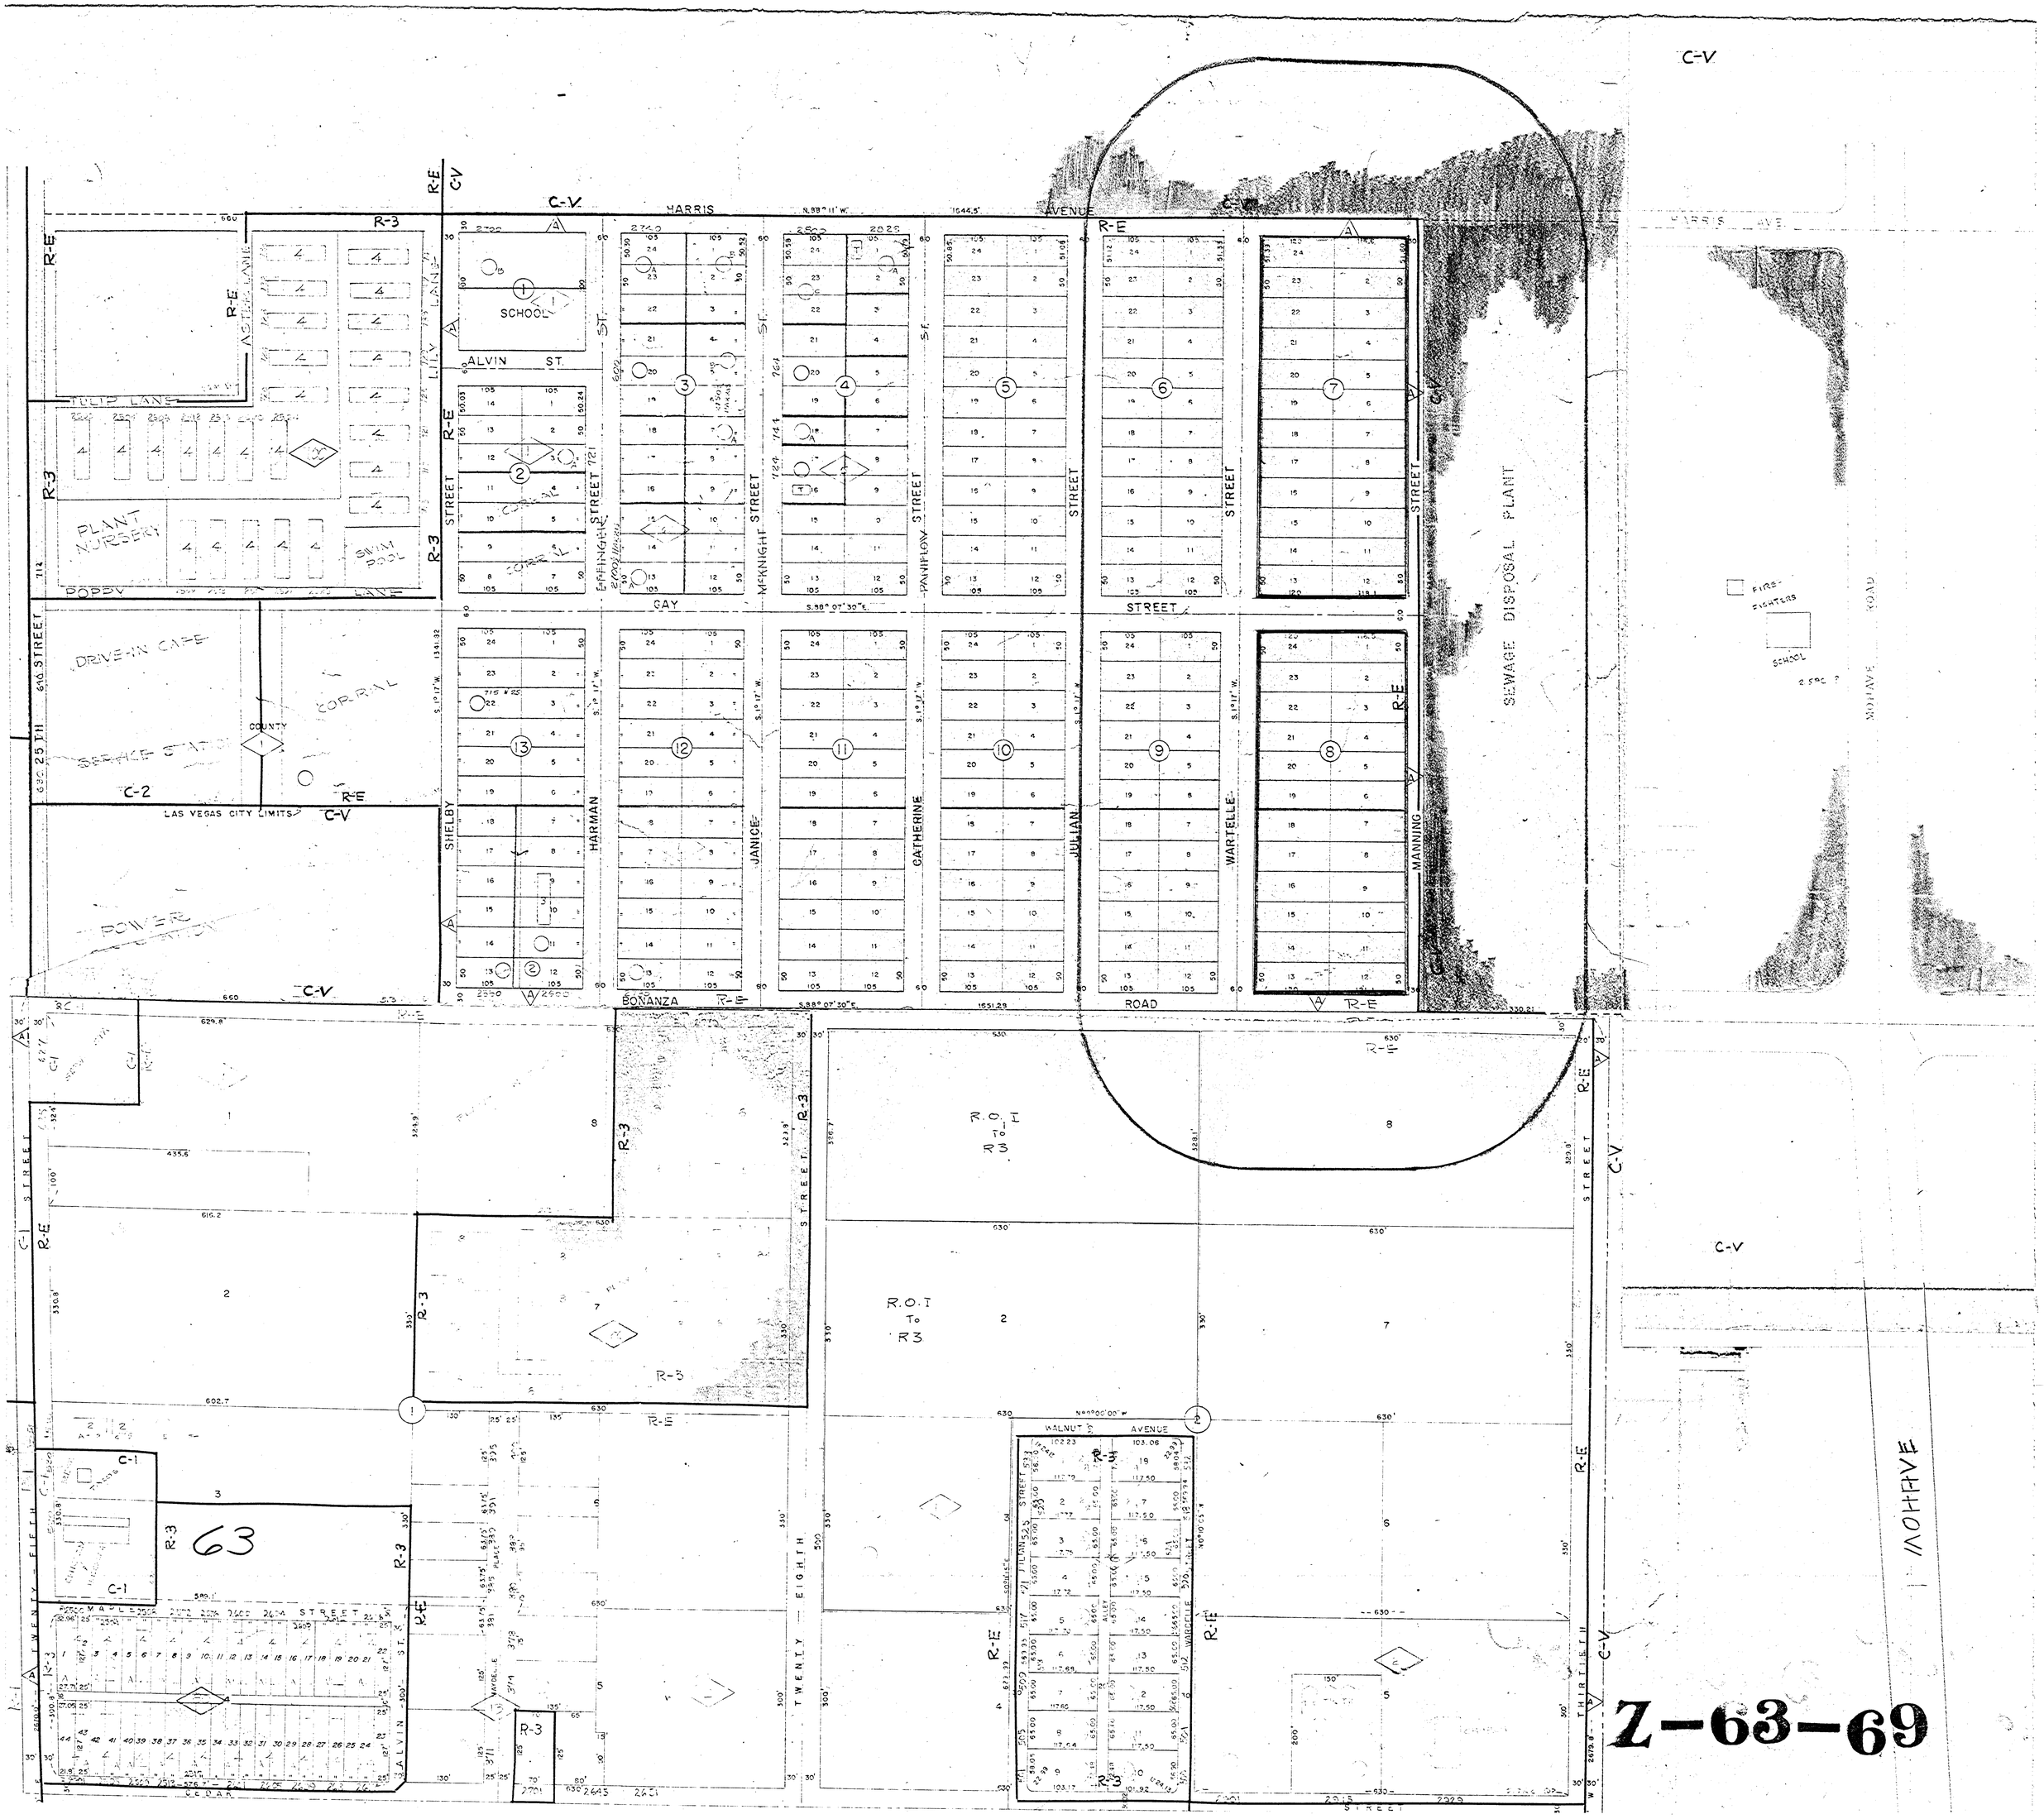
HARRIS AVENUE
SCHOOL
ALVIN ST.
TULIP LANE
LILY LANE
ASTER LANE
PLANT NURSERY
SWIM POOL
POPPY LANE
STREET
GAY STREET
DRIVE-IN CAFE
CORRAL
COUNTY
SERVICE STATION
POWER STATION
LAS VEGAS CITY LIMITS
SHELBY
HARMAN
JANICE
CATHERINE
JULIAN
WARTELLE
MANNING
BONANZA ROAD
SEWAGE DISPOSAL PLANT
FIRE FIGHTERS
SCHOOL
MOHAVE ROAD
R.O.T. To R3
WALNUT AVENUE
TWENTY - EIGHTH
THIRTIETH
CEDAR
ALVIN
63
Z-63-69