


C-V

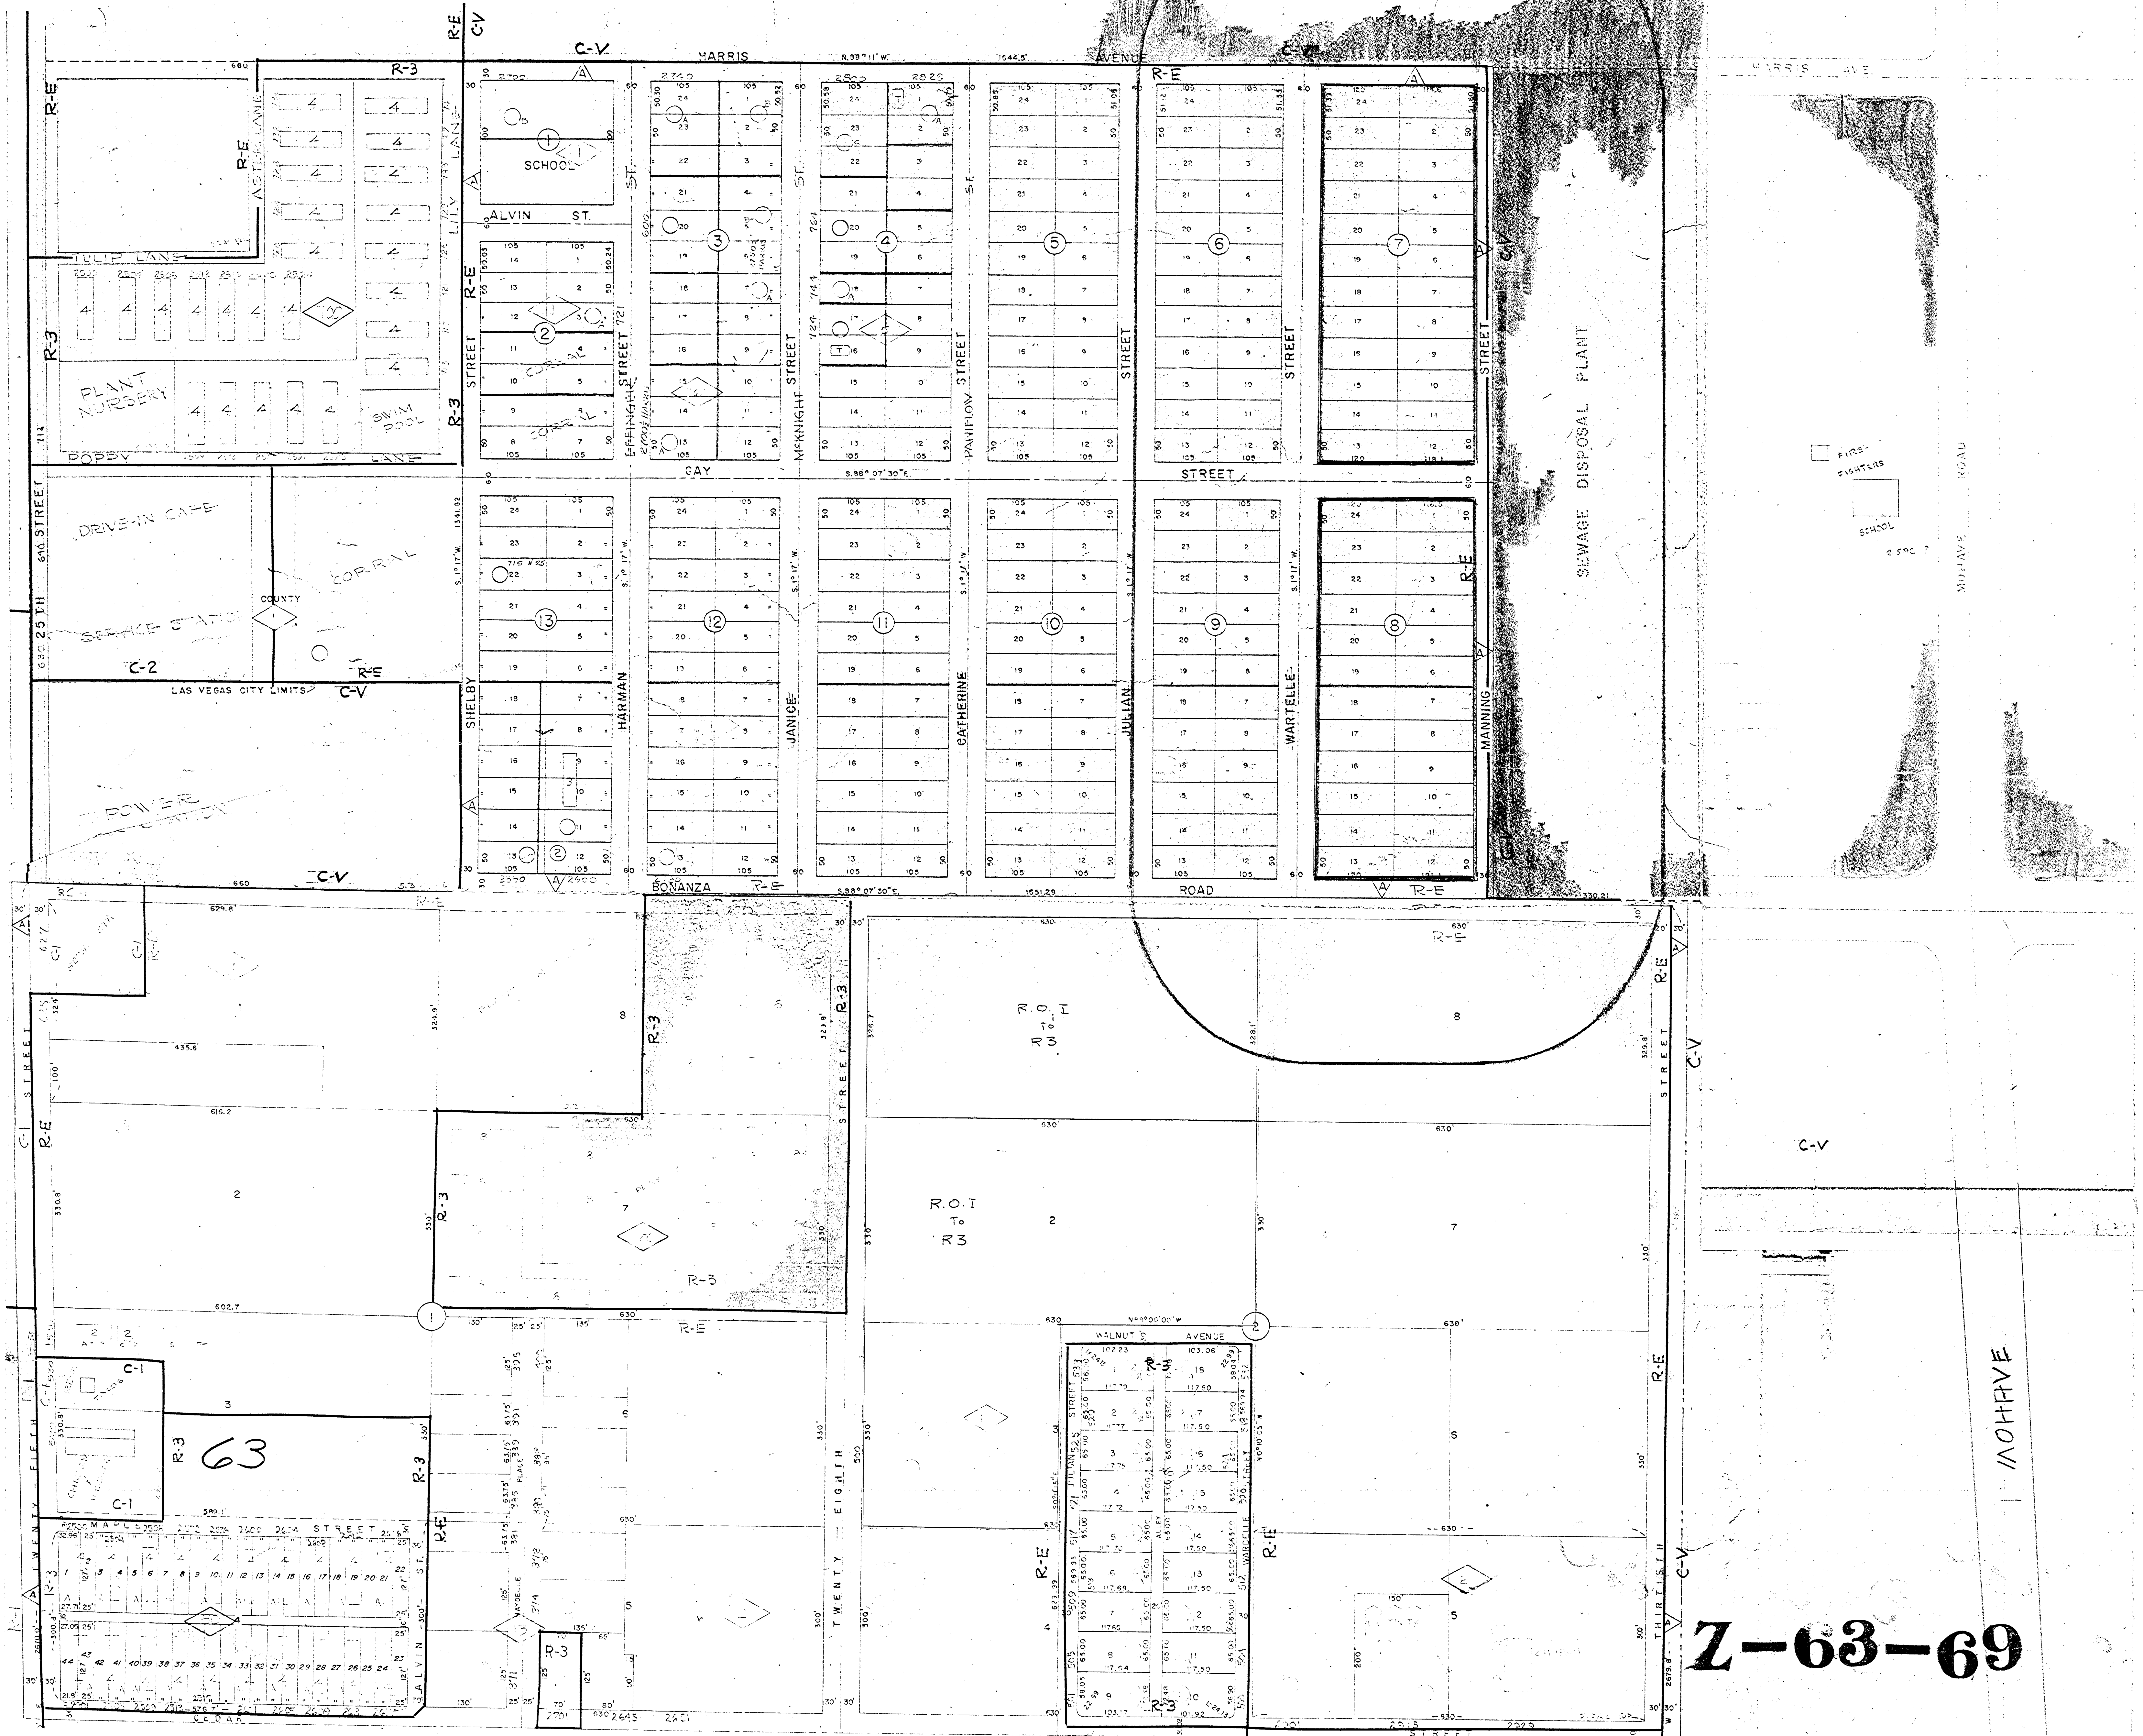

Z-63-69