


SCALE: 1" = 10'


Legal Description

LOT 5  
BLOCK 3  
PARADISE VILLAGE  
TRACT 4


Key:

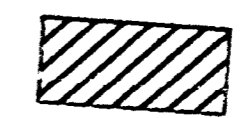

BUILDING

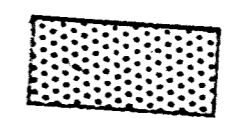


WALKWAY

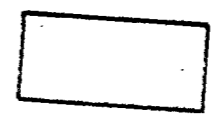

DRIVEWAY & PARKING SPACES — ALL SPACES ARE 9' x 20' — 5 SPACES REQUIRED, 9 SPACES PROVIDED.

65

PLOT PLAN  
for  
ADA GARDNER REALTY  
DATE: September 15, 2000

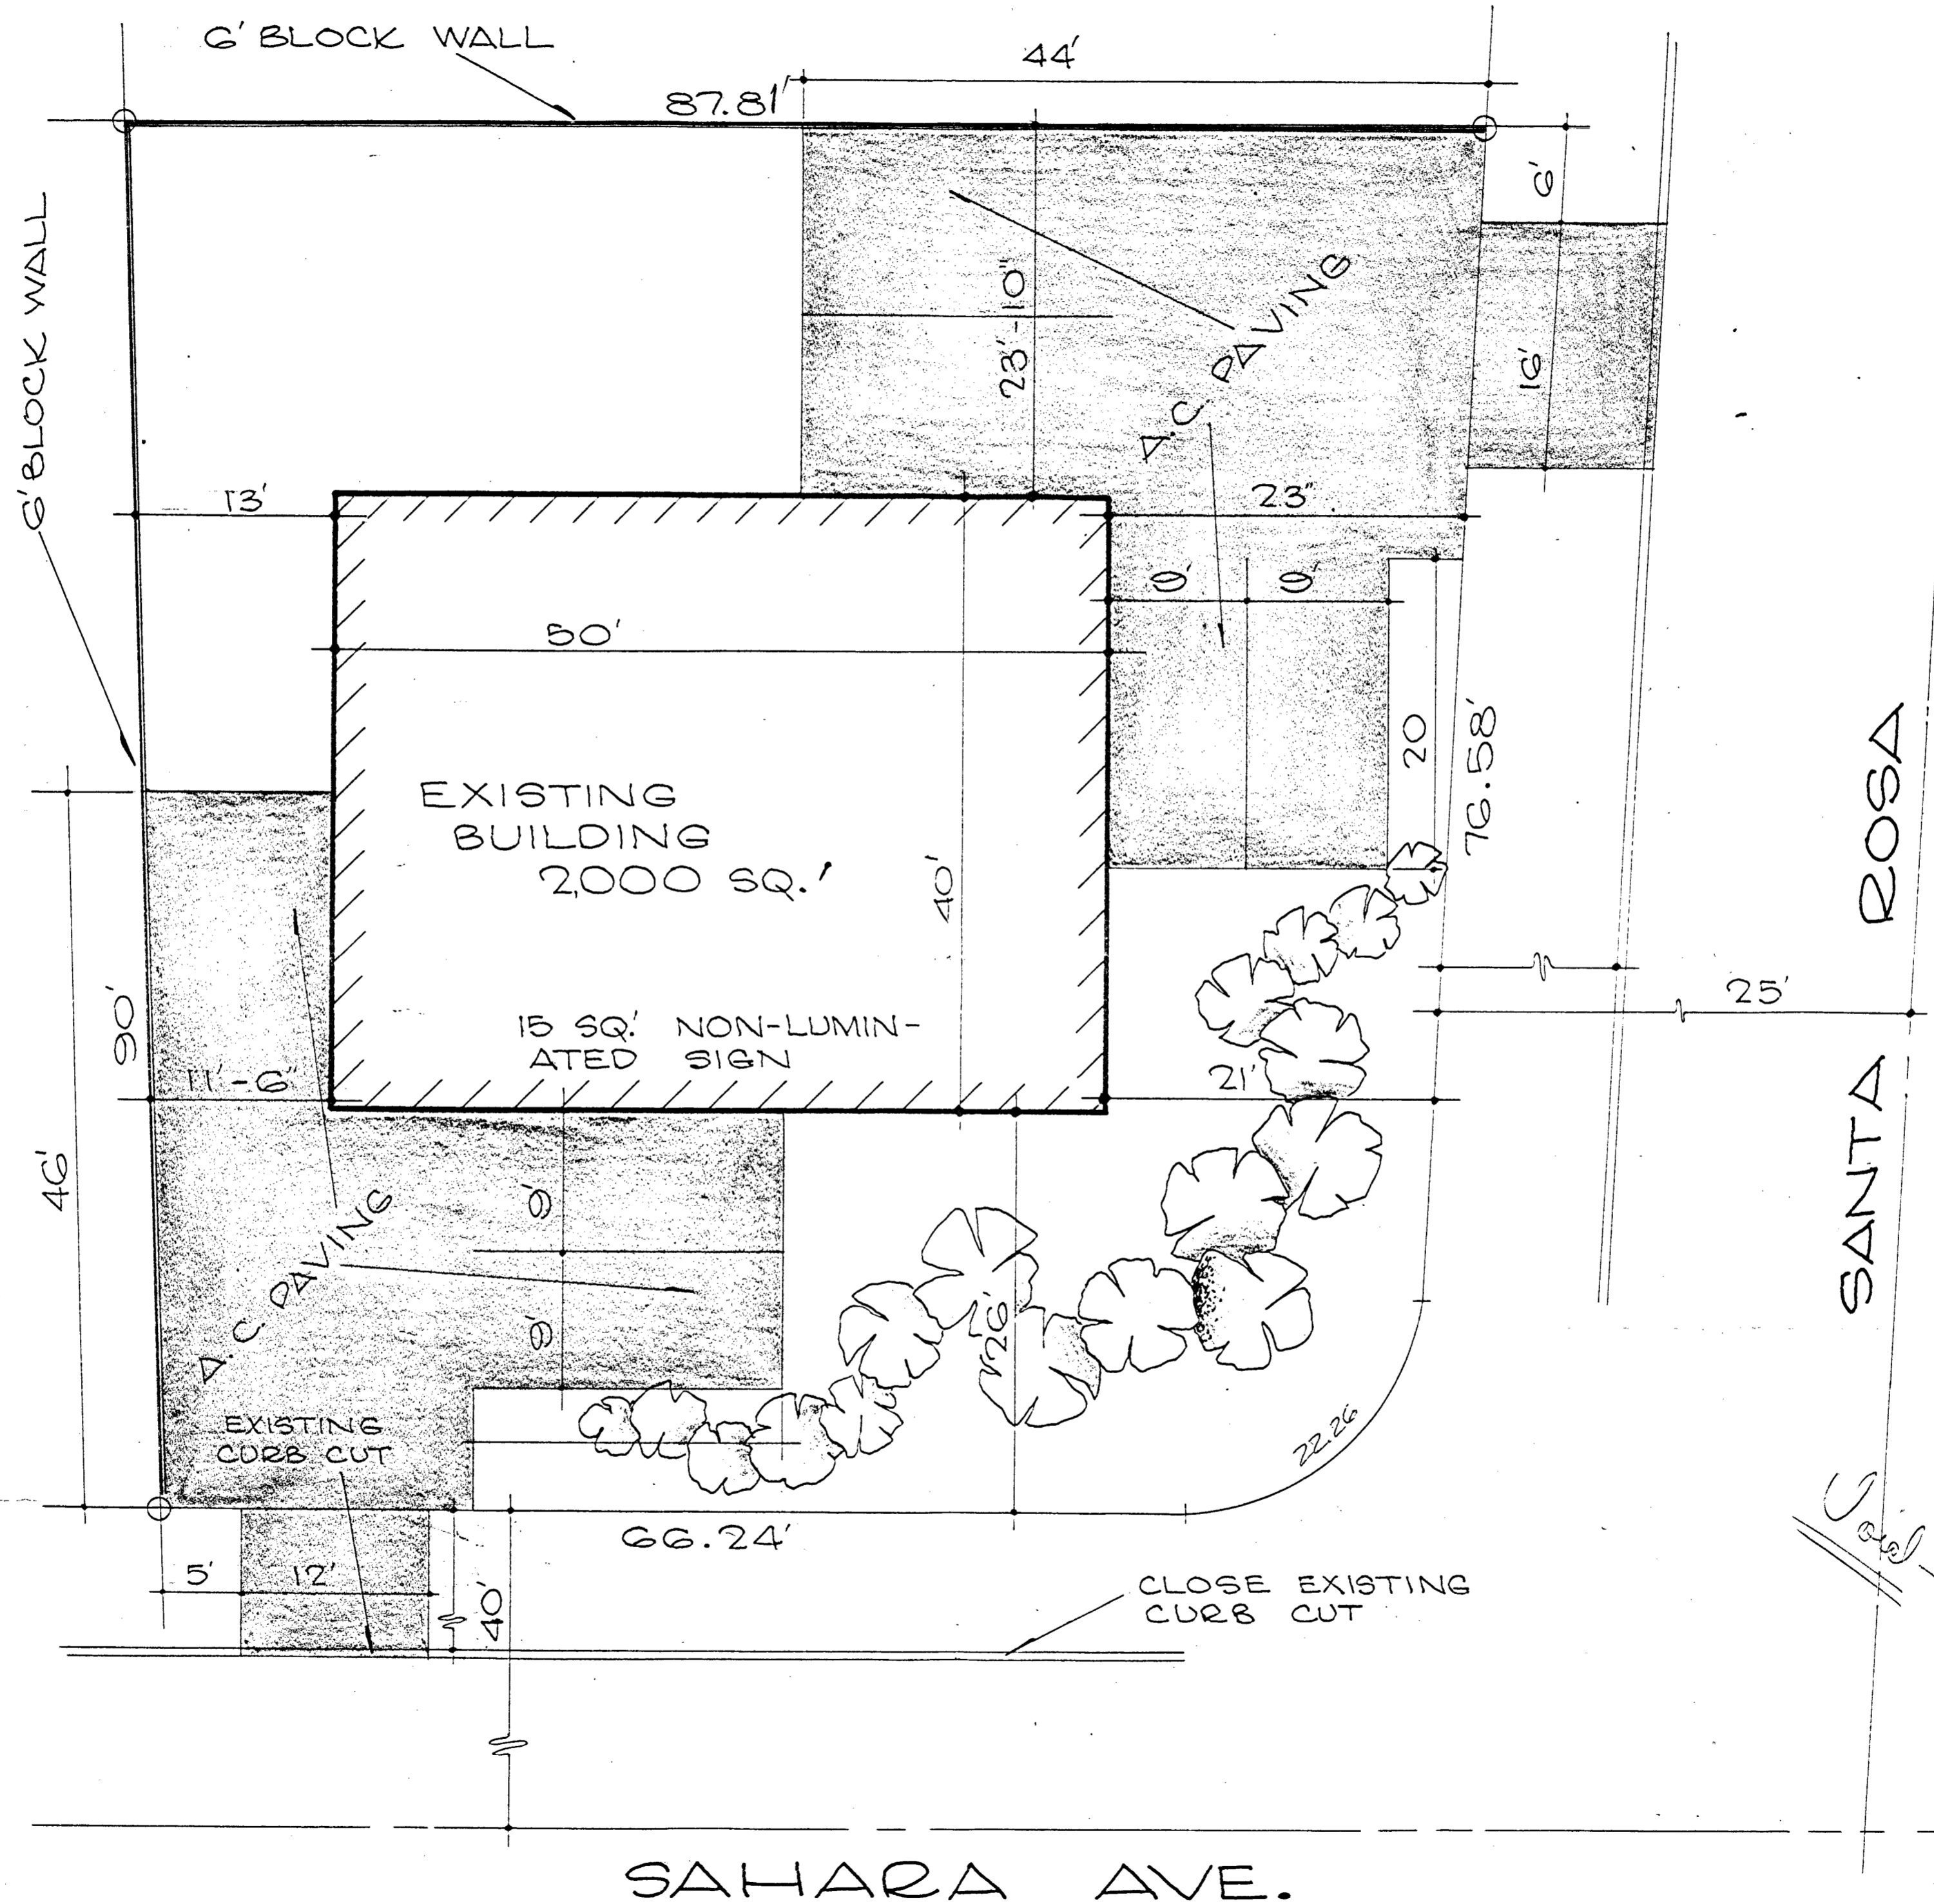

SCALE 1/8" = 1'

*Close Existing  
Curb Cut  
See Plan  
Amended*

65