


73

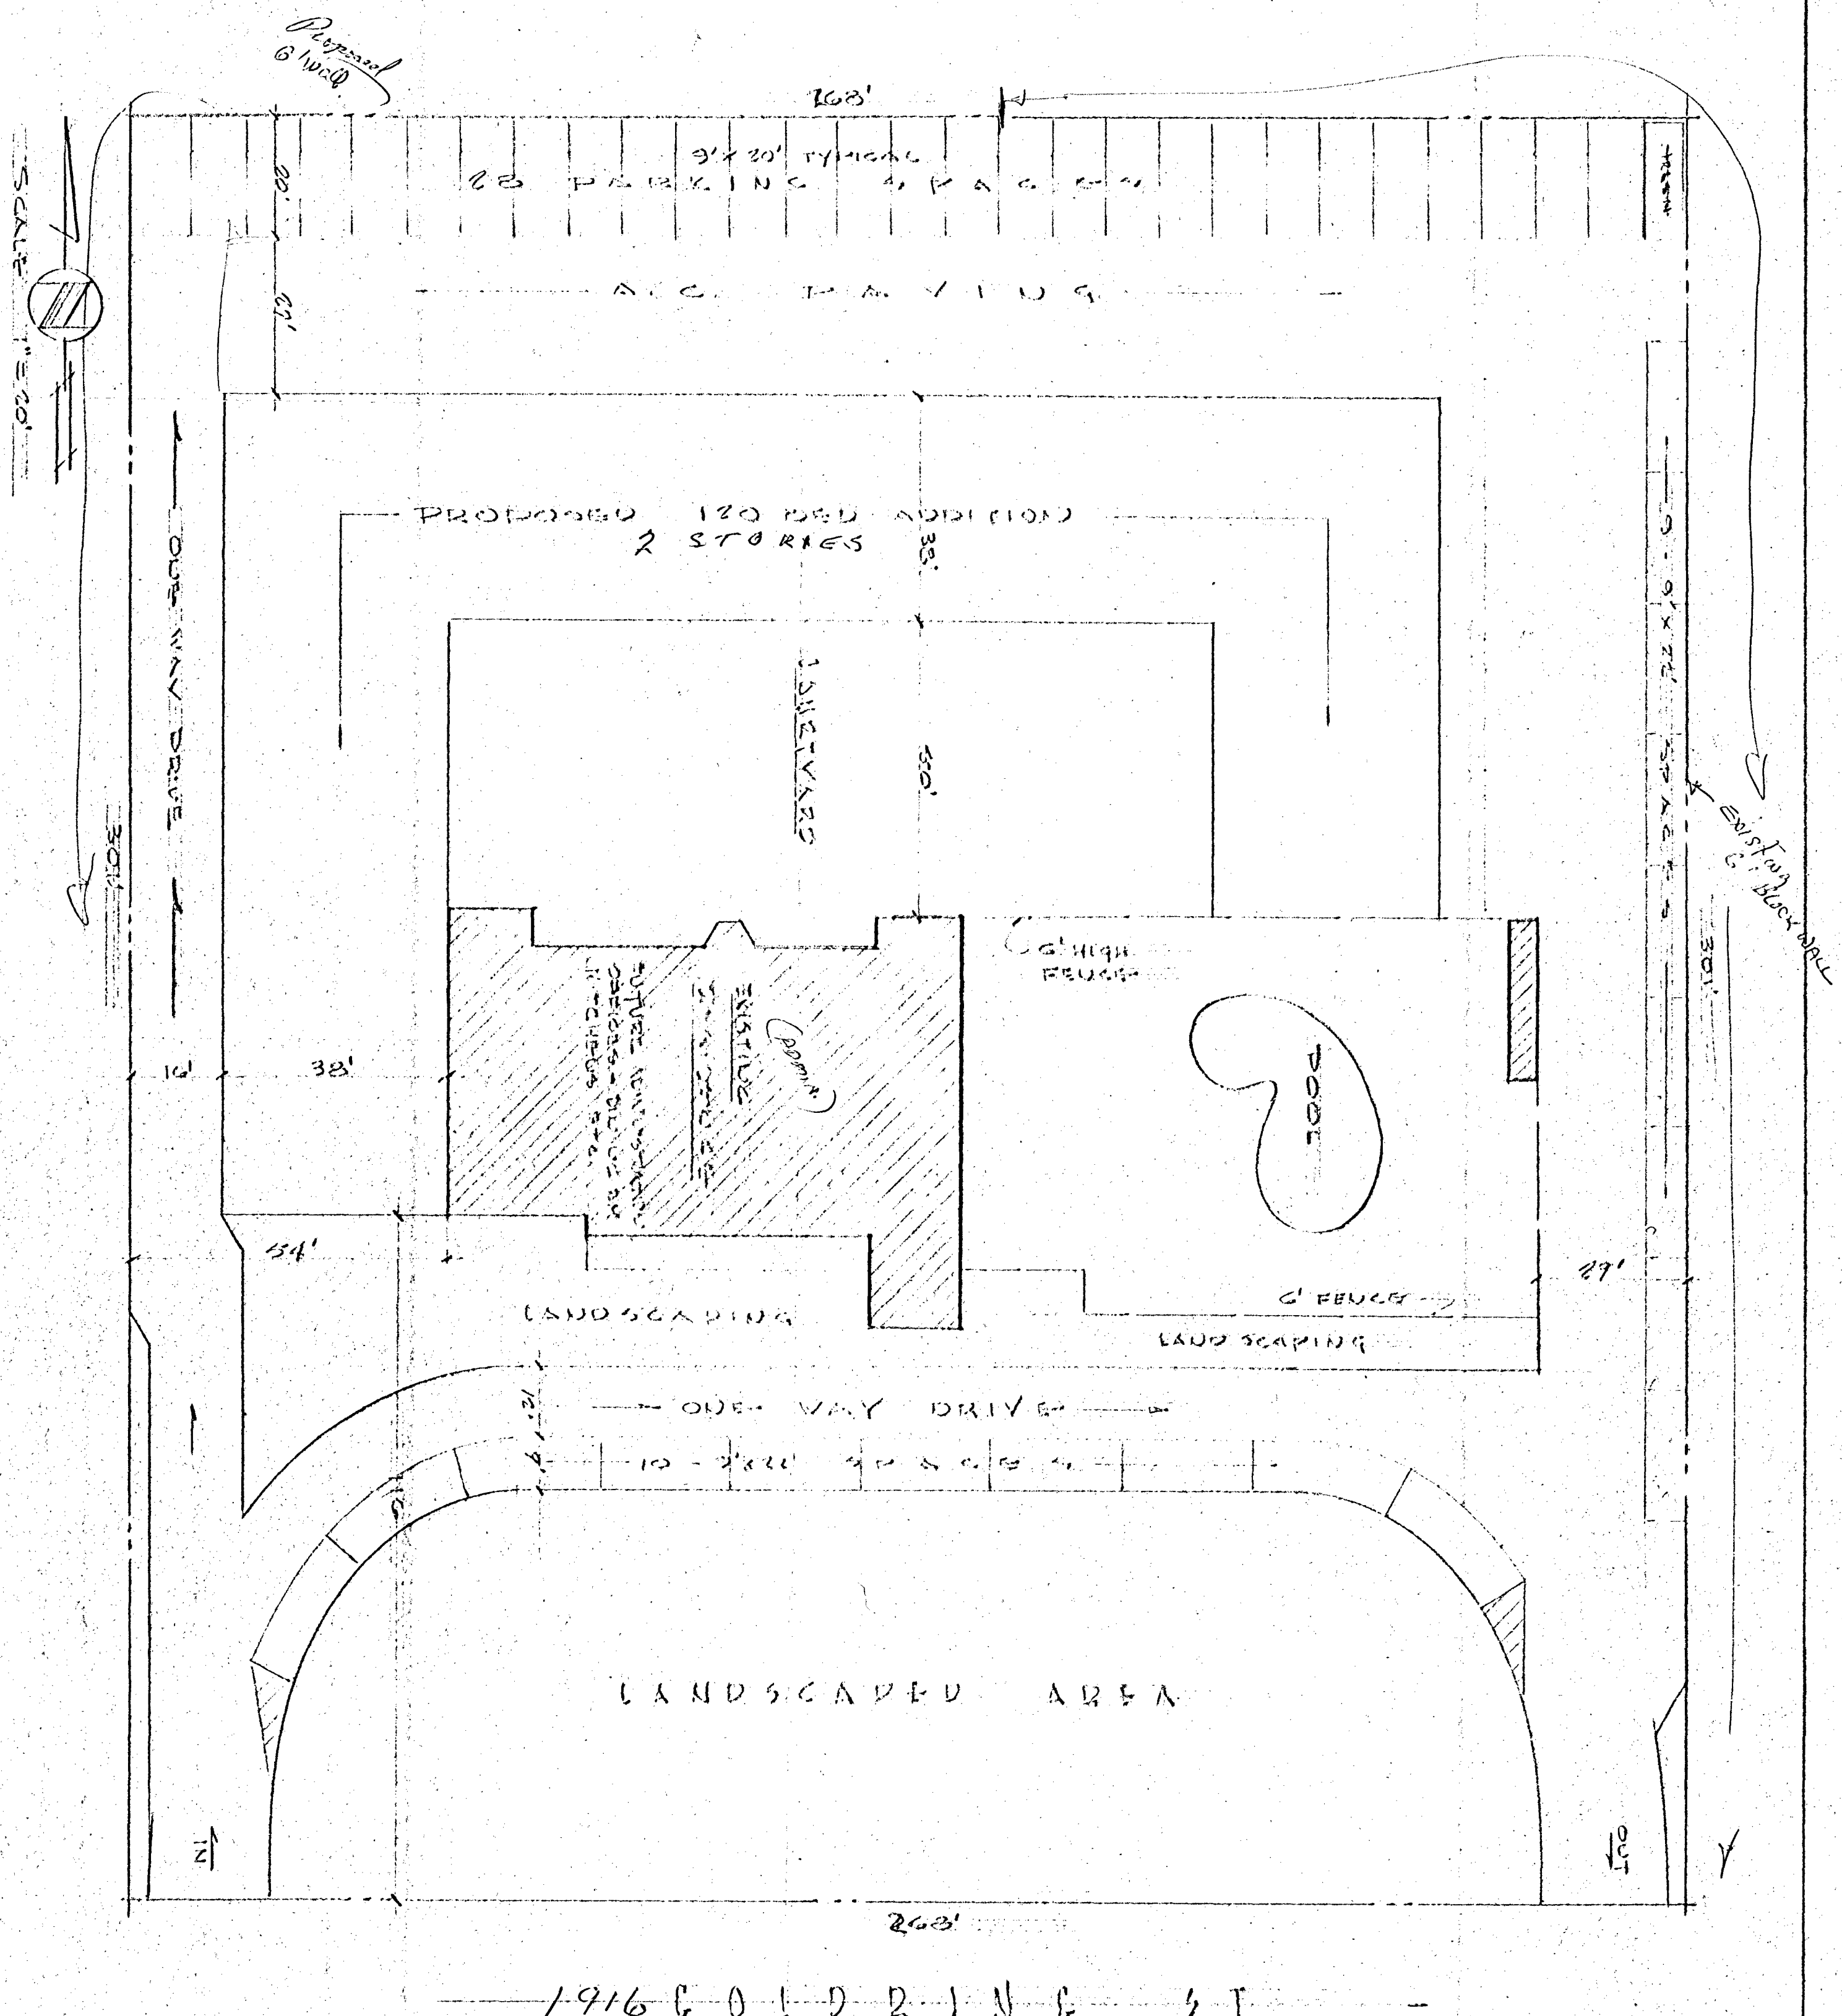

PROPOSED 120 BED ADDITION
 2 STORIES

SCALE 1" = 20'

DR. COMPTON MEMORIAL
 INTERMEDIATE CARE FACILITY
 LAS VEGAS, NEVADA

ALLIED EXECUTIVE INDUSTRIES INC
 3177 SO. HIGHLAND DRIVE - 735-8700
 LAS VEGAS, NEVADA

DATE: 10/27/74
 DRAWN BY: [Signature]
 CHECKED BY: [Signature]