


SHEET NO. 33

SHEET NO. 31

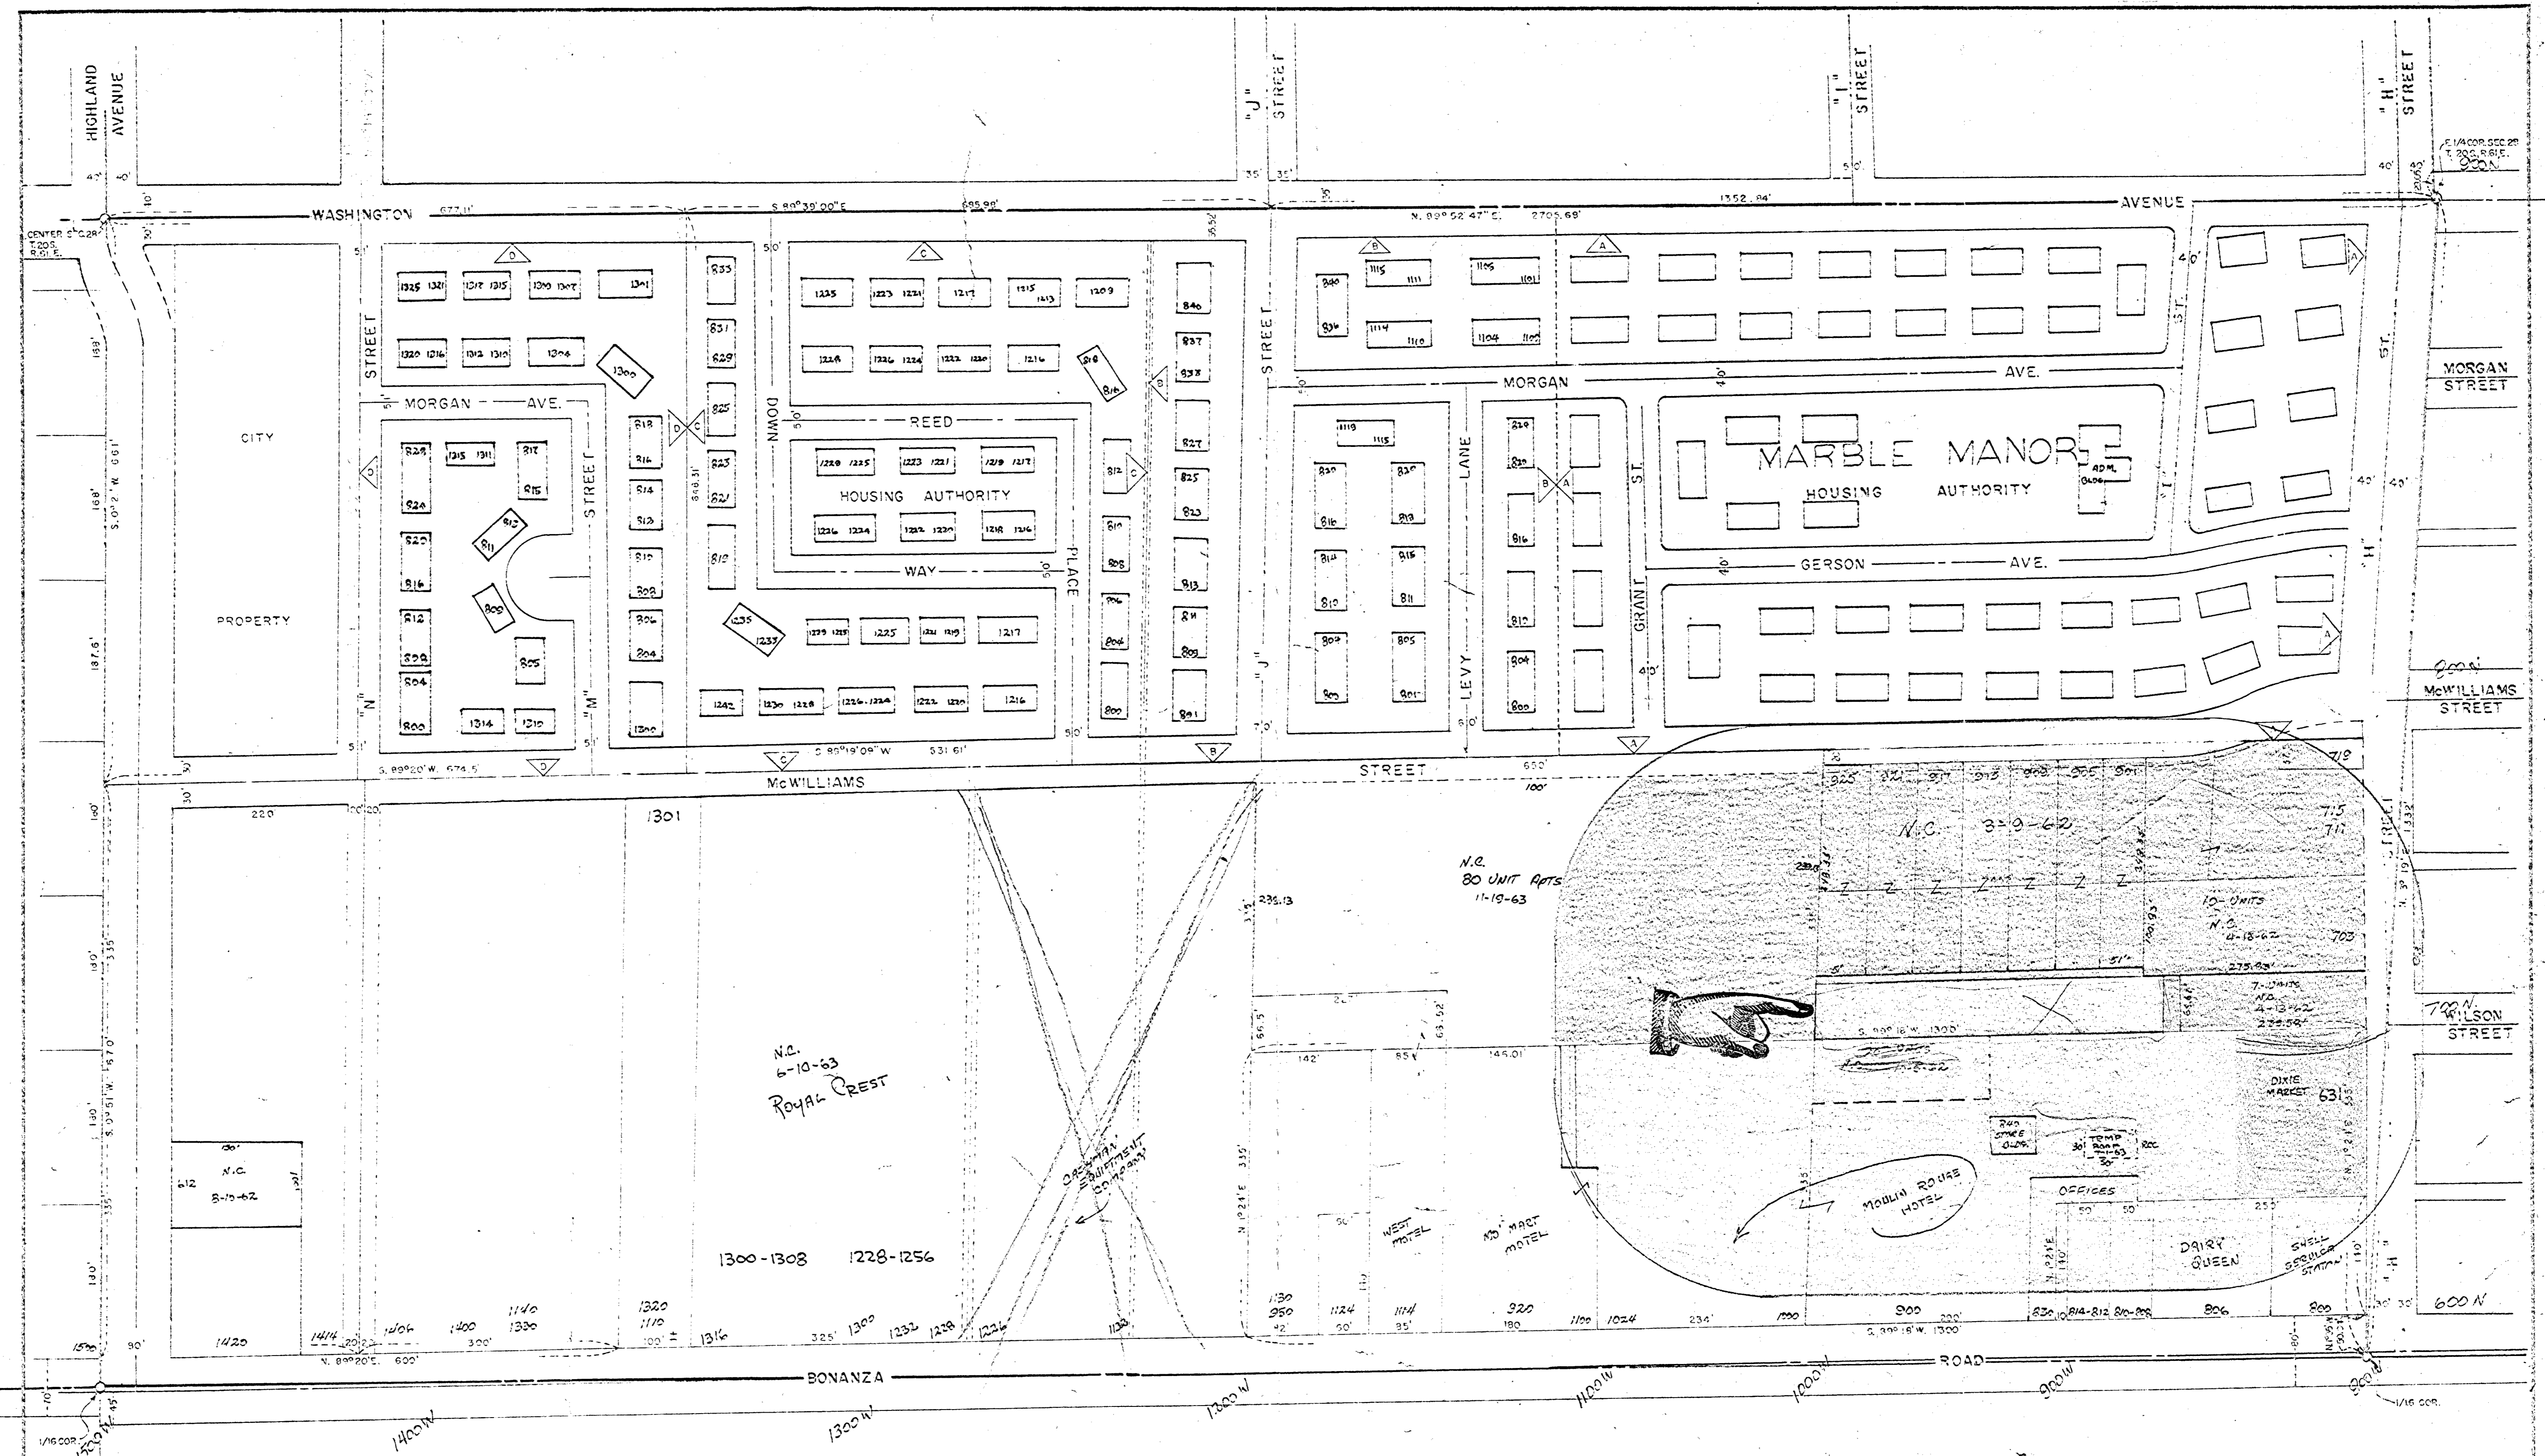

74

Z-74-66

Z-74-66
LEON OXF

N 1/2 SE 1/4 SEC. 28 T20S, R61E

CITY OF LAS VEGAS NEVADA
ENGINEERING DEPT.

DISTRICT MAP-SHEET NO. 40

- ▲ MARBLE MANOR, UNIT 2-1
- ▲ MARBLE MANOR, UNIT 2-2
- ▲ MARBLE MANOR, UNIT 2-3
- ▲ MARBLE MANOR, UNIT 2-4

DESIGNED BY	DATE	SCALE	1" = 100'
DRAWN BY E.P.		FIELD BOOK NO.	
CHECKED BY		WORK ORDER NO. 492	
APPROVED		DRAWING NO.	
CITY ENGR.			