


Contact info for Gordie on Plaza Security - Greyhound
 also for EMT to Gordie - Gas Station


PARKWAY
 CENTER

Command 102
 Metro, Security, Production

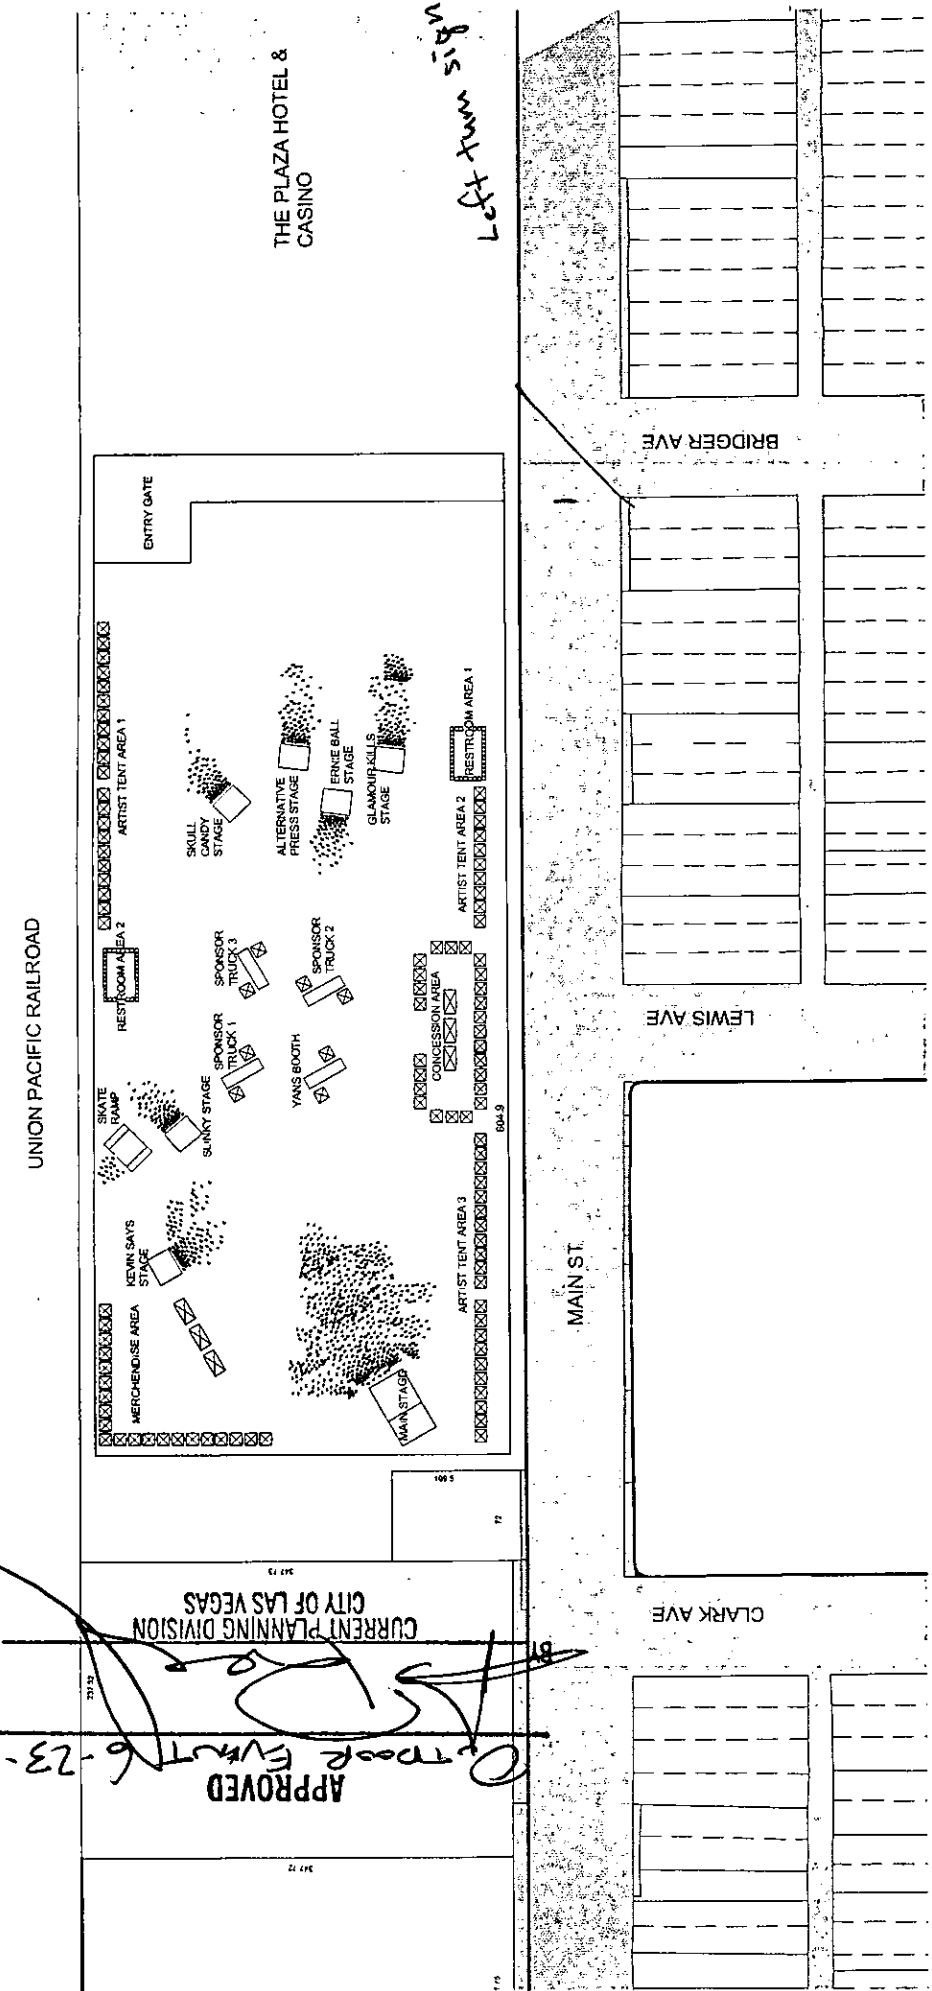

WARPED TOUR LAY-OUT (LAS VEGAS)


SCALE: 1"=100'

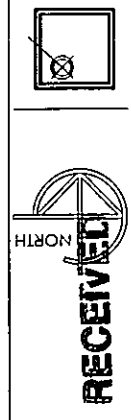

JUN 23 2011
 City of Las Vegas

JUNE 30, 2011

8pm - Midnight

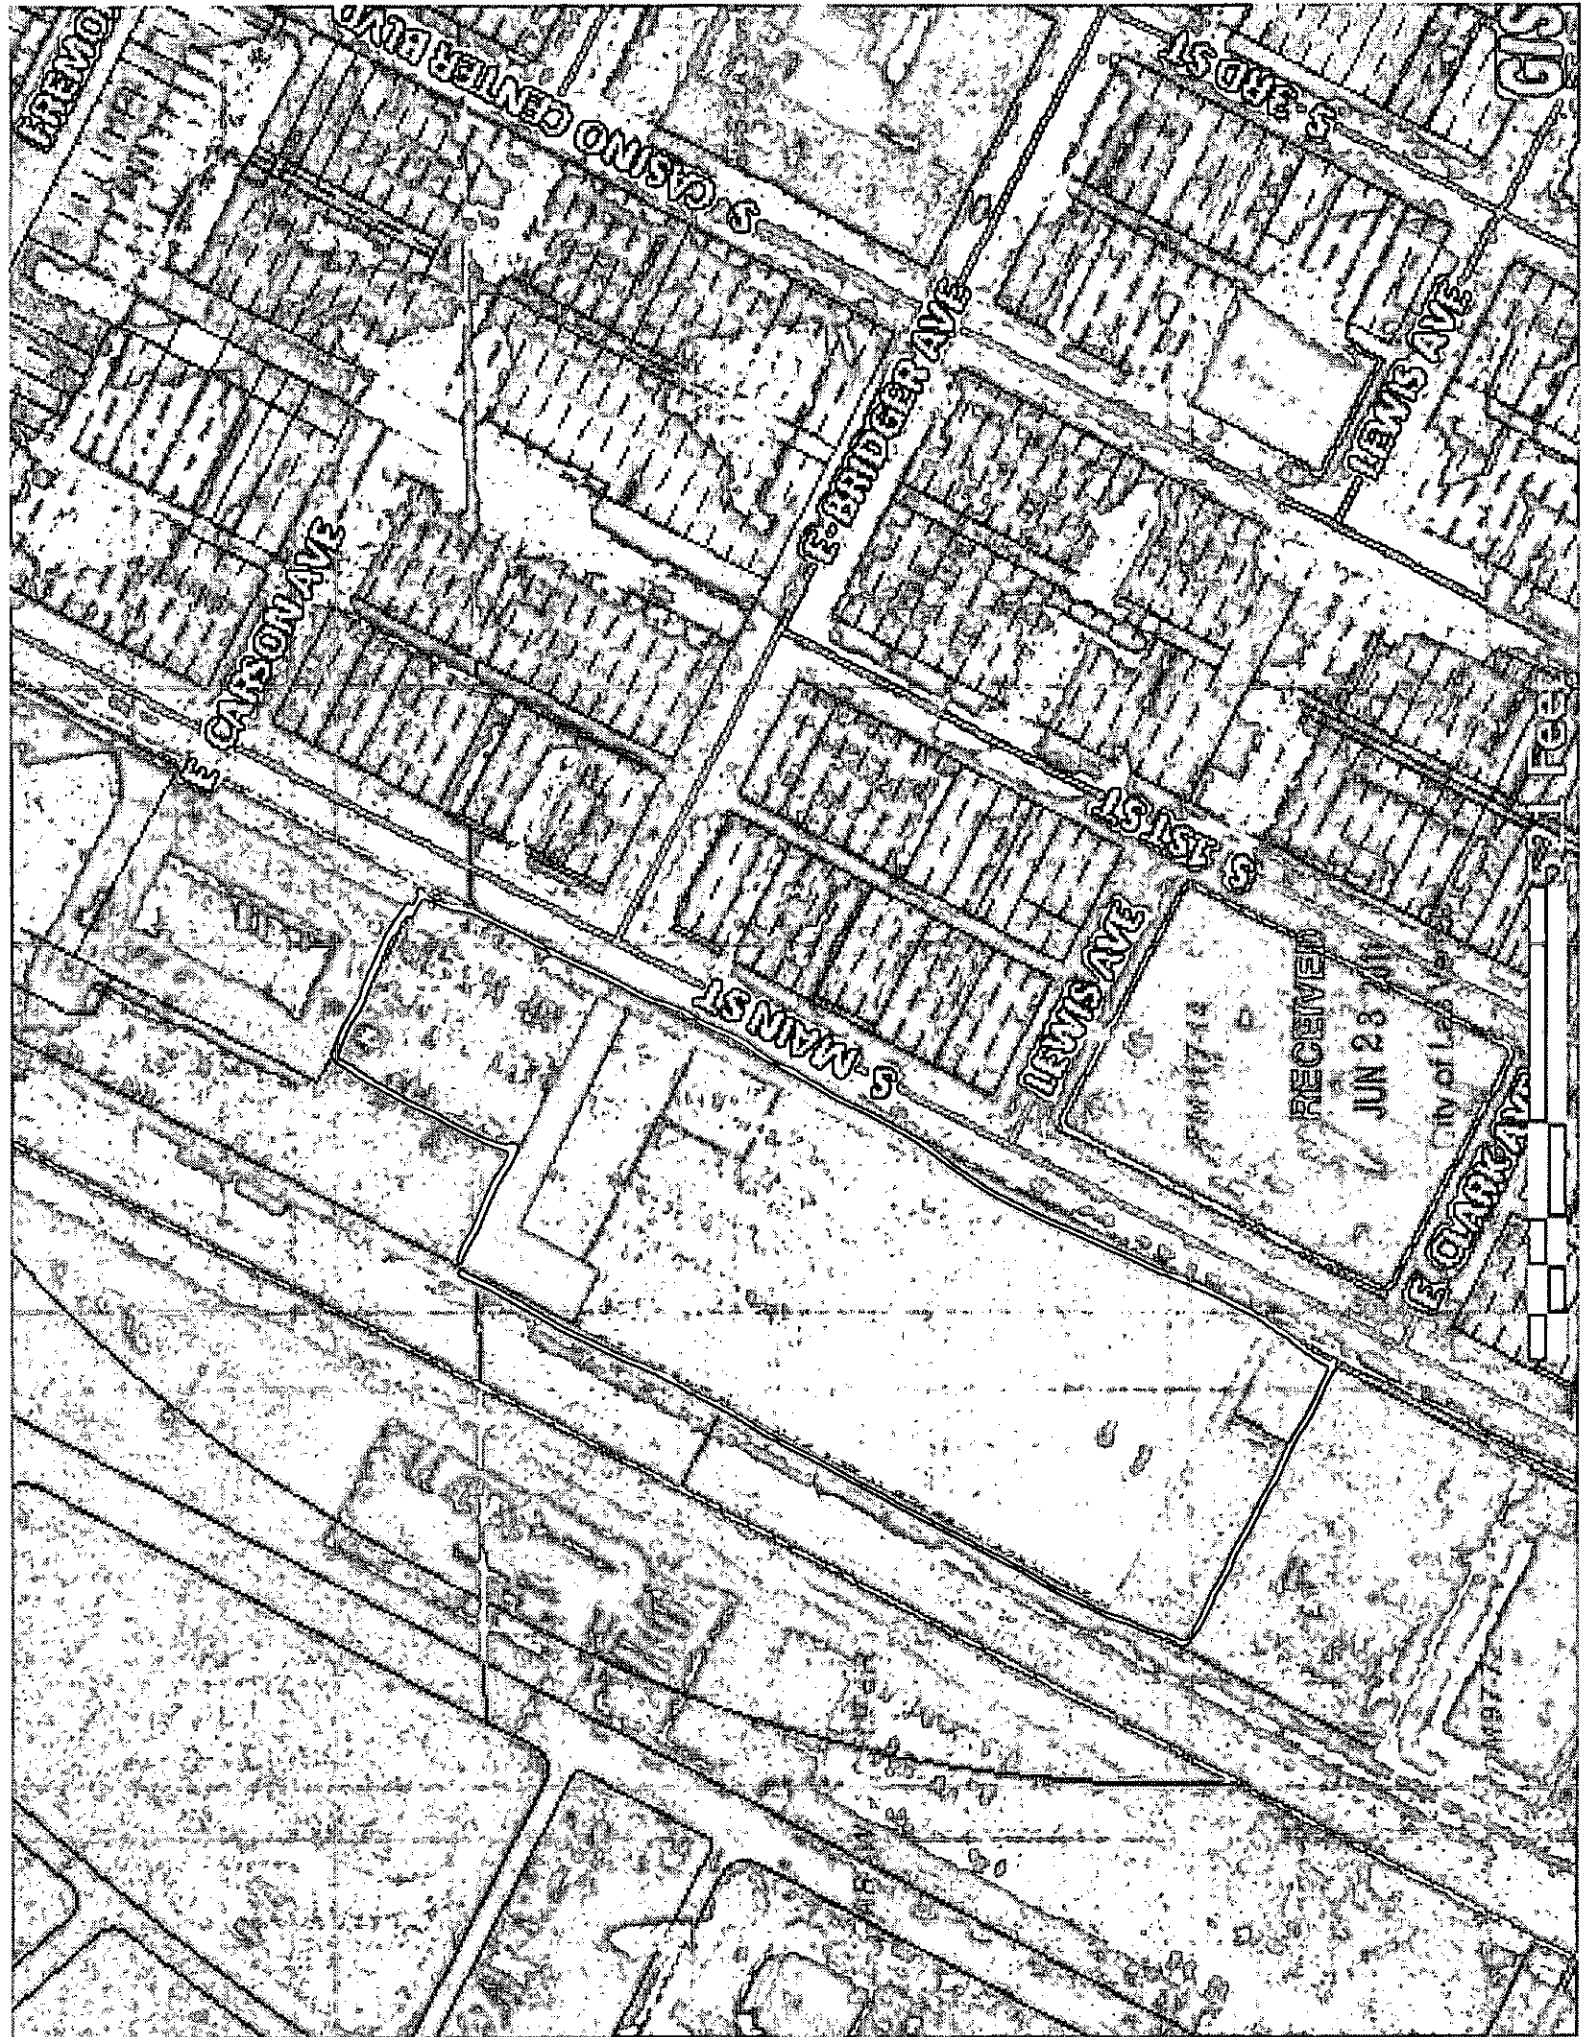




June 23, 2011

Re: Temporary commercial permit for June 30, 2011 event


To whom it may concern:

This is to certify that Mr. Jeffrey J. Hennessy has the authority to sign on behalf of the Plaza Hotel & Casino. If you have any questions please don't hesitate to contact my office 702-386-2110.

Thanking you in advance,

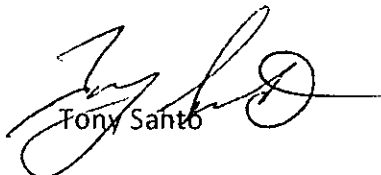

Tony Santo

CEO, PlayLV Gaming Operations

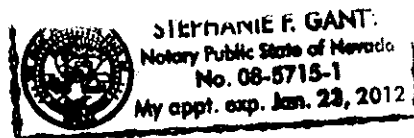

Stephanie F. Gant
June 23, 2011
Nevada, Clark

RECEIVED
JUN 23 2011
City of Las Vegas

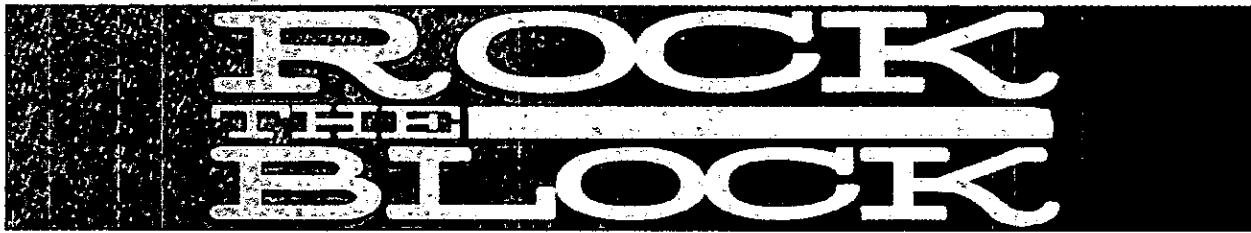

SUBMITTAL FOR TEMPORARY COMMERCIAL PERMIT

Event date: JUNE 30, 2011
Event name: Vans Warped Tour
Event location: PLAZA HOTEL & CASINO PARKING LOT
1 SOUTH MAIN STREET
Event time: 11 am to 10 pm

June 30th Vans Warped Tour is featuring 3OH!3, The Devil Wears Prada, Gym Class Heroes, Less Than Jake, Paramore, A Day To Remember, Jack's Mannequin which are very popular bands in the Pop/Rock/Alternative niche. We were able to secure this festival by beating out other Hotel & Casinos on the strip. The festival consists of 80+ bands and is touring nationally in the United States & Canada. Entry will be off Main Street for the event.

Brief History of Events Downtown: Rock the Block November 17, 2007 was the first ticketed event held in the Fremont East Entertainment District since opening in August 2007. The second installment of Rock the Block was held on July 4, 2008 and was a free show. Without the Rock the Block series that have taken place the Vans Warped Tour would not have recognized downtown as a potential venue.


Entertainment for Rock the Block has included Everlast, Flyleaf, Smile Empty Soul, Franky Perez, Left Standing, Dropkick Murphys, Papa Roach, Gogol Bordello, Hoobastank, A Day To Remember, Searchlight, Death by Stereo and more. Sponsors of the events have been The El Cortez Hotel and Casino, Jagermeister, Miller Lite, Hennessy's Tavern, Downtown Cocktail.

Several thousand people have attended the past events.

Past Advertising included print and radio which specifically consisted of:

- City Life, Las Vegas Weekly, Vurb Magazine, Smash Mag, Vegas Rocks
- KOMP 92.3 FM, Xtreme 107.5 FM, Area 108, MIX 94.1, Jack FM
- 3 electronic billboards (2 on I-15 North and 1 on 215 & Eastern)
- 35,000 postcard size fliers and email blasts

Thanking you in advance

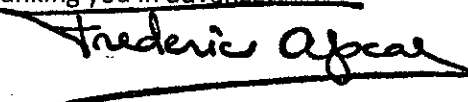
Frederic Aparcar

RECEIVED
JUN 23 2011
City of Las Vegas



**TEMPORARY COMMERCIAL PERMIT
FESTIVAL
TCP-42256**

Valid June 30, 2011 To June 30, 2011



Description of Event: TCP-42256 - Temporary commercial permit for the Vans Warped Tour. The Vans Warped Tour is a concert tour that be located in the parking lot of the Plaza Hotel located at 1 S Main Street on June 30th 2011 from 11AM to 10PM. Setup and takedown will occur on June 30th, 2011. The event will include seven stages, restrooms, tables, food sales with live entertainment.

Applicant: Michael Pergolini
1 S Main Street
Las Vegas, NV 89101
(702)885-1586 x

Parcel(s): 139-34-101-006
Ward(s): WARD 5 (RICKI Y. BARLOW)

THIS PERMIT IS APPROVED PURSUANT TO SECTION 19.18.100 OF THE LAS VEGAS MUNICIPAL CODE, SUBJECT TO THE FOLLOWING CONDITIONS:

See page 2 for conditions

THIS TEMPORARY COMMERCIAL PERMIT IS NOT VALID UNTIL THE FOLLOWING DEPARTMENT APPROVALS / PERMITS / LICENSES HAVE BEEN OBTAINED:

☐ FIRE _____ (Initials)

☐ BUSINESS SERVICES _____ (Initials)

☐ SEWER _____ (Initials)

☐ TRAFFIC _____ (Initials)

THIS PERMIT SHALL BE POSTED IN A CONSPICUOUS PLACE



TEMPORARY COMMERCIAL PERMIT FESTIVAL TCP-42256

Valid June 30, 2011 To June 30, 2011



1. BUSINESS HOURS SHALL BE FROM 11 Am TO 10 PM
2. THIS PERMIT IS NOT A BUSINESS LICENSE.
3. THIS PERMIT IS NOT A SUBSTITUTE FOR ANY REQUIRED STATE OR LOCAL BUSINESS LICENSE OR FOR ANY REQUIRED CHARITABLE SOLICITATION PERMIT.
4. This use shall not create a nuisance to nearby properties as a result of factors such as excessive illumination, glare, noise, vibration, smoke, dust, dirt, odors, gases or heat.
5. The use shall conform to the submitted plot plan date stamped 6-23-11
6. No combustible materials shall be located within 50 feet of any structure on, or adjacent to this site.
7. No building or structure of any type shall be erected closer than 25 feet from any property line.
8. The applicant shall display a copy of this Temporary Commercial Permit during the hours of operation.
9. Sanitation facilities must be provided in accordance with the Clark County Health District and Republic Services of Southern Nevada.
10. The applicant shall provide private security officers as required by the Las Vegas Metropolitan Police Department.
11. Any signage for this temporary commercial use must be approved and permitted by the Planning and Development Department.
12. All applicable City code requirements shall be satisfied.
13. The applicant shall be responsible for leaving the site free of debris, litter or any other evidence of occupancy upon completion or removal of the use.

6-23-11

PLANNING SUPERVISOR SIGNATURE

DATE

PLANNING MANAGER SIGNATURE

DATE

THIS PERMIT SHALL BE POSTED IN A CONSPICUOUS PLACE



PLANNING & DEVELOPMENT DEPARTMENT

APPLICATION / PETITION FORM

Application/Petition For: VANS WARPED TOUR
Project Address (Location) 1 Main Street
Project Name Vans Warped Tour Proposed Use Festival
Assessor's Parcel #(s) 139-34-101-00647 Ward # _____
General Plan: existing ☒ proposed _____ Zoning: existing ☒ proposed _____
Commercial Square Footage _____ Floor Area Ratio _____
Gross Acres 6.35 acres Lots/Units _____ Density _____
Additional Information _____

PROPERTY OWNER T-UPR Contact JONATHAN JOSSEL
Address 1 MAIN STREET Phone: 702-386-2526 Fax: _____
City LAS VEGAS State N.V. Zip 89101

APPLICANT _____ Contact _____
Address _____ Phone: _____ Fax: _____
City _____ State _____ Zip _____

REPRESENTATIVE MICHAEL PERGOLINI Contact V.P. Hotel Operations
Address 1 MAIN STREET Phone: 702-885-1586 Fax: _____
City L.V. State N.V. Zip 89101

Property Owner Signature* Jeffrey J. Hennessy

*An authorized agent may sign in lieu of the property owner for Final Maps, Tentative Maps, and Parcel Maps.


Print Name Jeffrey J. Hennessy

Subscribed and sworn before me

This 22nd day of June, 2011

Stephanie J. Mantel

Notary Public in and for said County and State

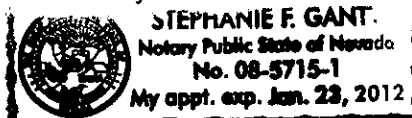

FOR DEPARTMENT USE ONLY

Case # TCP-42256
Meeting Date: ADMIN
Total Fee: \$100
Date Received: 6/23/11
Received By: BJS

* The application will not be deemed complete until the submitted materials have been reviewed by the Planning and Development Department for consistency with applicable sections of the Zoning Ordinance.

RECEIVED
JUN 23 2011
City of Las Vegas



PLANNING & DEVELOPMENT DEPARTMENT

TEMPORARY SIGN PERMIT SUBMITTAL REQUIREMENTS

APPLICATION/PETITION FORM: A completed Application/Petition Form is required. The owner(s) of the real property must sign this form, or submit a Power of Attorney authorizing an agent to sign. A Notary Public must notarize the signature. When the property owner(s) reside outside of Nevada, the signature may be notarized in another state.

JUSTIFICATION LETTER: A detailed letter that explains the request, includes the proposed dates, type and quantity of balloons, inflated devices, searchlights, pennants, portable signs, streamers and other similar devices.

FEES: \$100.

ALL PLANS SUBMITTED MUST BE NO SMALLER THAN 11x17 AND NO LARGER THAN 24x36.

SITE PLAN: (2 folded) Draw to scale and make legible: the entire subject parcel(s), all proposed and existing structures, utility easements and locations, signage, and adjacent streets. Site Plans must include:

- | | | |
|--|---|---|
| ☐ PROPERTY LINES CALLED OUT | ☐ ADJACENT LAND USES/STREETS | ☐ VICINITY MAP |
| ☐ DIMENSIONS (ACTUAL)/SCALE | ☐ LANDSCAPE AREAS | ☐ NORTH ARROW |
| ☐ STREET NAMES | ☐ SCALE | ☐ INGRESS/EGRESS |
| ☐ PARKING SPACES | ☐ LOCATION OF SIGNS | |

SIGN ELEVATIONS: (2 folded) Draw and make legible all proposed temporary signs on site. **Photographs may be submitted in lieu of detailed drawings.** Building Elevations must include:

- | | |
|---|--|
| ☐ SIGN MATERIALS & COLORS CALLED OUT | ☐ SIGN DIMENSIONS/SCALE |
|---|--|