



1 mile walk

UnitedHealthcare Tenaya Way Campus

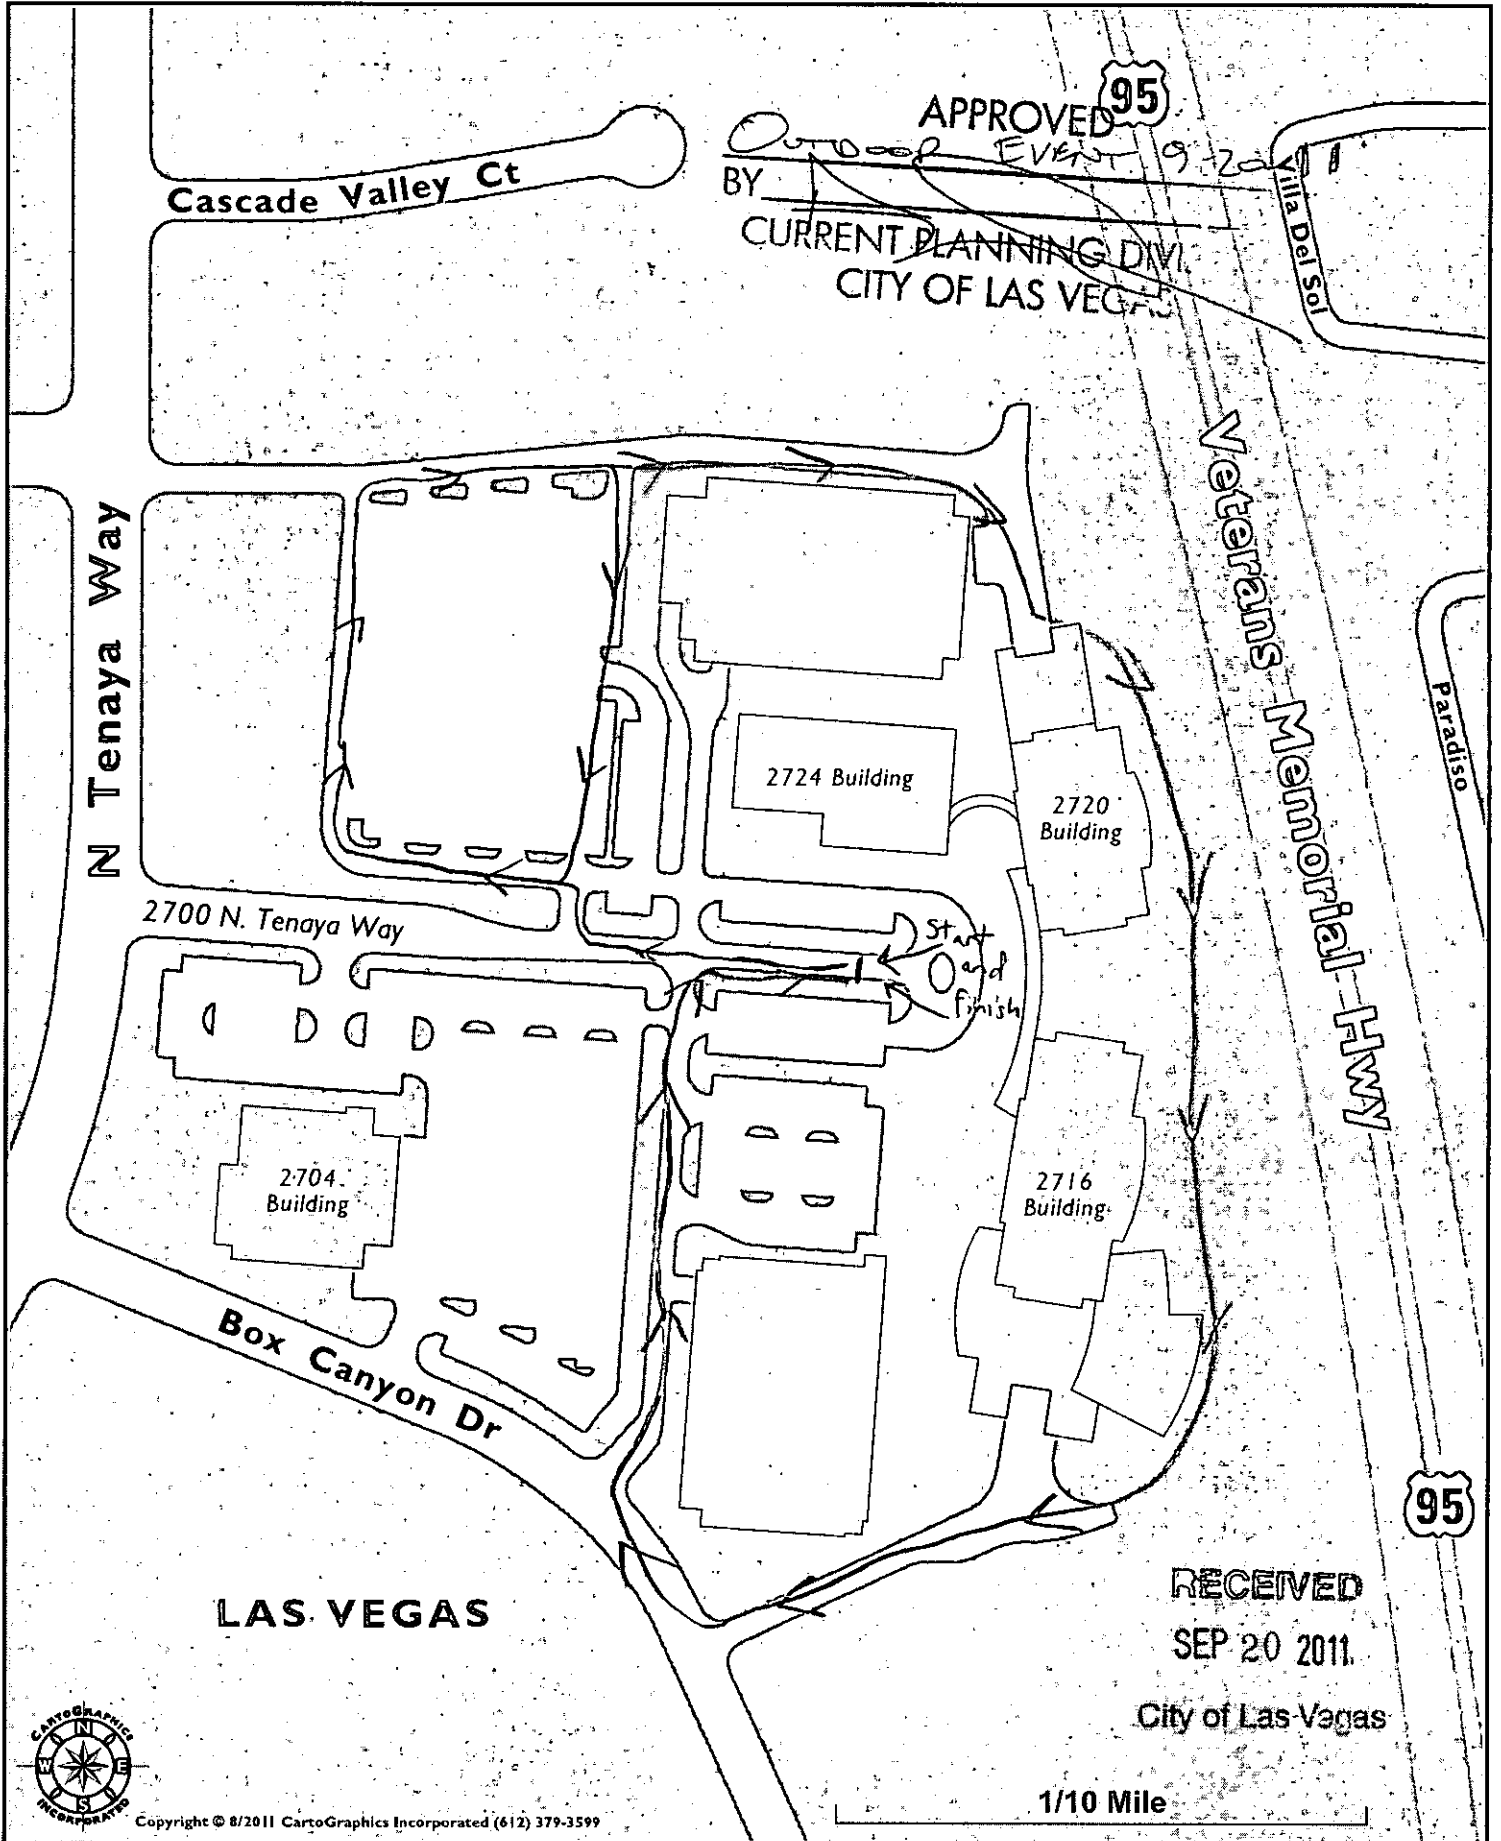

HIGHWAY
TECHNOLOGIES
 4535 COPPER SAGE ST
 LAS VEGAS, NV 89118
 TEL: 702-453-1616
 FAX: 702-453-2281
 michael.bower@hwy-tech.com

Legend
 42" CONE

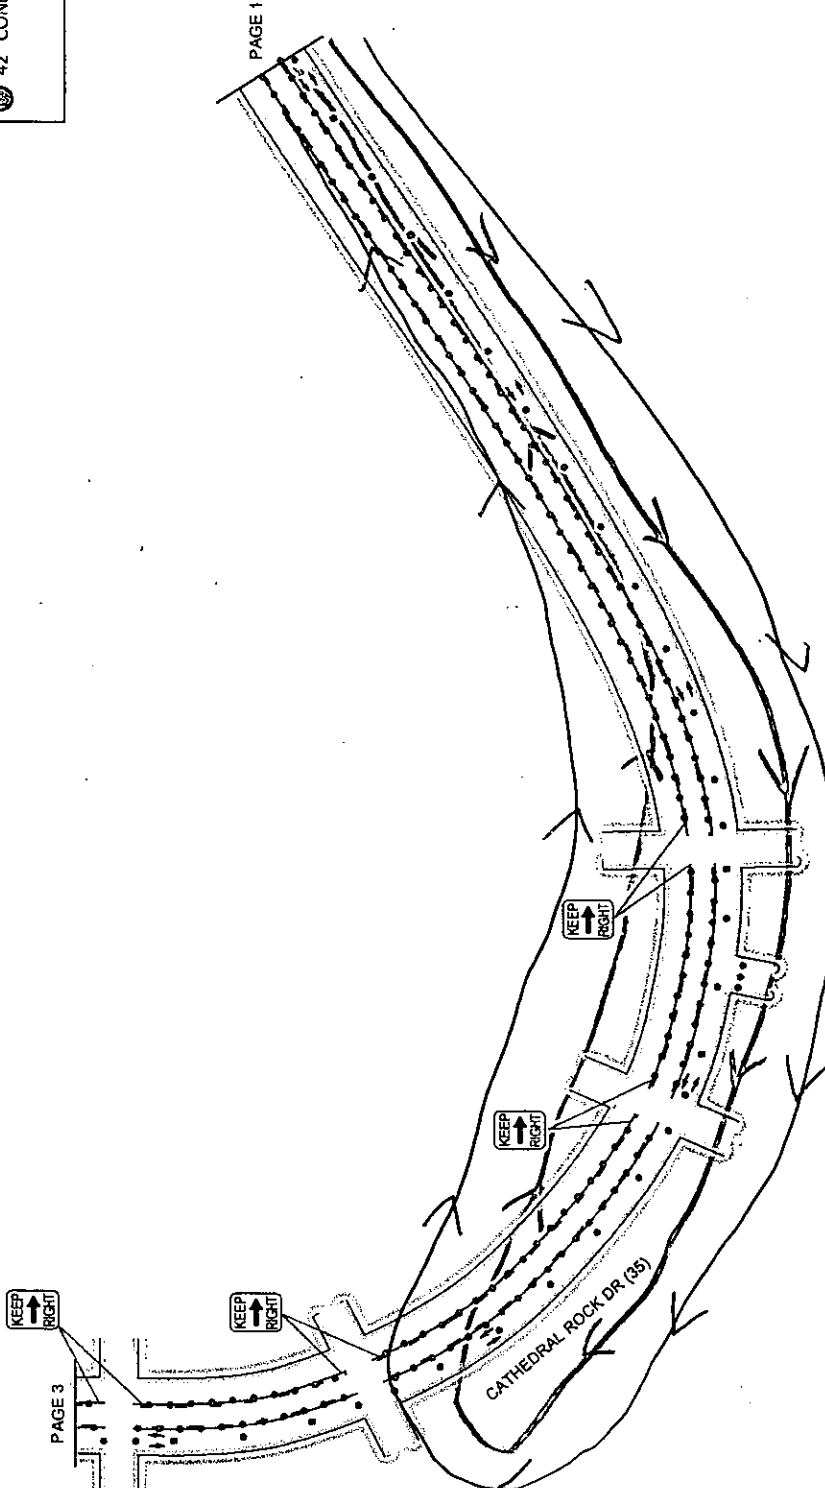

RECEIVED

SEP 20 2011

City of Las Vegas

TYPICAL DRIVEWAY

NOTE: ANY SCHEDULING OF EQUIPMENT MUST BE DONE THROUGH HIGHWAY TECHNOLOGIES CUSTOMER CARE OFFICE @ 702-453-1616

UNITED HEALTHCARE TEDDY BEAR RUN

CONTACT: DENNIS PITMAN
 PHONE: 877-238-0045 X-65910
 LOCATION: BOX CANYON DR & TENAYA WAY
 START DATE: 8-17-11 DURATION: 1 DAY
 WORK TYPE: SPECIAL EVENT
 HOURS OF OPERATION: DAY

AUTHOR: Mike Bower
 ATSSA: 43191
 MAP PAGE: 33-B-8
 DATE: 8-17-11
 PAGE: 2
 SCALE: NONE
 GOV. AGENCY: CLV


NOTES:
1. ANY CONFLICTING SIGNS WILL BE COVERED FOR THE DURATION OF THE WORK.
 2. ACCESS FOR EMERGENCY VEHICLES WILL BE MAINTAINED AT ALL TIMES.
 3. ALL EXCAVATIONS WITHIN 18" OF TRAVEL LANES DEEPER THAN 18" SHALL BE PROTECTED BY CONTRACTOR.
 4. CONTRACTOR SHALL MAINTAIN TWO (2) 12' SMOOTH DIRT FREE DETOUR LANE AT ALL TIMES.
HIGHWAY
TECHNOLOGIES
 4535 COPPER SAGE ST
 LAS VEGAS, NV 89118
 TEL: 702-453-1616
 FAX: 702-453-2281
 michael.bower@hwy-tech.com

5K Run

UnitedHealthcare Tenaya Way Campus

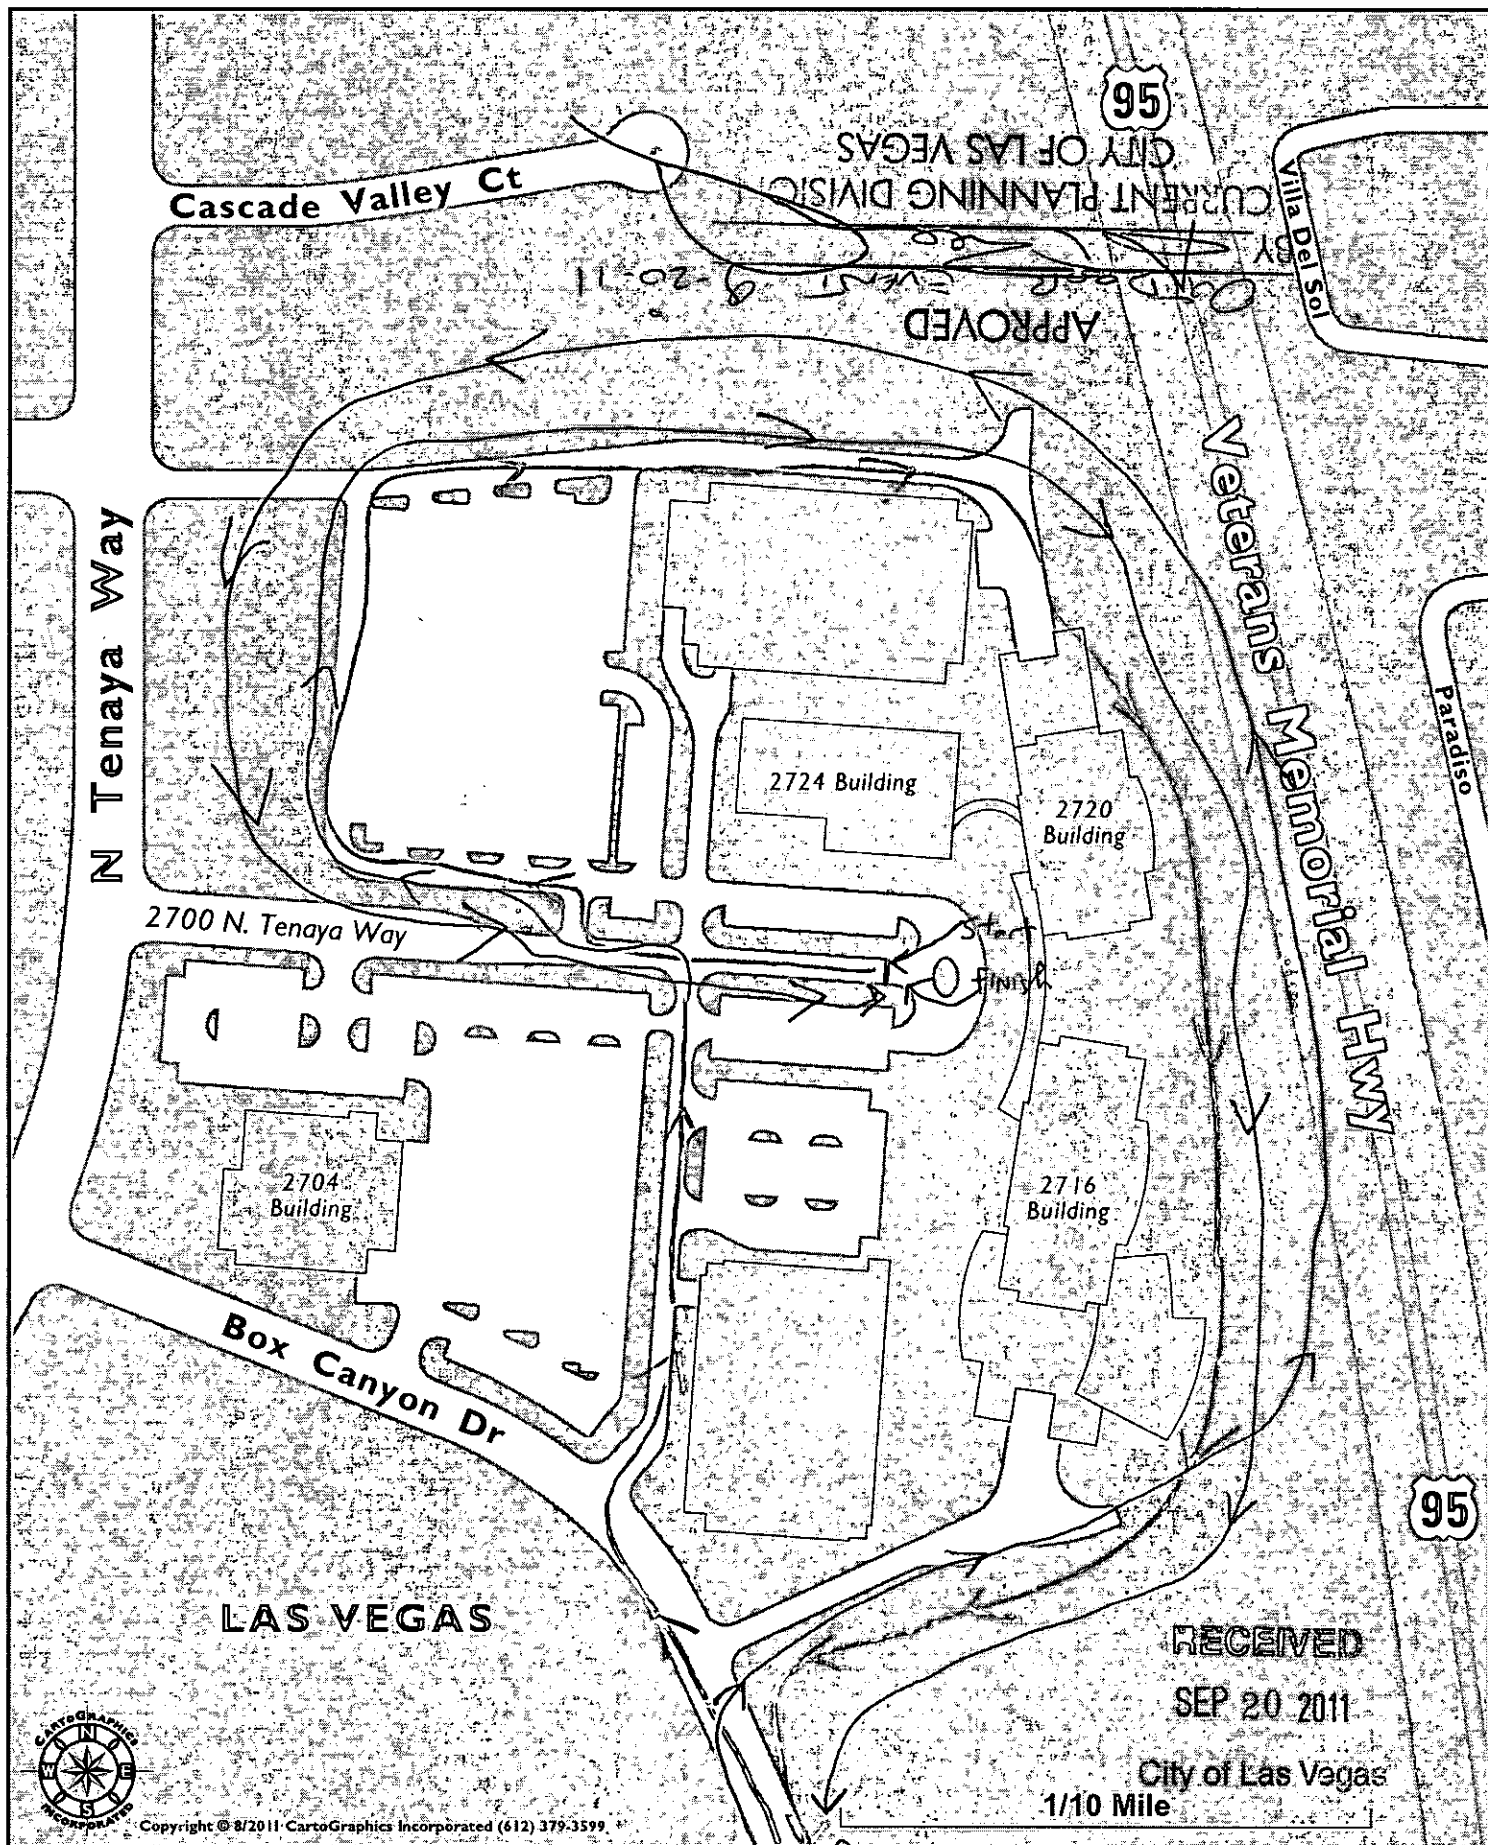

— LAP 1
— LAP 2

Page 2 to Box Canyon

1



DEPARTMENT OF PLANNING

APPLICATION / PETITION FORM

Application/Petition For: United Health Care Childrens Foundation
 Project Address (Location) 2716 N. Tenaya Ave.
 Project Name UHC 5k run Proposed Use 11
 Assessor's Parcel #(s) 138-15-710-023 Ward #
 General Plan: existing XX L/R proposed Zoning: existing XX C-9B proposed
 Commercial Square Footage n/a Floor Area Ratio outside
 Gross Acres approx 15 Lots/Units Density
 Additional Information We are organizing a 5k on our property here at United Healthcare.

PROPERTY OWNER United Healthcare Contact Mike Schramm
 Address 2716 N. Tenaya Ave Phone: 2427540 Fax:
 City Las Vegas State NV Zip 89134
 E-mail Address mike.schramm@uhc.com

APPLICANT United Healthcare Contact Mike Schramm
 Address 2716 N. Tenaya Ave Phone: 2427540 Fax:
 City Las Vegas State NV Zip 89134
 E-mail Address mike.schramm@uhc.com

REPRESENTATIVE United Healthcare Childrens Fdtn Contact Mike Schramm
 Address 2716 N. Tenaya Ave Phone: 2427540 Fax:
 City Las Vegas State NV Zip 89134
 E-mail Address mike.schramm@uhc.com

Property Owner Signature [Signature]

* An authorized agent may sign in lieu of the property owner for Final Maps, Tentative Maps, and Parcel Maps.

Print Name Donald J. Francursio


Subscribed and sworn before me

This 9 day of September, 20 11

[Signature]

Notary Public in and for said County and State

Revised 10/27/08

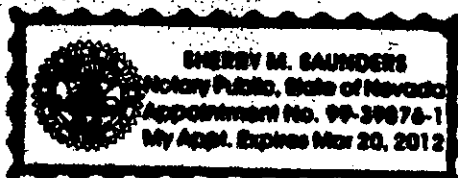

FOR DEPARTMENT USE ONLY

Case #	<u>TCP-43280</u>
Meeting Date:	<u>N/A</u>
Total Fee:	<u>\$100</u>
Date Received:	<u>9/19/11</u>
Received By:	<u>[Signature]</u>

The application will not be deemed complete until the submitted materials have been reviewed by the Department of Planning for consistency with applicable sections of the Zoning Ordinance.

Depot Application and Application Form.pdf

PAID

SEP 20 2011

Development Service Center

176923
JC

City of Las Vegas
Department of Planning
ATTN: Greg Kapovich

September 14, 2011

Greg:

Thank you so much for the help in getting our 5k run and 1 mile walk approved.


Enclosed is the following:

1. The "wet" copy of the Application/Petition form, signed by CEO Don Giancursio and notarized.
2. A justification letter
3. A map of the course, a separate map for the 1 mile walk, and then another map for the 5k run.

I also inserted a flyer describing the activity.

Thanks. Any questions, or if I can provide anything else, let me know at 242-7540 or at email mike.schramm@uhc.com

The \$100 check is being sent also from Minnesota to the address noted above, you might have already received it.

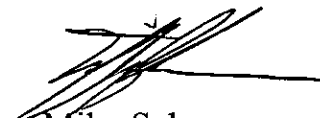

Mike Schramm

RECEIVED

SEP 20 2011

City of Las Vegas

City of Las Vegas
Department of Planning
ATTN: Greg Kapovich

September 14, 2011

To Whom It May Concern:

On September 24, 2011, the UnitedHealthcare Childrens Foundation would like to hold a 5k run and 1 mile walk, with all proceeds raised from the run and walk to be directly given to the foundation to support worthwhile charity causes. 90% of the walk and run will be held on the property located at 2700 N. Tenaya, which is the headquarters of the Nevada division of UnitedHealthcare. The remaining portion of the run will briefly utilize Box Canyon Dr. and Cathedral Rock Dr. We have worked with Highway Technologies for a Traffic plan on this very low utilized road, especially on a Saturday morning. We have contacted the only business that could have business interruptions on that morning, Petroglyph, and they response was, thank you for letting us know, but it will cause no issues on a Saturday morning.

We will utilize the parking facilities at UnitedHealthcare, which will give us ample parking for all participants and spectators.

Our subject site is physically suitable for the type and intensity of our event. We do not expect more than 300 participants, which can be easily handled by our facility, which regularly has over 1,000 employees come to work on a normal work day. There will be adequate public access to the site, as Tenaya provides the easiest access into the site, and traffic on Tenaya will be in no way altered for the event. This application is in no way a continuation of consecutive applications or otherwise an attempt to circumvent the limitations of Title 19.

Thank you so much for consideration of our event.



Dennis Pitman
Race Director

RECEIVED

SEP 20 2011

City of Las Vegas

We have BIG goals and BIG dreams

UnitedHealthcare
Children's Foundation



but we also know our
community has a big ♥

Be a part of the inaugural
UnitedHealthcare Children's
Foundation Teddy Bear 5K
Run and 1 Mile Walk!

**Teddy Bear 5K Run
& 1 Mile Walk**

Date: September 24, 2011
Start Time: 8:00 am
Location: UnitedHealthcare, 2700 N. Tenaya Way, Las Vegas, 89128

Help us support the UnitedHealthcare Children's Foundation and their efforts to provide financial assistance to children who have medical needs.

Register by August 31:	Register after August 31:	Register on race day:
5K.....\$20	5K.....\$25	5K.....\$40
1M.....\$10	1M.....\$15	1M.....\$30

Race day registration is open from 6:30 am - 7:00 am. No exceptions. Packet pick up available on Friday, September 23, at 2716 North Tenaya Way, from 10:00 am to 7:00 pm and morning of race at registration table.

To register, visit www.uhccf.org/teddybearrunwalk.html

Post-race activities will be family friendly, including various vendor booths, balloon characters, face painting and more!

RECEIVED

SEP 20 2011

Come and enjoy the fun!



TEMPORARY COMMERCIAL PERMIT
TEMPORARY USE
TCP-43280

Valid September 24, 2011 To September 24, 2011



Description of Event: TCP-43280 - Temporary Commercial Permit for United Healthcare Children Foundation to hold a 5K Run/Walk at 2716 N. Tenaya Avenue. The event will take place on September 24th, 2011. Most of the event will occur on-site with a small portion of the run to take place on Box Canyon Drive and Cathedral Rock Drive. The start/finish line will be set-up within the parking lot to give ample space for the participants.

Applicant: United Healthcare Childrens
Foundation
2716 N. Tenaya Ave
Las Vegas, NV 89134
(702)242-7540 x

Parcel(s): Multiple Parcels
Ward(s): WARD 1 (LOIS TARKANIAN)

THIS PERMIT IS APPROVED PURSUANT TO SECTION 19.18.100 OF THE LAS VEGAS MUNICIPAL CODE, SUBJECT TO THE FOLLOWING CONDITIONS:

See page 2 for conditions

THIS TEMPORARY COMMERCIAL PERMIT IS NOT VALID UNTIL THE FOLLOWING DEPARTMENT APPROVALS / PERMITS / LICENSES HAVE BEEN OBTAINED:

☐ FIRE _____ (Initials)

☐ BUSINESS SERVICES _____ (Initials)

☐ SEWER _____ (Initials)

☐ TRAFFIC _____ (Initials)

THIS PERMIT SHALL BE POSTED IN A CONSPICUOUS PLACE



TEMPORARY COMMERCIAL PERMIT

TEMPORARY USE

TCP-43280

Valid September 24, 2011 To September 24, 2011



1. BUSINESS HOURS SHALL BE FROM 7 Am TO 7 PM.
2. THIS PERMIT IS NOT A BUSINESS LICENSE.
3. THIS PERMIT IS NOT A SUBSTITUTE FOR ANY REQUIRED STATE OR LOCAL BUSINESS LICENSE OR FOR ANY REQUIRED CHARITABLE SOLICITATION PERMIT.
4. This use shall not create a nuisance to nearby properties as a result of factors such as excessive illumination, glare, noise, vibration, smoke, dust, dirt, odors, gases or heat.
5. The use shall conform to the submitted plot plan date stamped 9-24-11.
6. No combustible materials shall be located within 50 feet of any structure on, or adjacent to this site.
7. No building or structure of any type shall be erected closer than 25 feet from any property line.
8. The applicant shall display a copy of this Temporary Commercial Permit during the hours of operation.
9. Sanitation facilities must be provided in accordance with the Clark County Health District and Republic Services of Southern Nevada.
10. The applicant shall provide private security officers as required by the Las Vegas Metropolitan Police Department.
11. Any signage for this temporary commercial use must be approved and permitted by the Planning and Development Department.
12. All applicable City code requirements shall be satisfied.
13. The applicant shall be responsible for leaving the site free of debris, litter or any other evidence of occupancy upon completion or removal of the use.

PLANNING SUPERVISOR SIGNATURE

9-24-11

DATE

PLANNING MANAGER SIGNATURE

DATE

THIS PERMIT SHALL BE POSTED IN A CONSPICUOUS PLACE