

STATEMENT OF FINANCIAL INTEREST


Name of Applicant: Richmond American Homes


Yes X No

APN: _____

Print Name: Melinda Poolare

Virginia Jaurique
Notary Public in and for said County and State

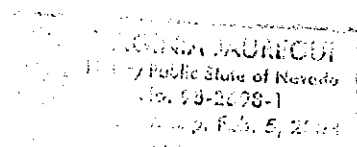

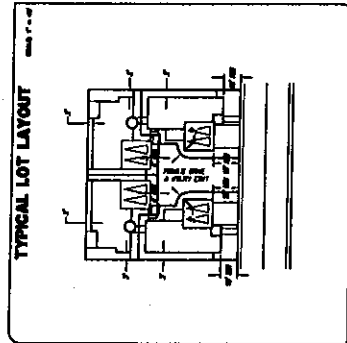[illegible]

BY

Triton
Engineering

6757 W. Charleston Boulevard
Suite B
Las Vegas, Nevada 89146
Office: (702) 254-1480
Fax: (702) 254-3062
www.tntelnet.com

 1-702-593-6111

**Call
before you
Dig.
1-800-277-2600**

[illegible]

REVISED

~~SDR-12120, VAR-12121,~~

ZON-12118

05/11/06 PC

MAY 10 2006

RECEIVED
CROSS RELATIONS

INDEX OF DRAWINGS

RETRACT REQUIREMENTS

[illegible][illegible]

BASIS OF BEATING

ESTIMATED SEWAGE CONTRIBUTION

ENGINEER

SURVEYOR

DEVELOPER

OWNER

ASSESSOR'S PARCEL NUMBER

Triton Engineering

SITE PLAN

RICHMOND AMERICAN HOMES OF NEVADA, INC.
CENTRAL / THOM

BOOK 1 of
CLY. ENG. 7

