



PLANNING & DEVELOPMENT DEPARTMENT

STATEMENT OF FINANCIAL INTEREST

Case Number: EDT-14961 APN: 137-12-410-005

Name of Property Owner: Casa Grande 10, LLC

Name of Applicant: Todd L. Kessler

To the best of your knowledge, does the Mayor or any member of the City Council or Planning Commission have any financial interest in this or any other property with the property owner, applicant, the property owner or applicant's general or limited partners, or an officer of their corporation or limited liability company?

☐ Yes

☒ No

If yes, please indicate the member of the City Council or Planning Commission who is involved and list the name(s) of the person or persons with whom the City Official holds an interest. Also list the Assessor's Parcel Number if the property in which the interest is held is different from the case parcel.

City Official: _____

Partner(s): _____

APN: _____

Signature of Property Owner: _____

Print Name: Steven Mack

Subscribed and sworn before me

This 6th day of July, 2006
Karen Ann Frantel
Notary Public in and for said County and State



RECEIVED

JUL 07 2006




Parcel D Summary	
Land	43,667 S.F. (1.00 AC)
Building	Pad - 5,056 S.F.
Coverage	11.5%

Parcel B Summary	
Land	99,001 S.F. (2.22 AC)
Building	Shops 1 - 18,600 S.F.
Coverage	17.2%


Parcel A Summary



EOT-14961
08-16-06 CC

CLIFF S. (B) EYE
RECEIVED
JUL 07 2006

AS1.00

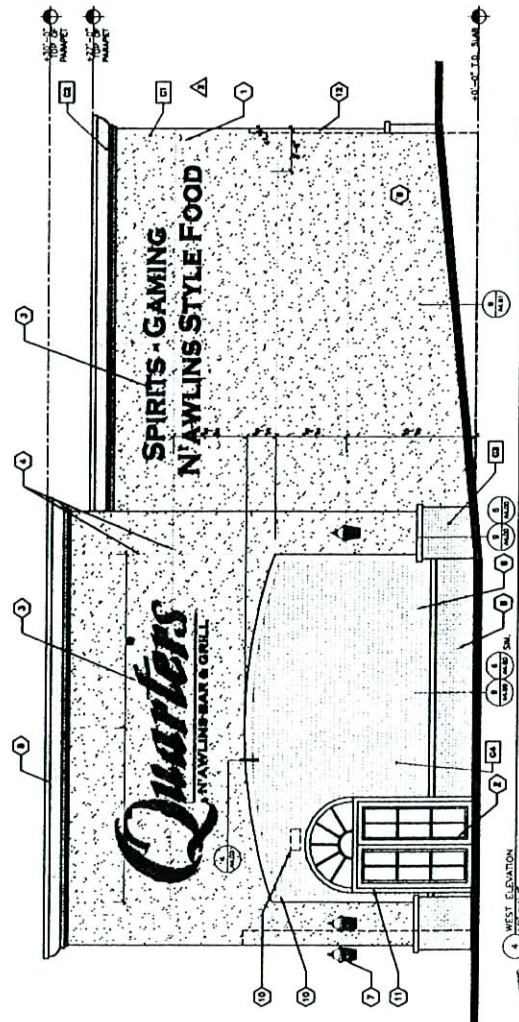

EOT-14961
08-16-06 CC

1	FELD ARMS TRNG, COLOR TALL
2	WAL-PO-ART, COLOR TALL
3	"TALL" BRICK VEHIC BY S. KIMMEL CO., 8. 10-0000 8000. MANUFACT. NUMBERED (10-0000 8000) BY 10-0000 01 TALL.
4	WED BORG AT ENTRY AREA, COLOR TALL.

A2.01

Exterior Elevations

Project:
7704A QUARTER8
CHEYENNE AND 218

CHEYENNE AND 215

A.P.N. 137-12-410-005

**BRESLIN
BUILDERS**



CONTRACTOR

[illegible]




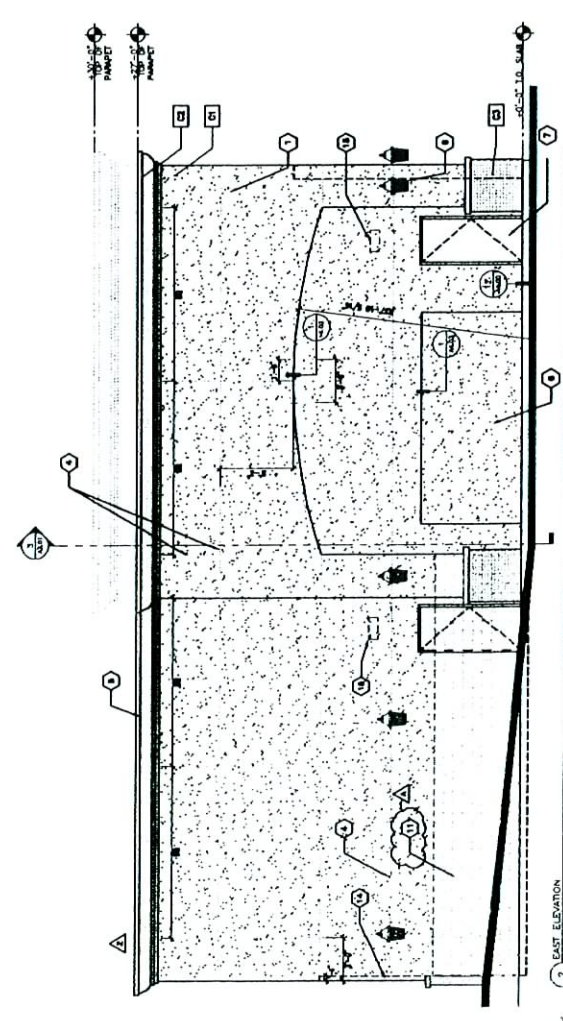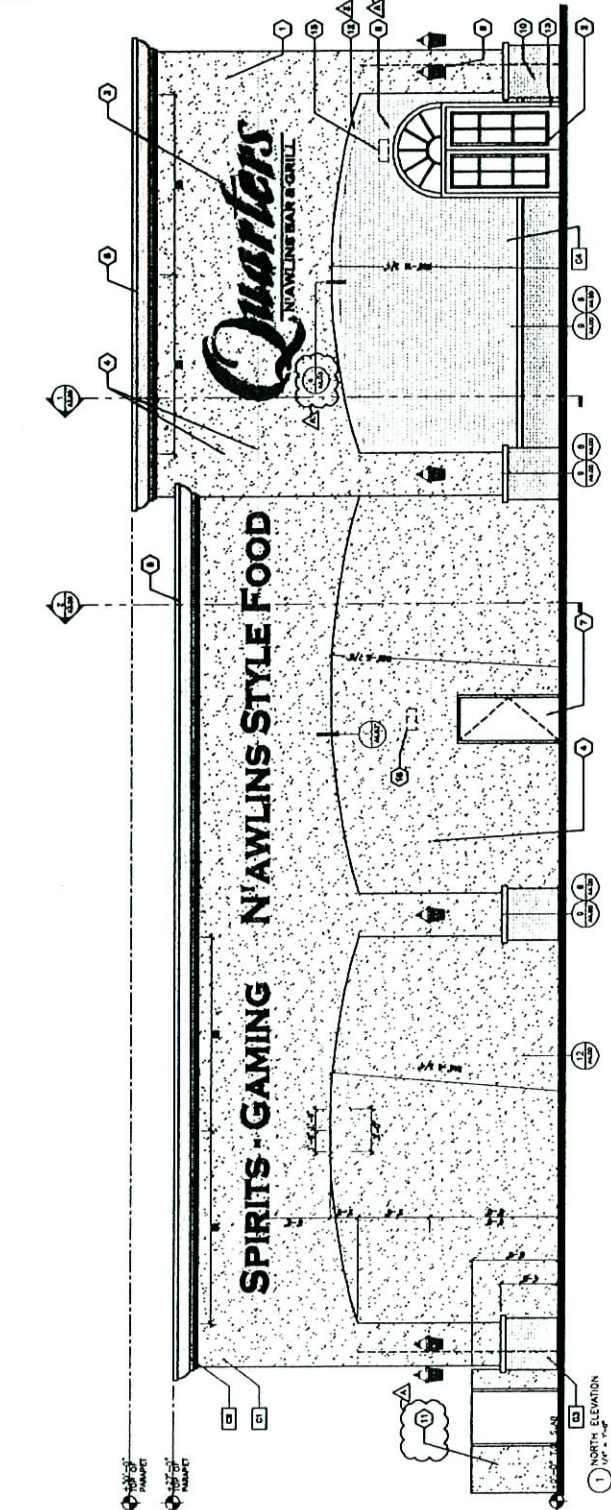


EOT-14961
08-16-06 CC

RECEIVED
JUL 07 2006

CONTRACTOR

77004 QUARTERS
CHETENNE AND 216
CHETENNE AND 216
APN: 137-12410-005

BRESLIN BUILDERS












EOT-14961 - APPLICANT/OWNER: CASA GRANDE 10, LLC
Northwest corner of Cliff Shadows Parkway and the Beltway alignment
AUGUST 16, 2006 CITY COUNCIL MEETING

Picture taken 07/28/06