



REVISIONS	DATE	BY	DESCRIPTION


4301 W. LAKE MEAD BLVD.

DRAWN	
CHECKED	
DATE	
SCALE	
JOB NO.	
DR. NO.	
SHEET	

C-1

R-13

20' WIDE ALLEY

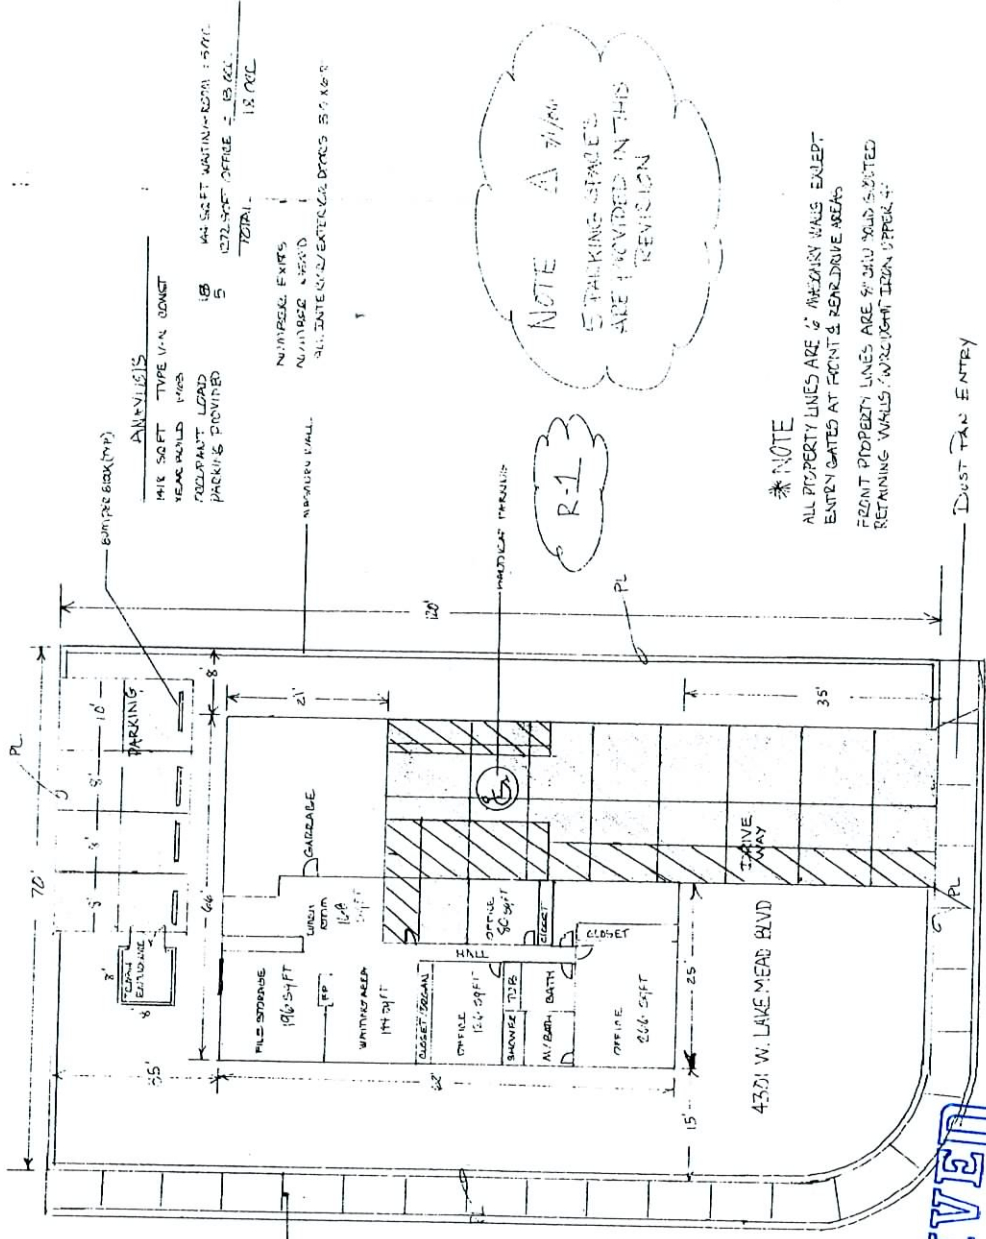

ANALYSIS




NOTE: A 7/10/06  
 STAIRING SPACES  
 ARE PROVIDED IN THIS  
 REVISION


R-1

\* NOTE  

RECEIVED  
 JUL 15 2006

ZON-14340  
 07/27/06 PC  
 REVISED

SITE PLAN SCALE 1/8" = 1'-0"

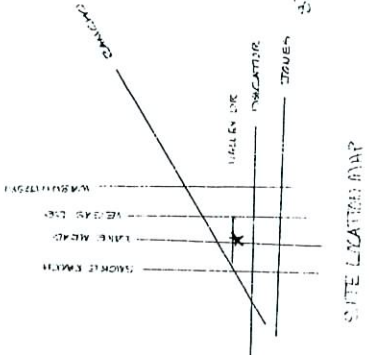

VALLEY DRIVE

LAKE MEAD BLVD

3 OF 3 SHEETS