

RECEIVED


AUG 4 2006

landscape plan

SUP-15038 SUP-15039

SDR-15035 08/24/06 PC

REVISED

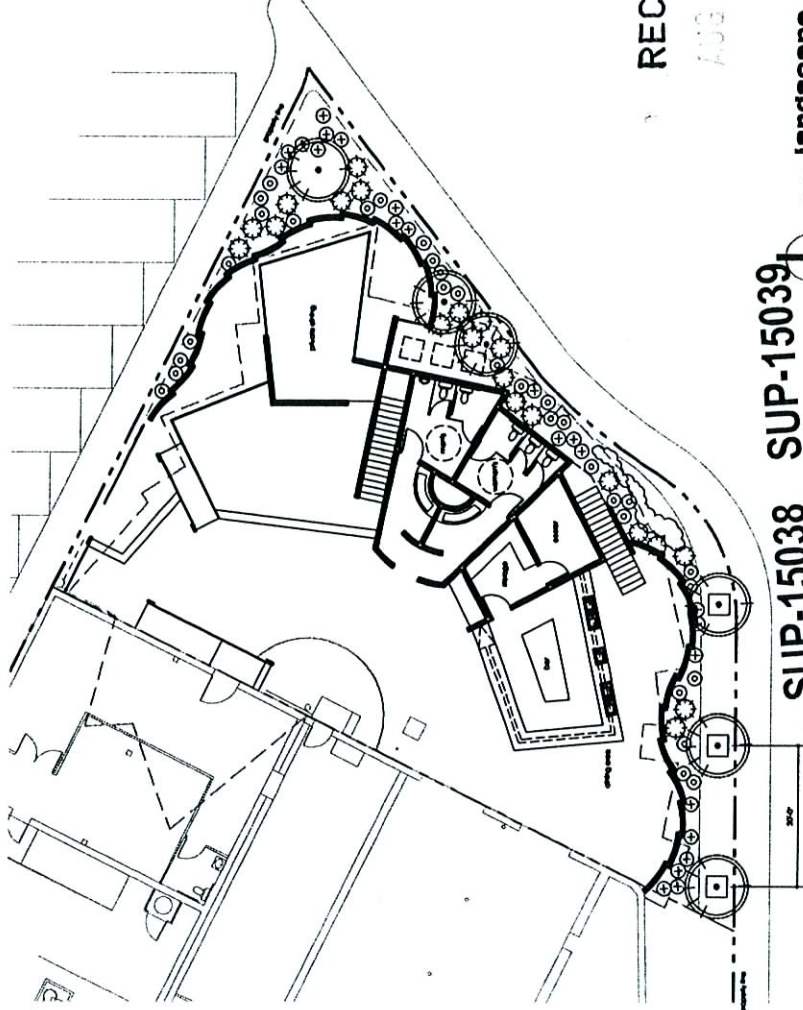





RECEIVED
AUG 04 2006

RECEIVED
AUG 04 2006

RECEIVED
AUG 4 2006

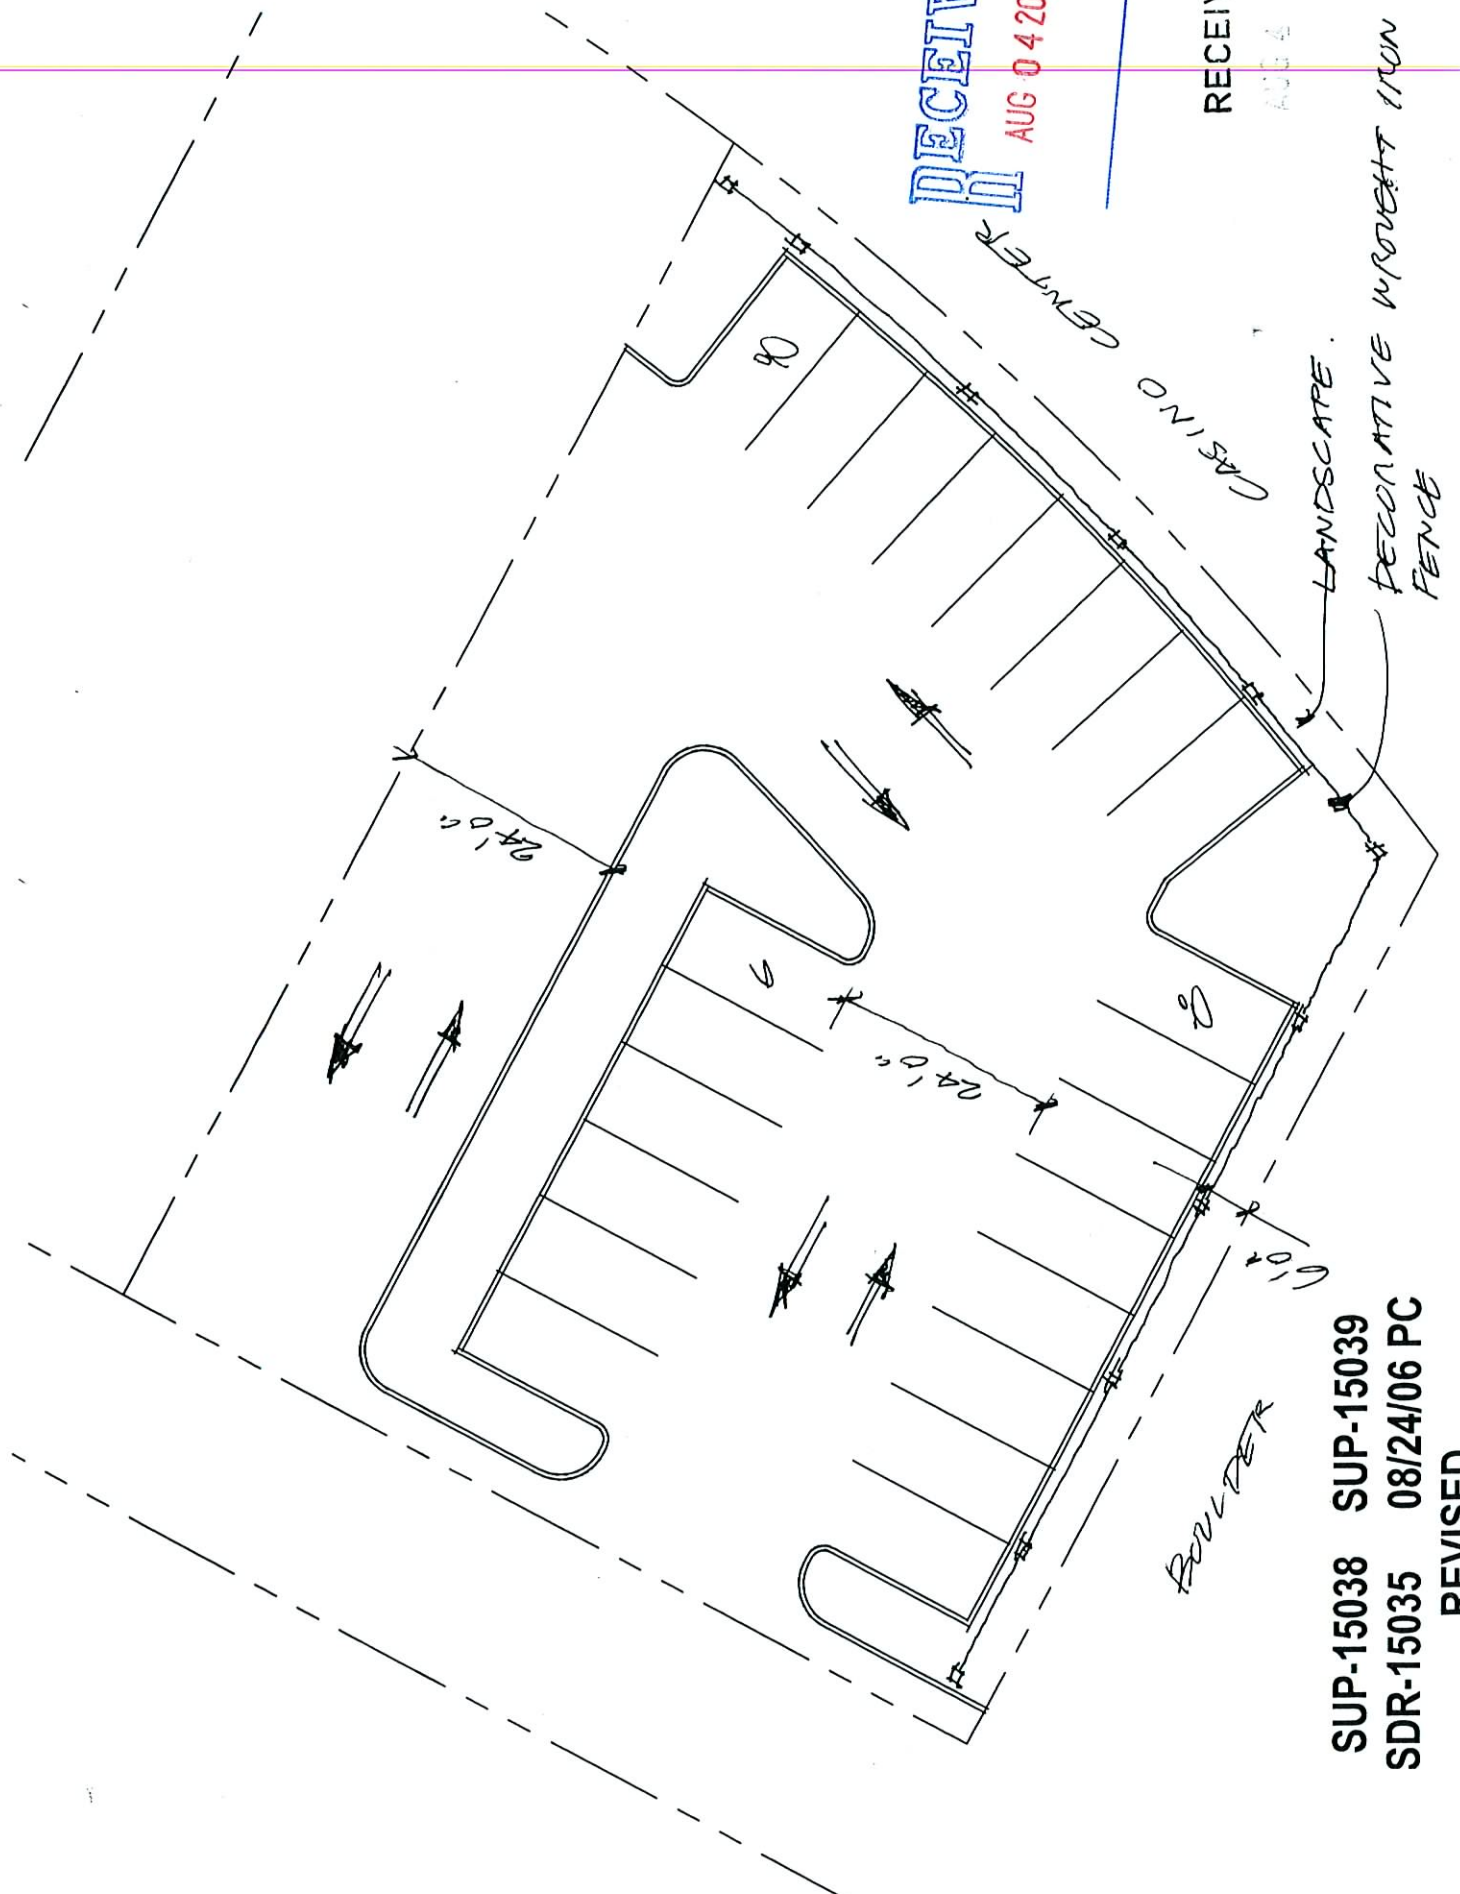

SUP-15038 SUP-15039
SDR-15035 08/24/06 PC
REVISED

