



PLANNING & DEVELOPMENT DEPARTMENT

STATEMENT OF FINANCIAL INTEREST

Case Number: EDT-17091 APN: 139-35-112-001

Name of Property Owner: JAMES & ELIZABETH BRACY JR

Name of Applicant: SAME ABOVE

To the best of your knowledge, does the Mayor or any member of the City Council or Planning Commission have any financial interest in this or any other property with the property owner, applicant, the property owner or applicant's general or limited partners, or an officer of their corporation or limited liability company?

Yes

No

If yes, please indicate the member of the City Council or Planning Commission who is involved and list the name(s) of the person or persons with whom the City Official holds an interest. Also list the Assessor's Parcel Number if the property in which the interest is held is different from the case parcel.

City Official: _____

Partner(s): _____

APN: 139-35-112-001

Signature of Property Owner: *James Bracy Jr*


Print Name: JAMES & ELIZABETH BRACY JR


Subscribed and sworn before me

This 25th day of SEPT, 2006

Clarissa V. Ignacio

Notary Public in and for said County and State NEVADA

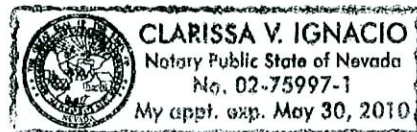

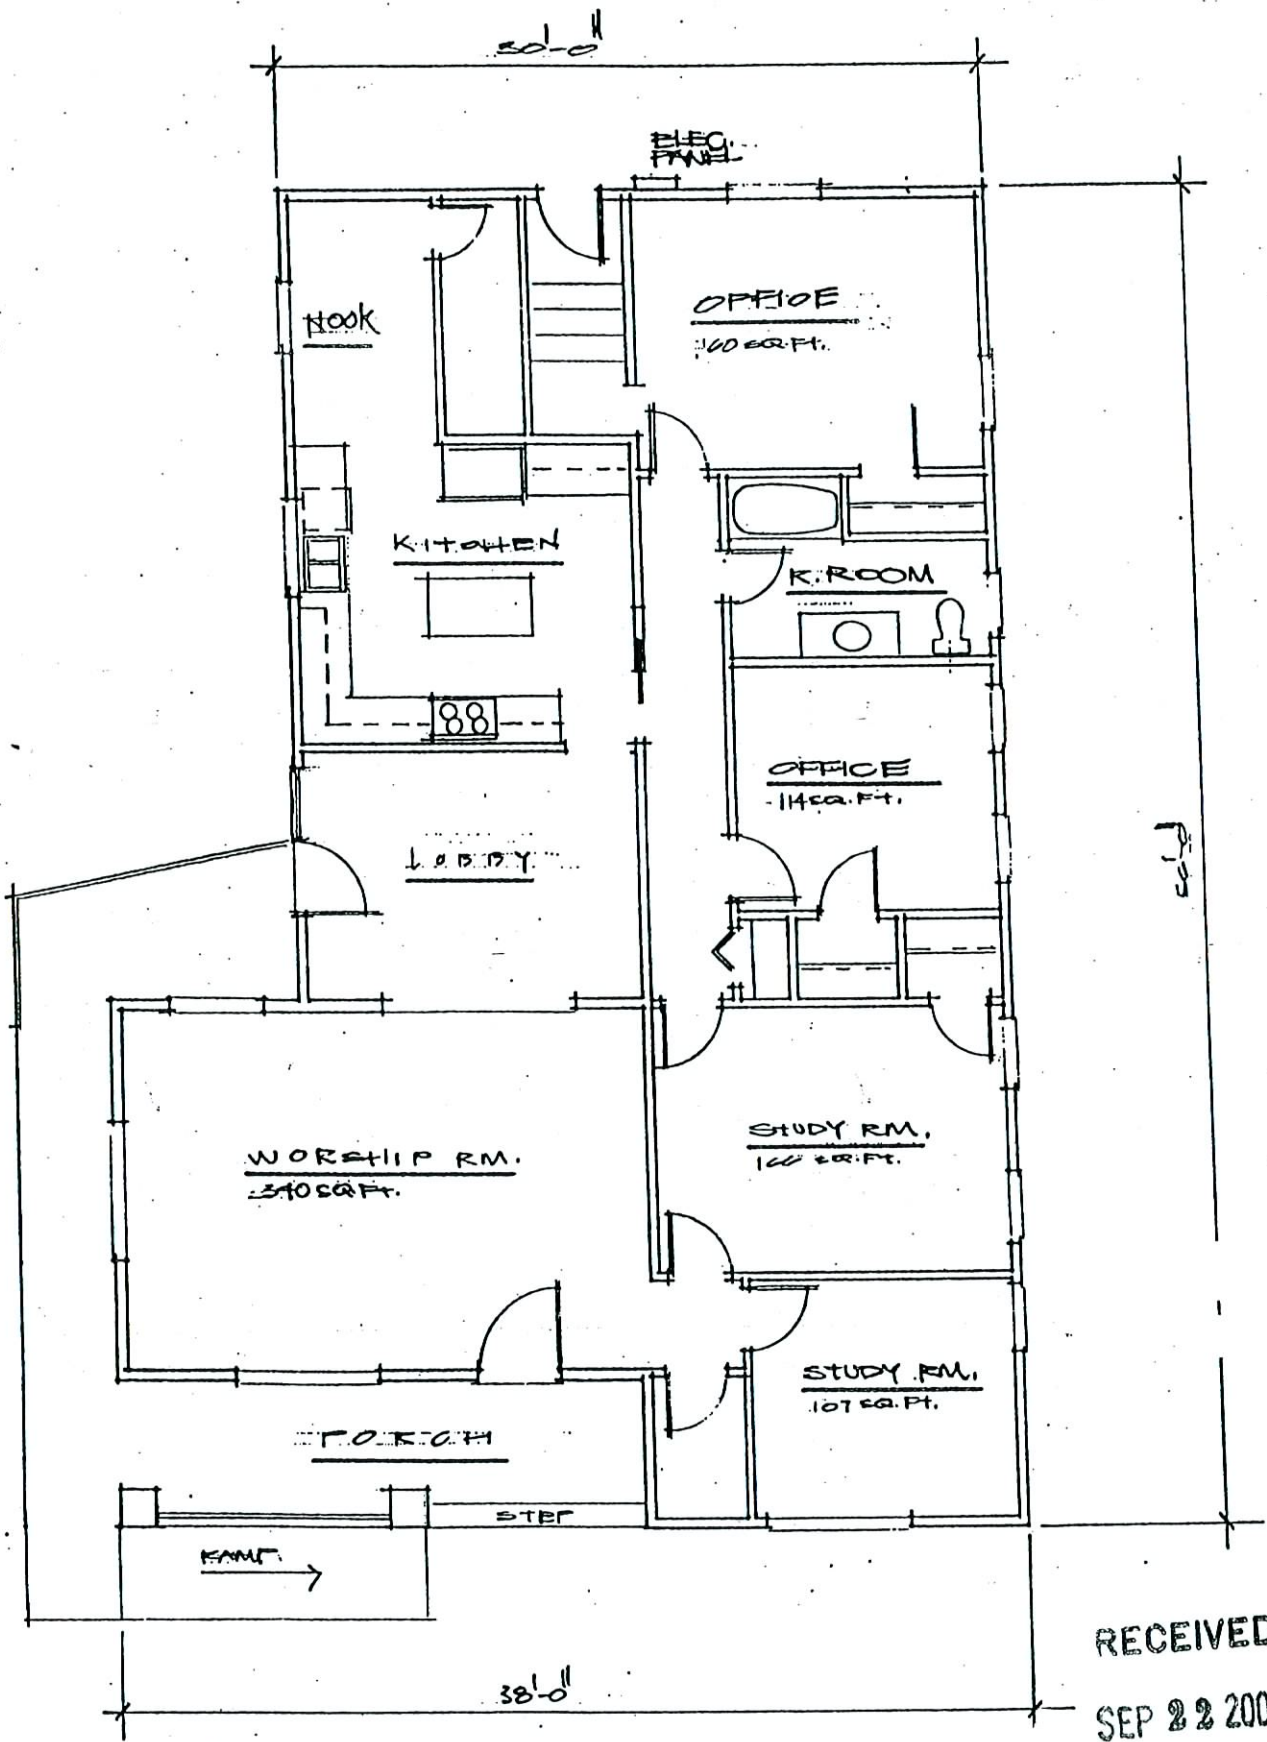

RECEIVED
SEP 22 2006

EOT-17091
FLOOR PLAN (AS BUILT)
 11/01/06 CC
 scale = 1/4"

