



AREA MAP  
NTS

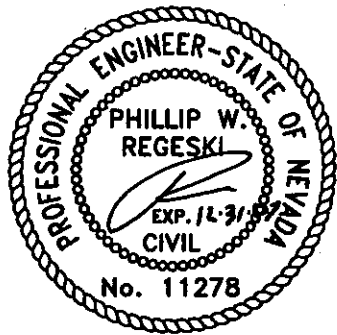


11-16-06

EXHIBIT "A"

(P) 5'x5' PLANTER WITH  
GRATE, DEPTH = 6'

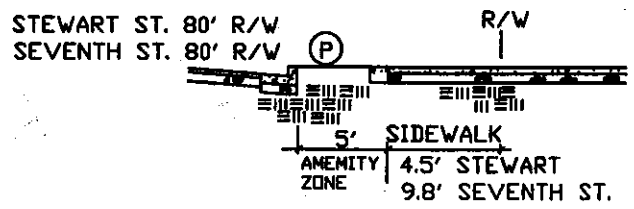

TYPICAL SECTION  
NTS

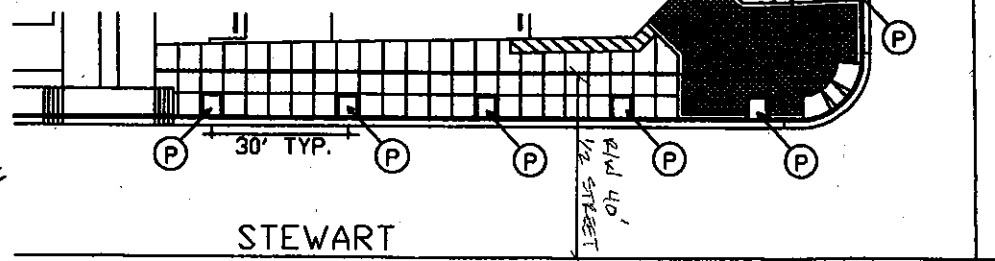

STEWART

SEVENTH STREET

**P.R.E.** ENGINEERING



10225 SCHUSTER ST.  
LAS VEGAS, NEVADA 89141  
(702) 434-8515

ENCROACHMENT EXHIBIT

DATE 11/16/06  
SCALE NTS  
7149-ENCROACHMENT