
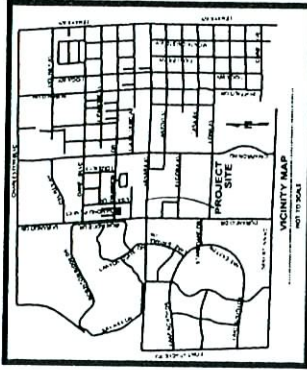
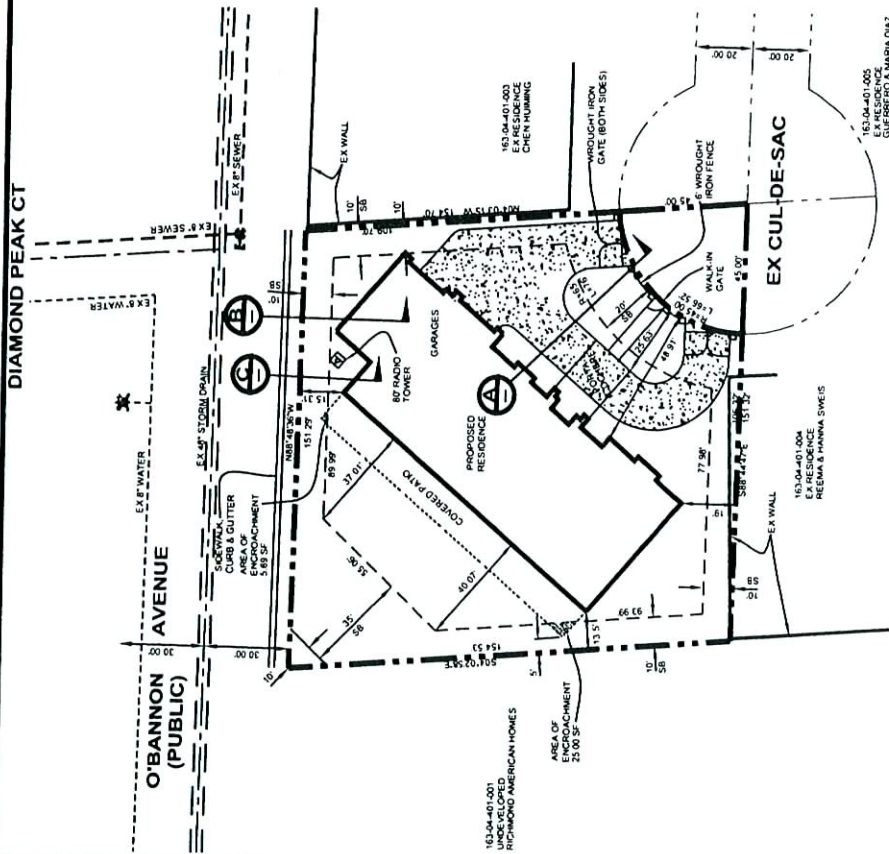


APN # 163-04-401-002
BEING A PORTION OF THE SOUTH HALF (W 1/2) OF THE SOUTHWEST QUARTER (SW 1/4)
OF SECTION 04, TOWNSHIP 21 SOUTH, RANGE 60 EAST, N.D.M.

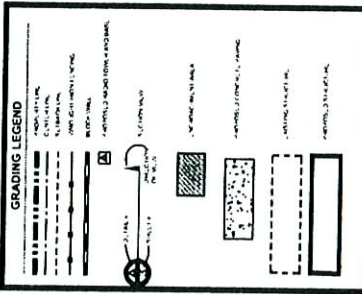

GRAPHIC SCALE
1 inch = 20 ft.
(4 sec.)

[illegible][illegible][illegible]

BASIS OF BEARINGS:

[illegible]

OWNER / DEVELOPER

RADIO TOWER SECTION

CMU WALL DETAIL

WROUGHT IRON FENCE DETAIL

~~VAR-14734 VAR-14735~~

SUP-15027 REVISED

11/02/06 PC

SEP 12 2006

STEVE PORTNOFF RESIDENCE
O'BANNON AVENUE AND LISA LANE
CITY OF LAS VAGAS
SITE PLAN

PORTNOFF RESIDENCE

[illegible]