



PLANNING & DEVELOPMENT DEPARTMENT

STATEMENT OF FINANCIAL INTEREST

Case Number: **RQR-17518** APN: 139-34-410-165

Name of Property Owner: Gateway Motel Inc.

Name of Applicant: Reagan National Advertising of Nevada

To the best of your knowledge, does the Mayor or any member of the City Council or Planning Commission have any financial interest in this or any other property with the property owner, applicant, the property owner or applicant's general or limited partners, or an officer of their corporation or limited liability company?

☐ Yes

☒ No

If yes, please indicate the member of the City Council or Planning Commission who is involved and list the name(s) of the person or persons with whom the City Official holds an interest. Also list the Assessor's Parcel Number if the property in which the interest is held is different from the case parcel.

City Official: _____

Partner(s): _____


APN: _____


Signature of Property Owner: Andrew D. Bilanzich

Print Name: Andrew D. Bilanzich

Subscribed and sworn before me

This 10th day of October, 20 06
Lee Marie Skore, Salt Lake County, Utah
Notary Public in and for said County and State

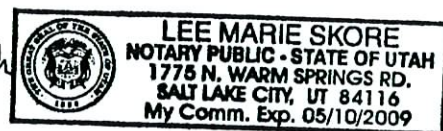

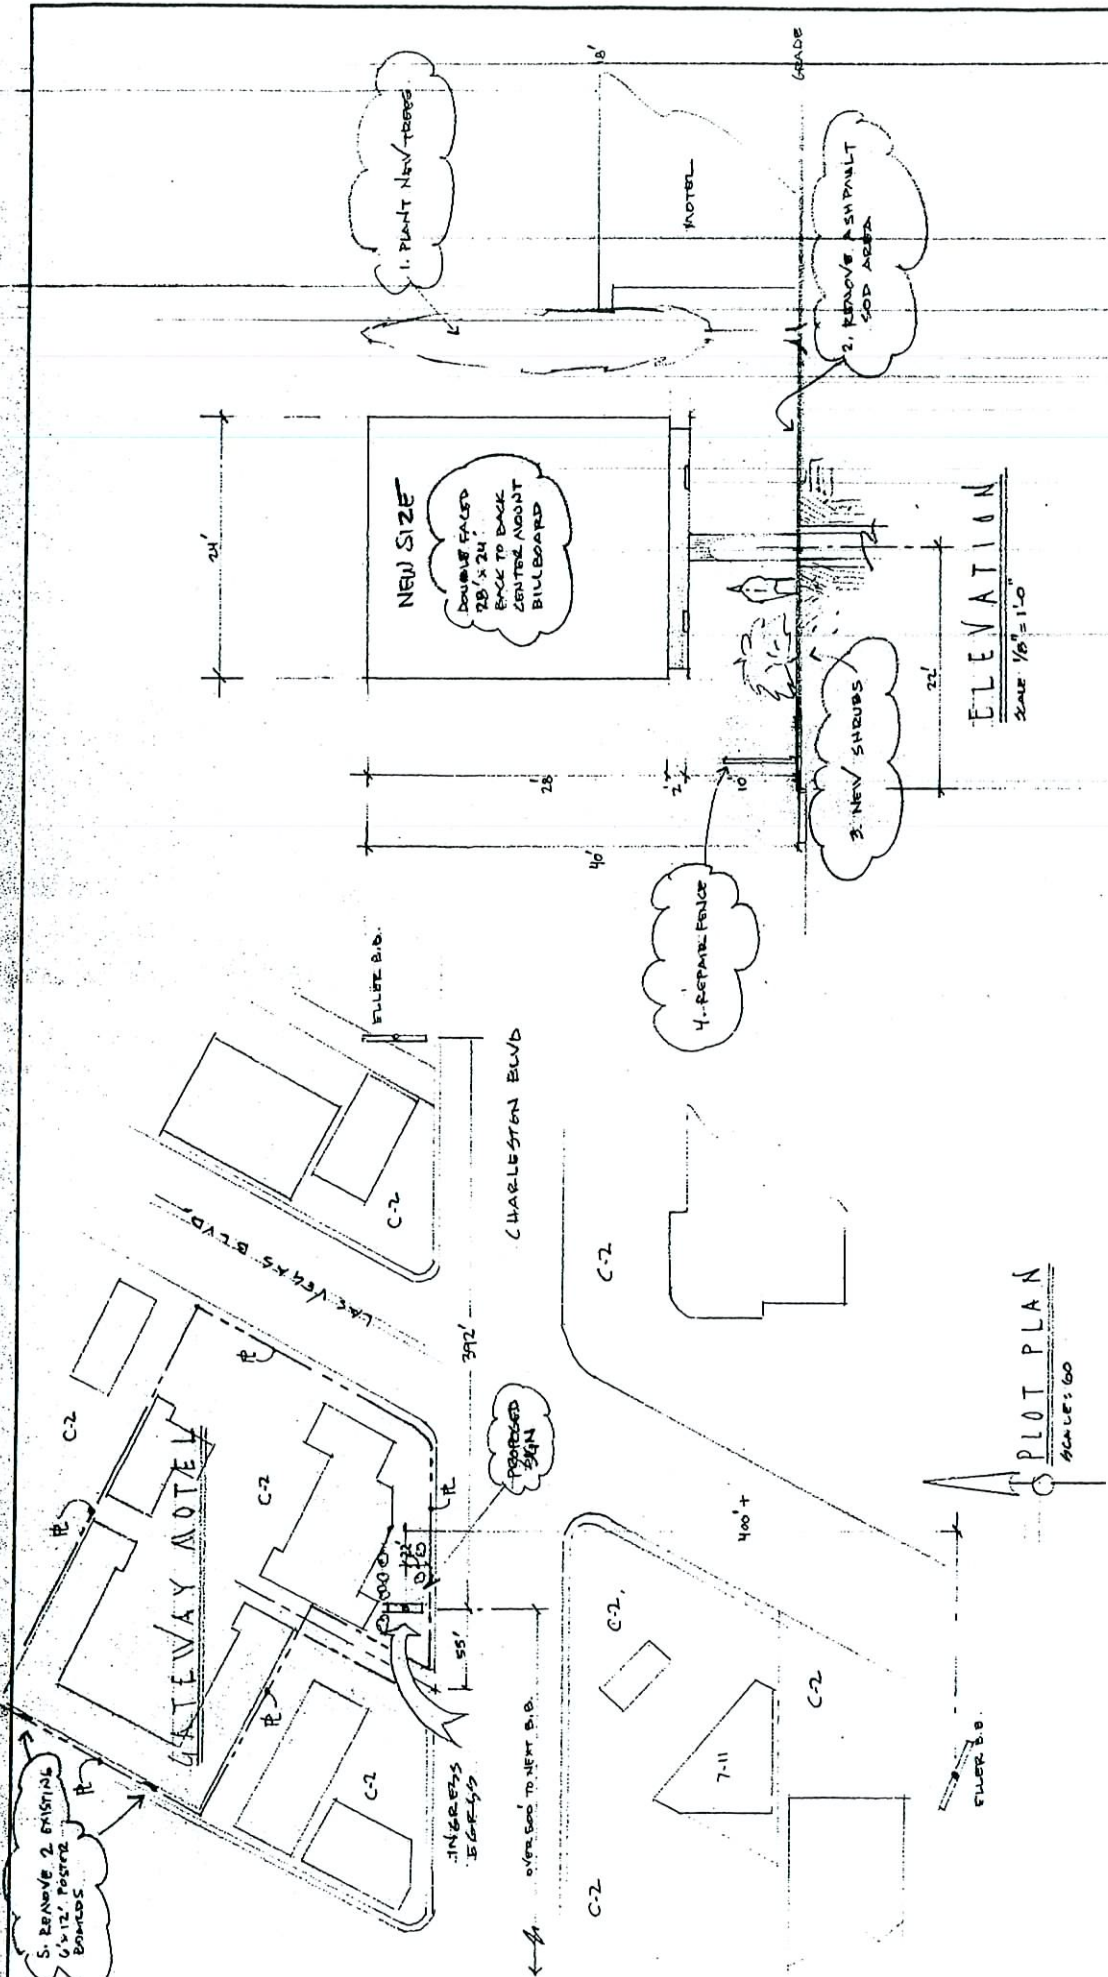

REAGAN NATIONAL ADVERTISING
7181 S. INDUSTRIAL LN NV 89118 • 702-361-3904

OWNER: Gateway Motel
DESIGNED BY: 7181 S. INDUSTRIAL LN NV 89118
SCALE NOTED: APPROVED
DRAWN BY: LCC


RQR-17518
12/07/06 PC

OCT 12 2006



RQR-17518 - APPLICANT: REAGAN NATIONAL ADVERTISEMENT - OWNER: GATEWAY MOTEL, INC.
928 LAS VEGAS BOULEVARD SOUTH
DECEMBER 7, 2006 PLANNING COMMISSION

11/08/06

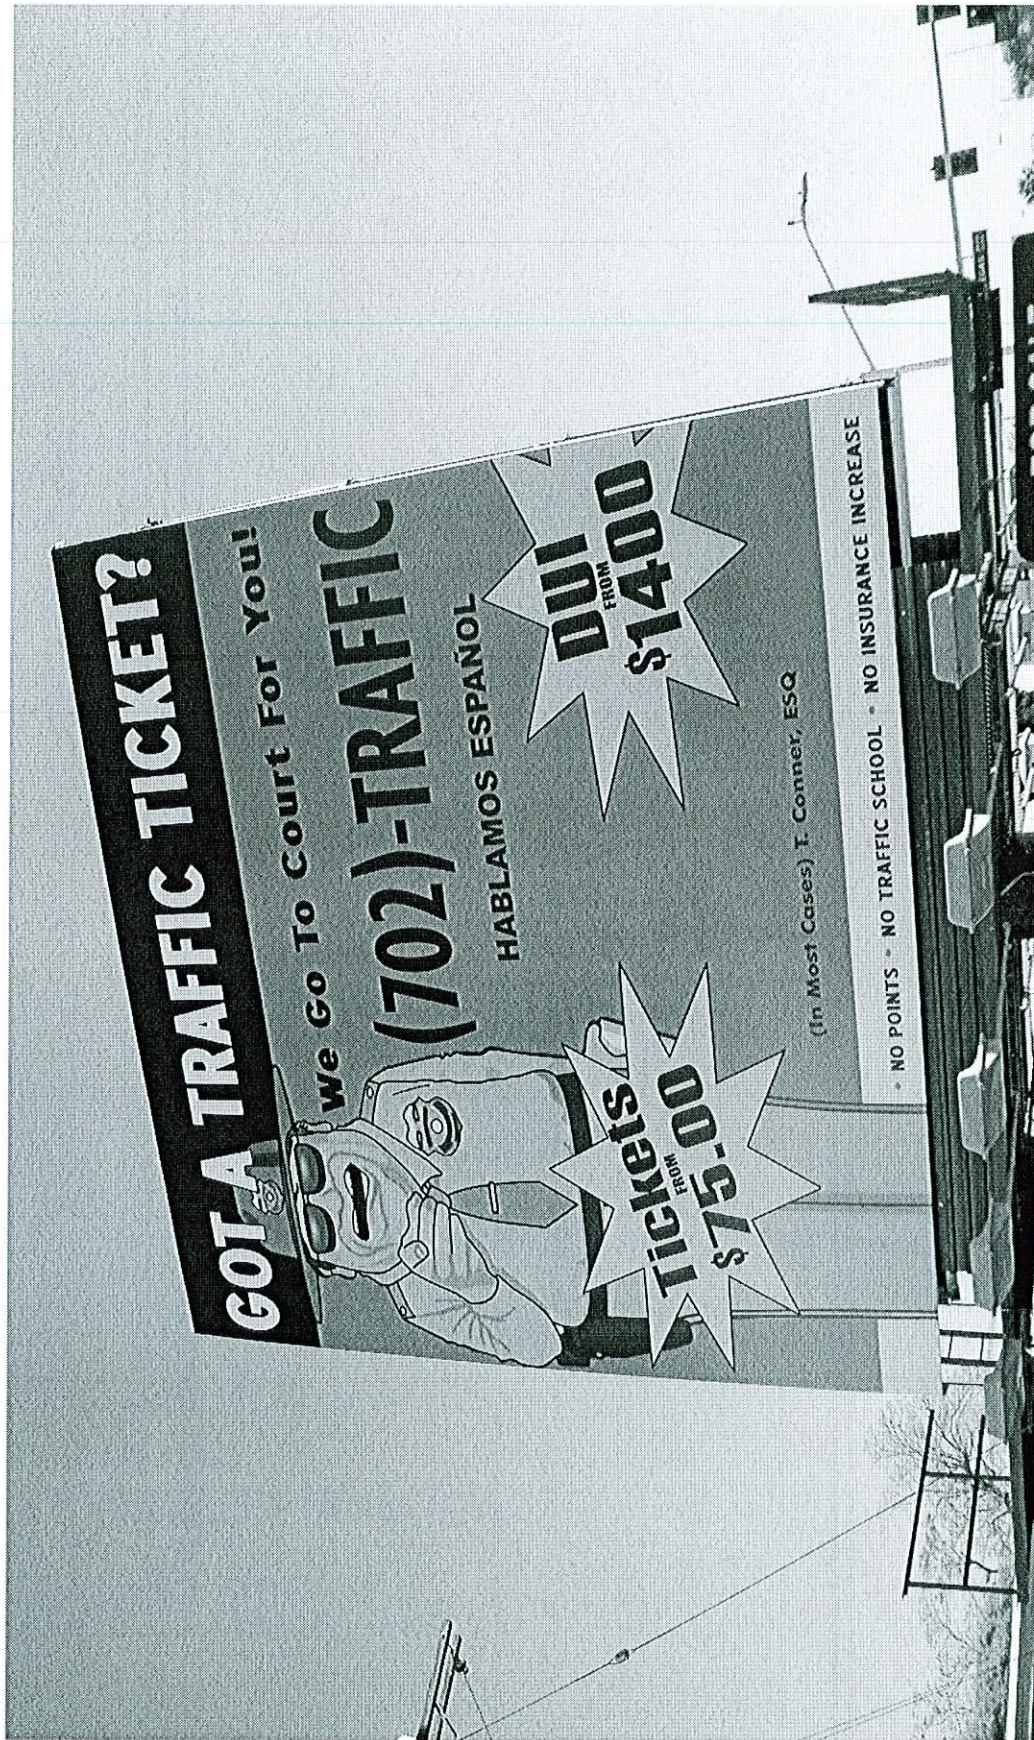

RQR-17518 - APPLICANT: REAGAN NATIONAL ADVERTISEMENT - OWNER: GATEWAY MOTEL, INC.
928 LAS VEGAS BOULEVARD SOUTH
DECEMBER 7, 2006 PLANNING COMMISSION

11/08/06