



PLANNING & DEVELOPMENT DEPARTMENT

STATEMENT OF FINANCIAL INTEREST

Case Number: DIR-18634 APN: 138-32-312-005 & 008

Name of Property Owner: Boca Fashion Village LLC

Name of Applicant: Triple Five Development

Name of Representative: Gary Leobold

To the best of your knowledge, does the Mayor or any member of the City Council or Planning Commission have any financial interest in this or any other property with the property owner, applicant, the property owner or applicant's general or limited partners, or an officer of their corporation or limited liability company?

Yes

No

If yes, please indicate the member of the City Council or Planning Commission who is involved and list the name(s) of the person or persons with whom the City Official holds an interest. Also list the Assessor's Parcel Number if the property in which the interest is held is different from the case parcel.

City Official: _____

Partner(s): _____

APN: _____


Signature of Property Owner: Martin H Walvath

Print Name: Martin H Walvath

Subscribed and sworn before me

This 5th day of December, 2006

Susan J. Azuse
Notary Public in and for said County and State

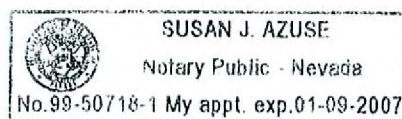


2006

Boca Park Fountain Dimensions


Fountain 1



Fountain 3

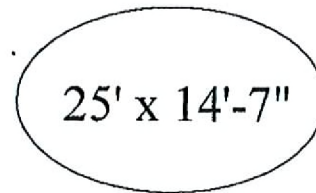


Fountain 2

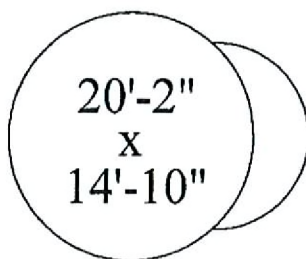


Step
9'-6"
X
3'-6"

Fountain 4

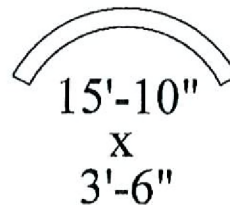

DIR-18634
01-17-07 CC



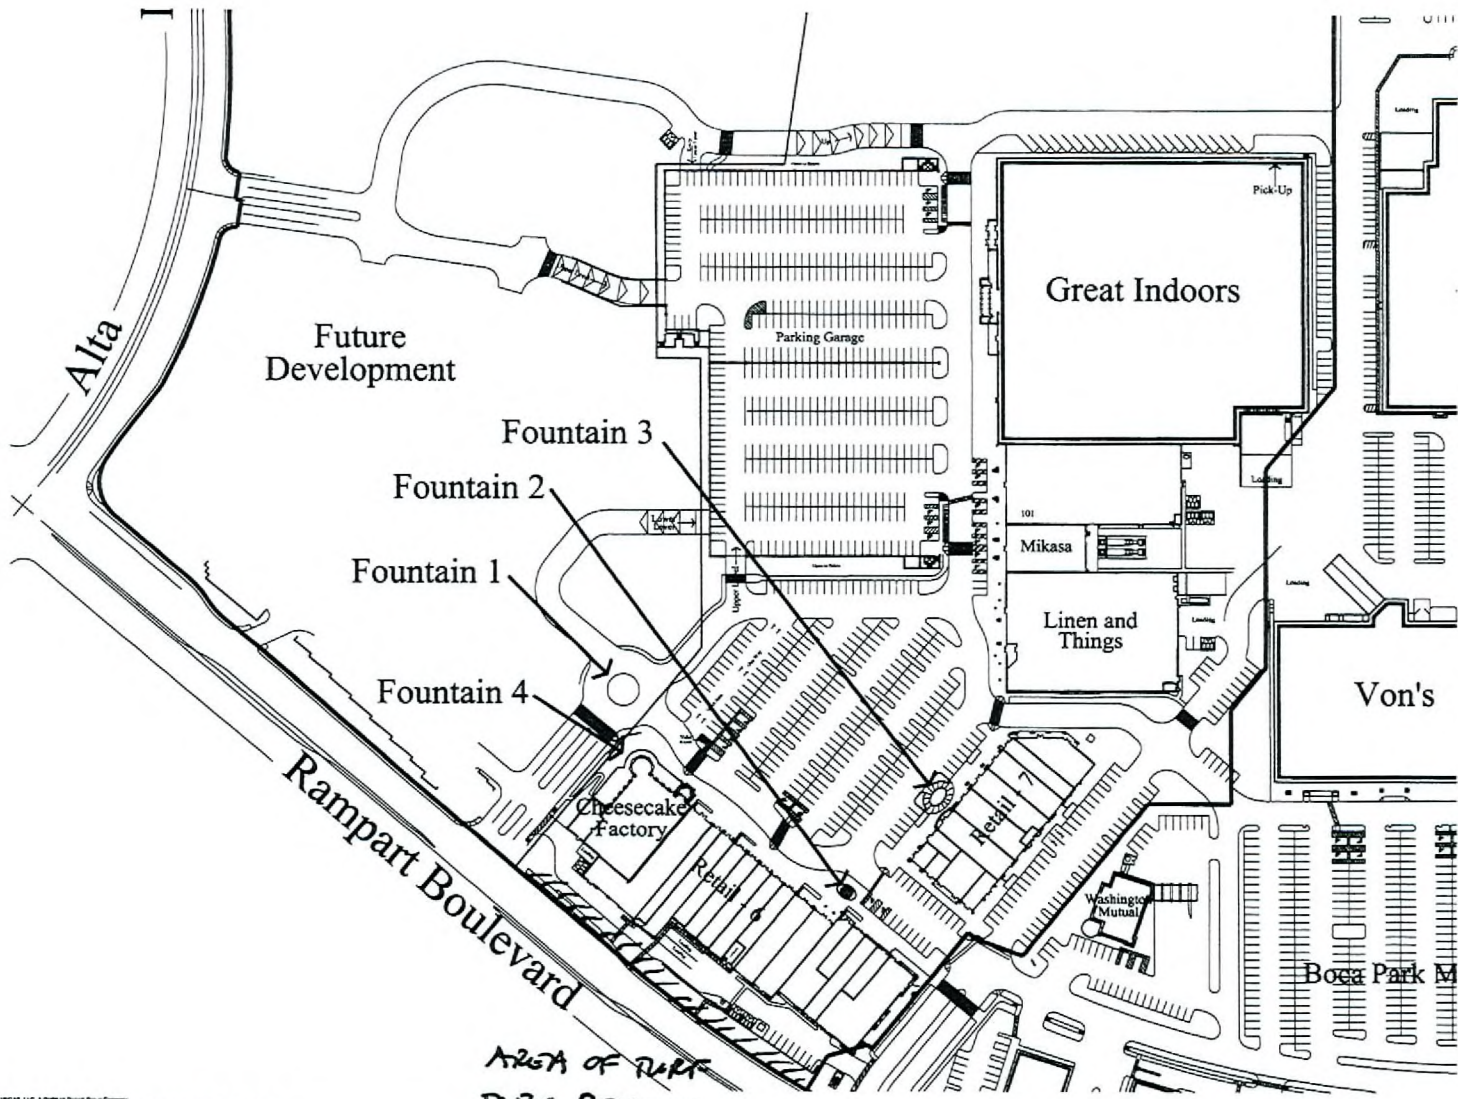

TO BE REMOVED

Scale: 1" = 150'
PROJECT No 105150 December 08, 2006

(8,000 SF) **The Shops at Boca Park**
Las Vegas, Nevada



DIR-18634
01-17-07 CC



© Copyright 2006, P.A. LAS VEGAS, L.L.C. A Perlman Design Group Company. This Plan is Confidential and its use without the express written consent of the Designer is prohibited. The Designer/Architect reserves the right to make design modifications without notice. All other information shown is intended for informational purposes only and is subject to change.