



PLANNING & DEVELOPMENT DEPARTMENT

STATEMENT OF FINANCIAL INTEREST

Case Number **ZON-16179** APN: 163-01-612-039

Name of Property Owner: Peter Chung & Yin Yan

Name of Applicant: Peter Chung & Yin Yan

To the best of your knowledge, does the Mayor or any member of the City Council or Planning Commission have any financial interest in this or any other property with the property owner, applicant, the property owner or applicant's general or limited partners, or an officer of their corporation or limited liability company?

_____ Yes X No

If yes, please indicate the member of the City Council or Planning Commission who is involved and list the name(s) of the person or persons with whom the City Official holds an interest. Also list the Assessor's Parcel Number if the property in which the interest is held is different from the case parcel.

City Official: _____

Partner(s): _____

APN: _____


Signature of Property Owner: [Handwritten Signature]



Print Name: YIN YAN & Peter Chung

Subscribed and sworn before me

This 21 day of August, 2006

[Handwritten Signature]
Notary Public in and for said County and State

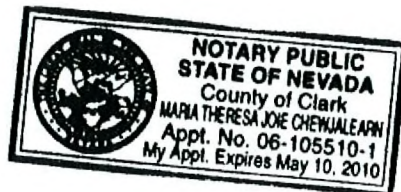

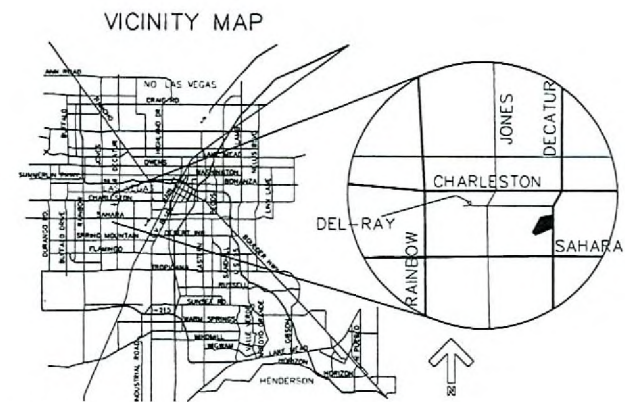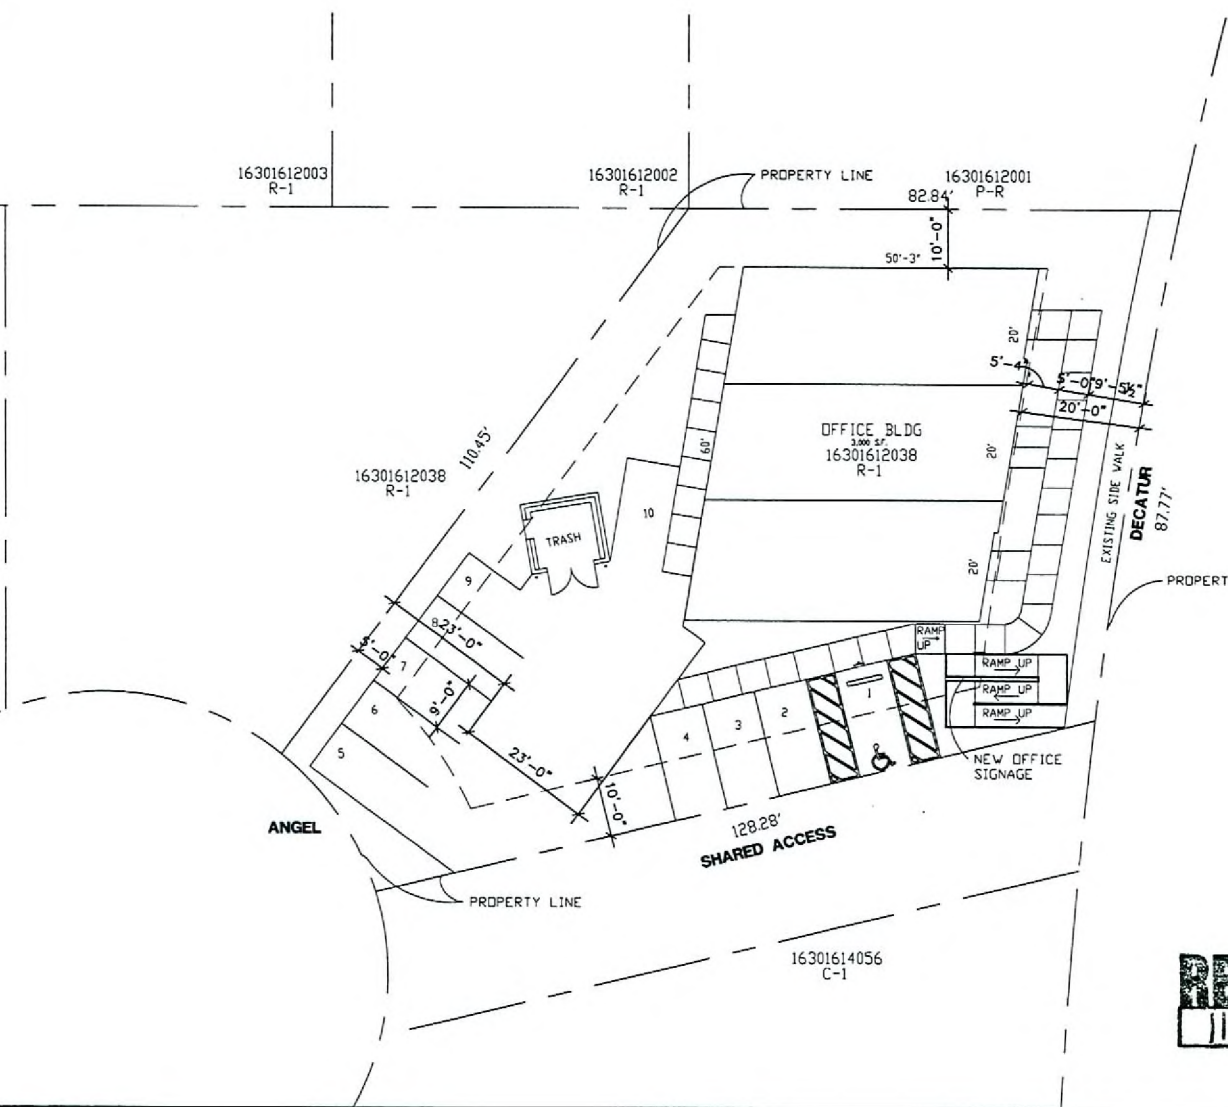


PROJECT SUMMARY

SITE			
CURRENT ZONING:	LIMITED COMMERCIAL		C-1
LOT COVERAGE BY BUILDING FOOT PRINT: (APPROX)	ALLOWABLE		50%
SETBACKS			
FRONT YARD:			20 FEET
SIDE YARDS:			10 FEET
REAR YARDS:			20 FEET
BUILDING HEIGHT ALLOWED:			NONE
BUILDING OCCUPANCY			
ONE STORY OFFICE			3,000 sq. ft.
MAXIMUM CAPACITY:			30 PEOPLE
PARKING			
TOTAL PARKING REQUIRED			
1 SPACE FOR EVERY 300 S.F.		3,000/300 =	10 SPACES
(HANDICAP SPACES)			(1 SPACES)
TOTAL PARKING PROVIDED			(10 SPACES)
PARKING SPACES			(1 SPACES)
(HANDICAP SPACES)			

REVISED
11.20.06

WTS PLAN
ANGEL OFFICE

NOV 20 2006
RECEIVED

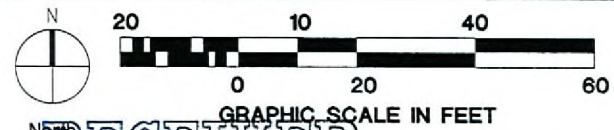

LENDALL MAINS
ARCHITECT
3938 East Patrick Lane
Suite #1
Las Vegas, Nevada 89120
Phone: 702.437.5521
Fax: 702.437.3522

AS-1

**ZON-16179 VAR-16181
VAR-17191 SDR-16180
12/21/06 PC REVISED**