



PLANNING & DEVELOPMENT DEPARTMENT

STATEMENT OF FINANCIAL INTEREST

Case Number: **VAC-18045** APN: 139-27-707-008
139-27-810-001 to 004, 046-051

Name of Property Owner: The Aquitania Corp

Name of Applicant: The Aquitania Corp

To the best of your knowledge, does the Mayor or any member of the City Council or Planning Commission have any financial interest in this or any other property with the property owner, applicant, the property owner or applicant's general or limited partners, or an officer of their corporation or limited liability company?

☐ Yes

☒ No

If yes, please indicate the member of the City Council or Planning Commission who is involved and list the name(s) of the person or persons with whom the City Official holds an interest. Also list the Assessor's Parcel Number if the property in which the interest is held is different from the case parcel.

City Official: _____

Partner(s): _____

APN: _____


Signature of Property Owner: _____

Print Name: Darren Dunkel


Subscribed and sworn before me

This 2 day of November, 2006

Notary Public in and for said County and State

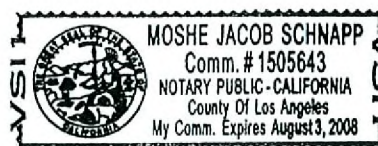

\\AS-41\TINC\dwg\CHIEFS\VIN-RV\dwg_10_12006_10_13_154_Alt_1.dwg

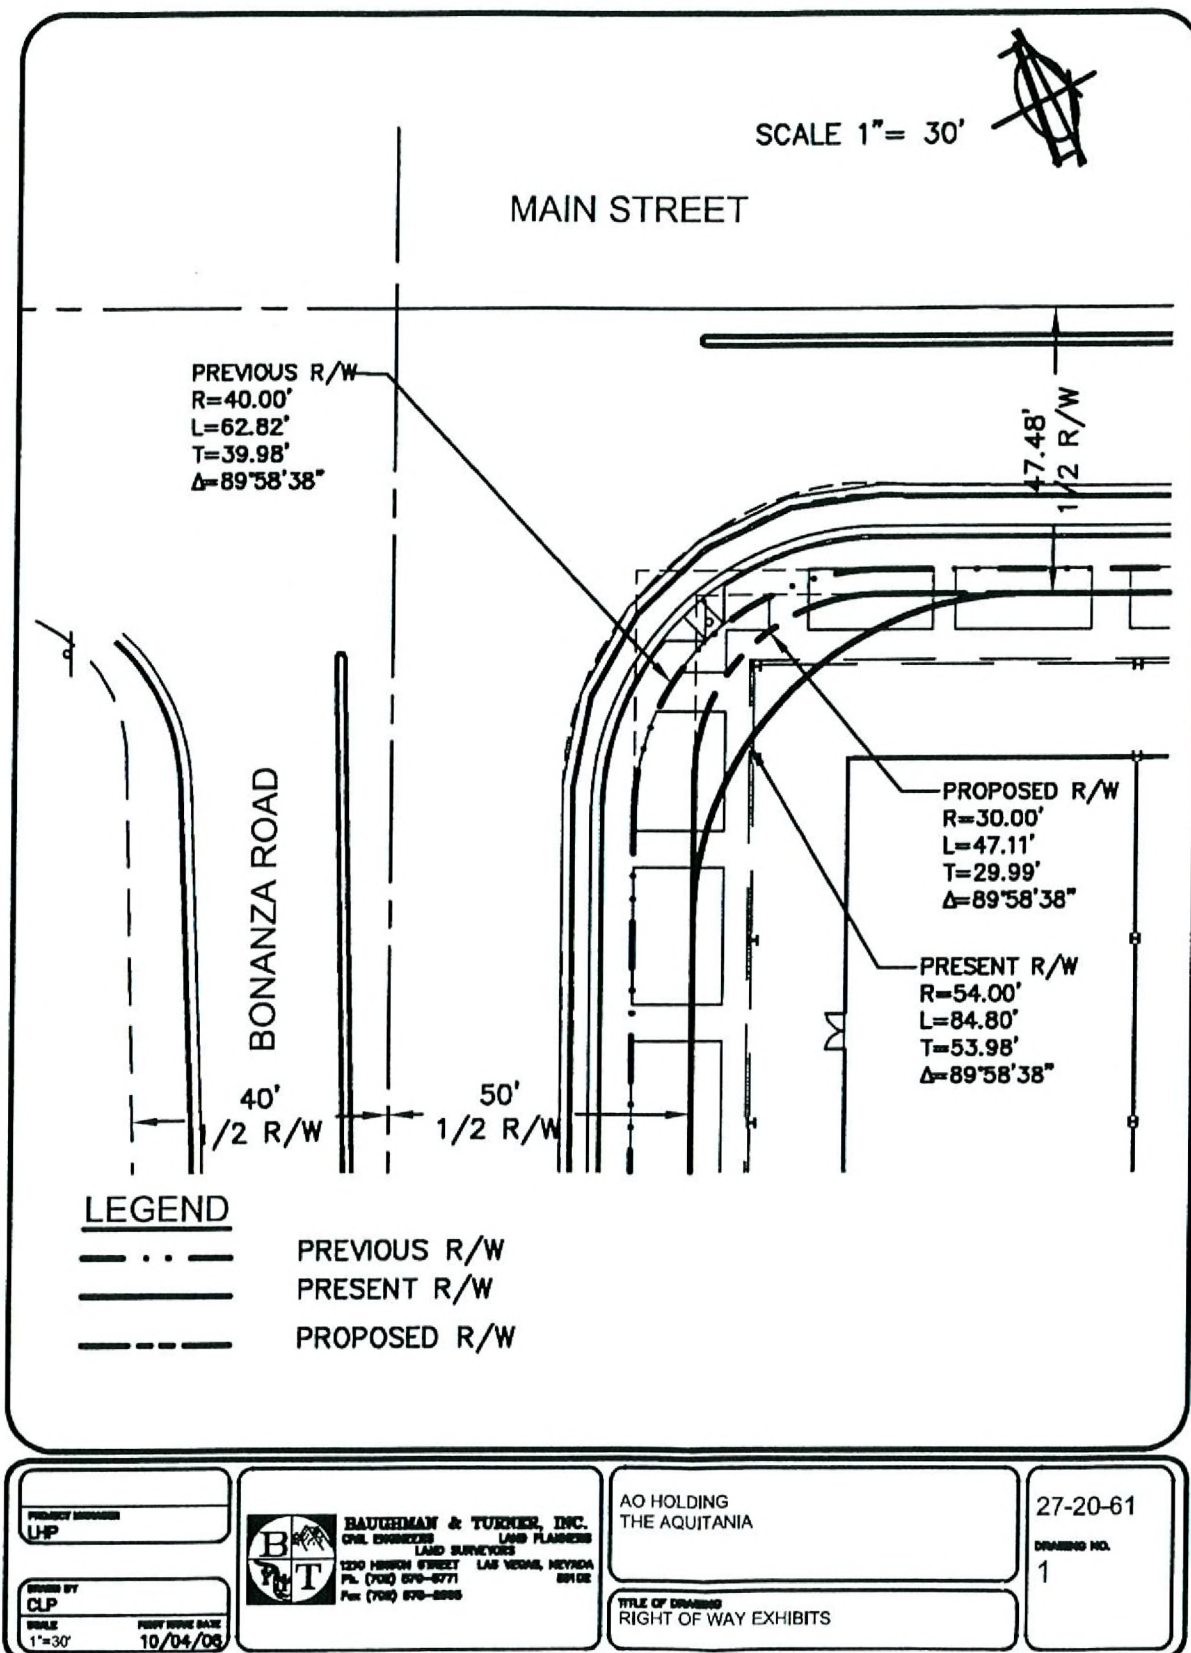

RECEIVED VAC-18045
NOV 6 7 2006
12/21/06 PC



VAC-18045 - APPLICANT/OWNER: THE AQUITANIA CORPORATION
NORTHEAST CORNER OF MAIN STREET AND BONANZA ROAD
DECEMBER 21, 2006 PLANNING COMMISSION

11/22/06



VAC-18045 - APPLICANT/OWNER: THE AQUITANIA CORPORATION
NORTHEAST CORNER OF MAIN STREET AND BONANZA ROAD
DECEMBER 21, 2006 PLANNING COMMISSION

11/22/06