


NO SITE LANDSCAPING
LANDSCAPING WAIVER REQUIRED
APARTMENT COMPLEX


[illegible]

SITE PLAN
SCALE: 1" = 20'-0"

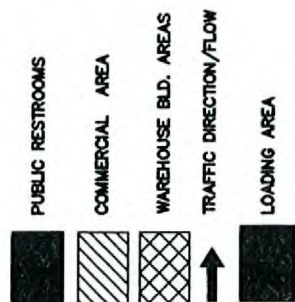

PARKING AREAS	
# REGULAR SPACES	39 SPACES
# ACCESSIBLE SPACES	2 SPACES
TOTAL SPACES	41 SPACES

NEIGHBORHOOD MAP

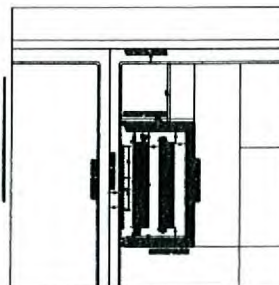

APARTMENT COMPLEX

COMMERCIAL PROPERTY

NOTE: RENTERS OF STORAGE SPACES PARK FOR LOADING
AND UN-LOADING PURPOSES ONLY **VAR-18625**

VAR-18625

REVISED
02/22/07 PC


RECEIVED
FEB 01 2017
SITE-REV

PROPOSED SITE PLAN


DEBOARD CONSTRUCTION COMPANY
GENERAL CONTRACTOR LLC, 49004
800 KILBURN BLVD SUITE 208
PHONE (703) 878-7575, FAX (703) 878-4288

LA FERIA INVESTMENT PROPERTIES, LLC
STORAGE/WAREHOUSE IMPROVEMENT
3831 PENWOOD AVE
LAS VEGAS, NEVADA 89102


COMMERCIAL PROPERTY

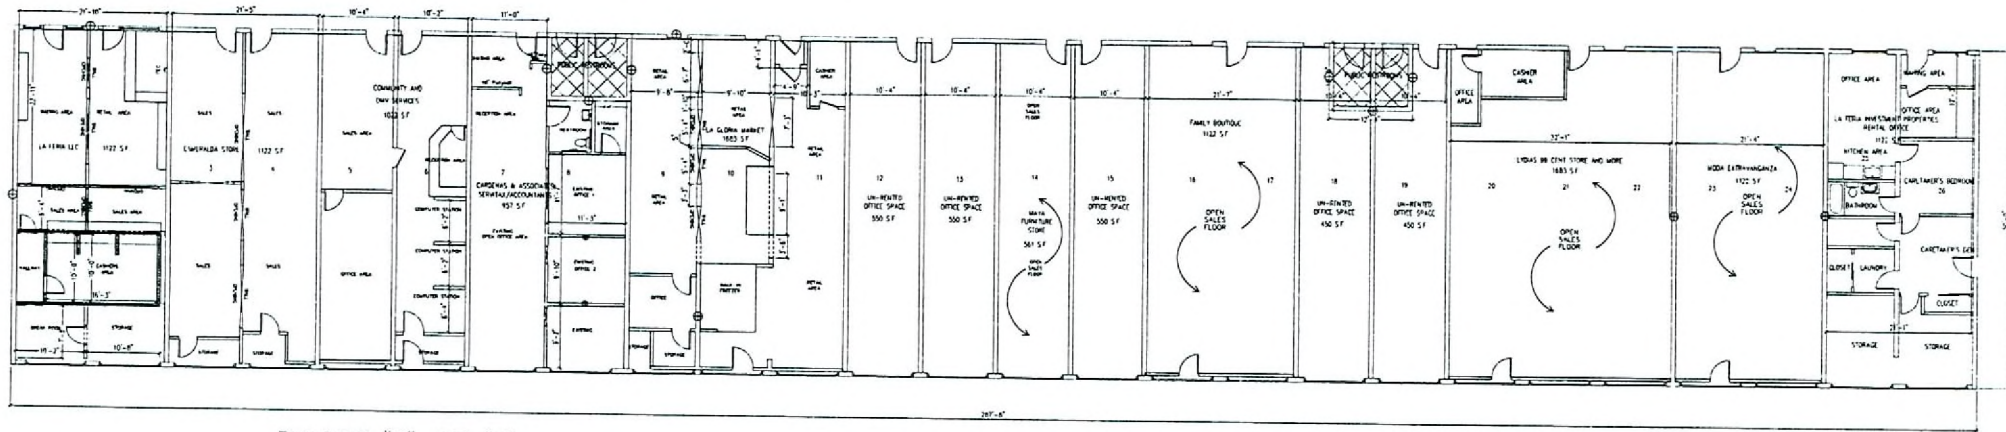[illegible]


**VAR-18625
REVISED
02/22/07 PC**

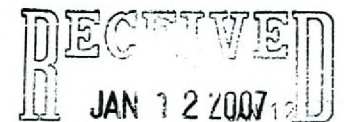


BUILDING "A"
SCALE: AS DIMENSIONED

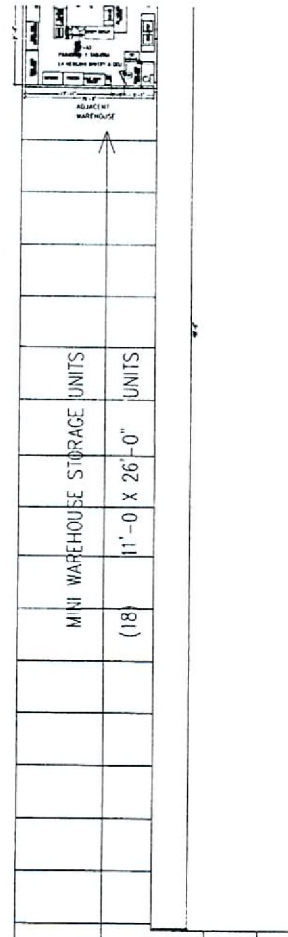

BUILDING "G"
SCALE: AS DIMENSIONED

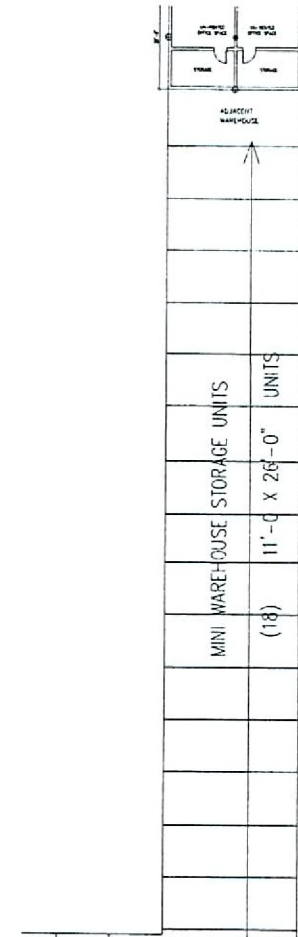

BUILDING "F"
SCALE: AS DIMENSIONED

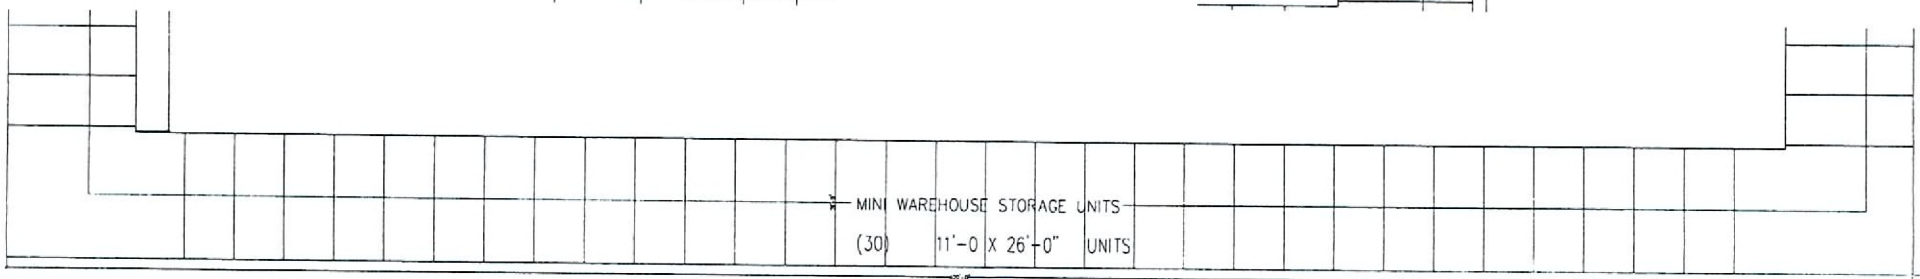

VAR-18625
REVISED
02/22/07 PC

RECEIVED
JAN 22 2007