



PLANNING & DEVELOPMENT DEPARTMENT

STATEMENT OF FINANCIAL INTEREST

Case Number: ROC-182600 APN: 139-27-401-031

Name of Property Owner: City Parkway IV

Name of Applicant: CBS Outdoor

To the best of your knowledge, does the Mayor or any member of the City Council or Planning Commission have any financial interest in this or any other property with the property owner, applicant, the property owner or applicant's general or limited partners, or an officer of their corporation or limited liability company?

☐ Yes

☒ No

If yes, please indicate the member of the City Council or Planning Commission who is involved and list the name(s) of the person or persons with whom the City Official holds an interest. Also list the Assessor's Parcel Number if the property in which the interest is held is different from the case parcel.

City Official: _____

Partner(s): _____

APN: _____



Signature of Property Owner: _____

Print Name: Douglas Selby


Subscribed and sworn before me

This 7 day of November, 2006

Kim A. Barrera
Notary Public in and for said County and State

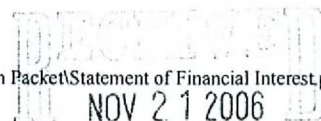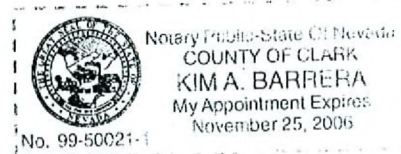

L-36-26-01
J&B

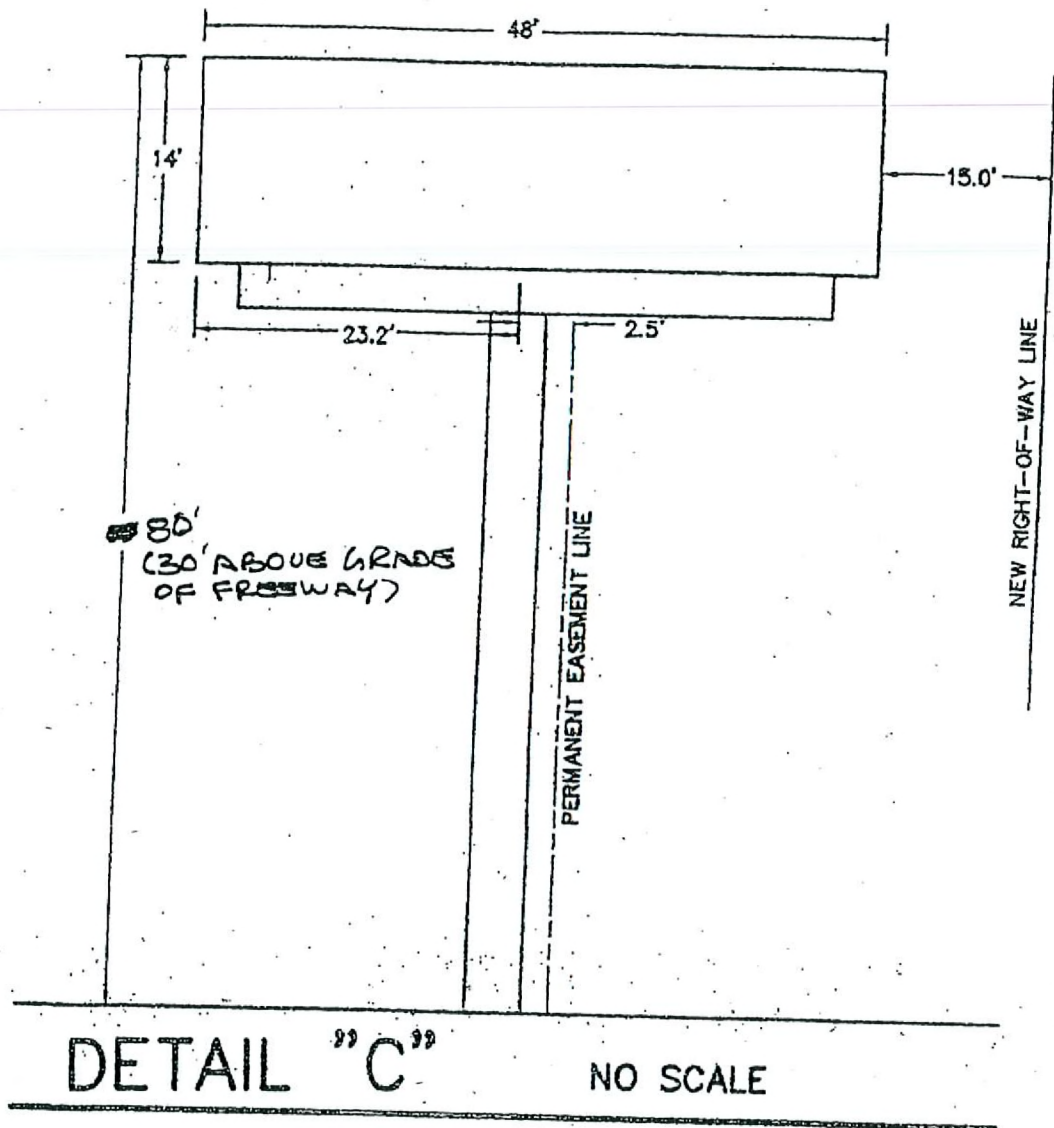


Spag bowl

ROC-18260
05-02-07 CC

NOV 21

SIGN ELEVATION

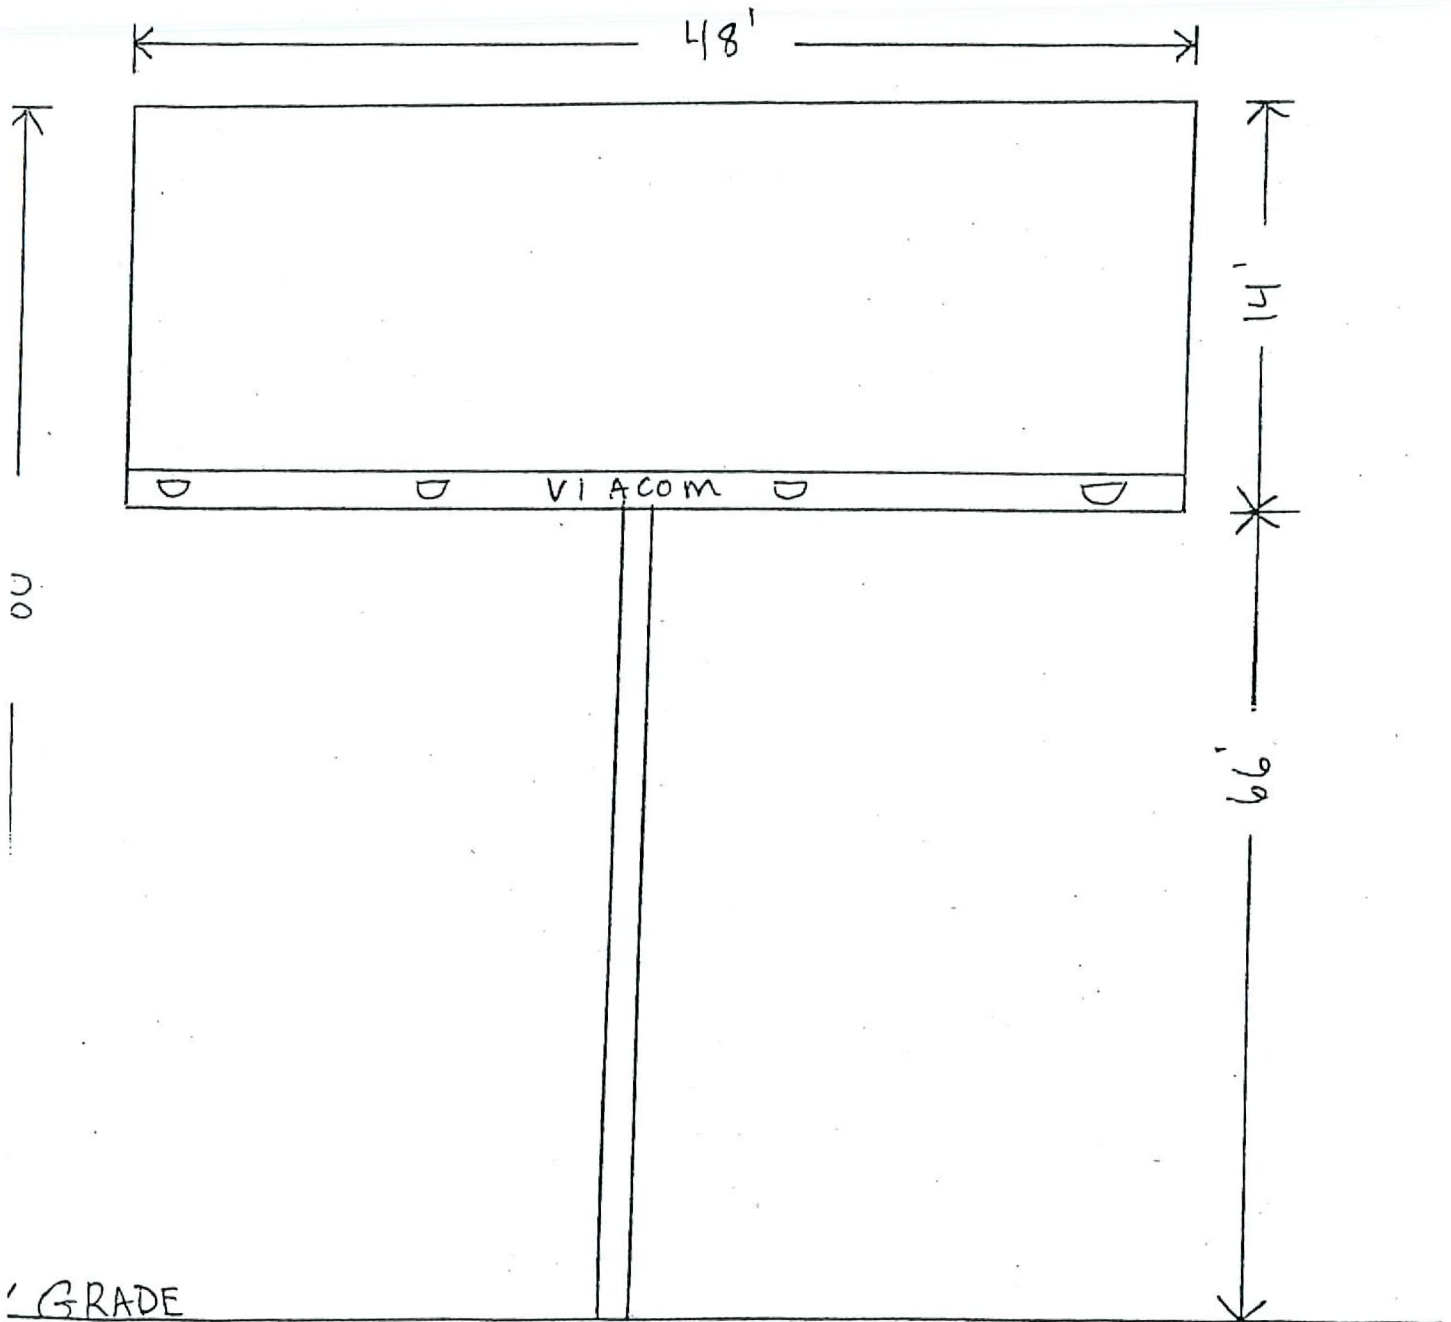

ROC-18260

05-02-07 CC

NOV 21 2006