

PLANNING & DEVELOPMENT DEPARTMENT

STATEMENT OF FINANCIAL INTEREST

Case Number: **SUP-22488** APN: 137-34-818-002
Name of Property Owner: Howard Hughes Corp
Name of Applicant: Linda Ann Poole

To the best of your knowledge, does the Mayor or any member of the City Council or Planning Commission have any financial interest in this or any other property with the property owner, applicant, the property owner or applicant's general or limited partners, or an officer of their corporation or limited liability company?

 Yes No

If yes, please indicate the member of the City Council or Planning Commission who is involved and list the name(s) of the person or persons with whom the City Official holds an interest. Also list the Assessor's Parcel Number if the property in which the interest is held is different from the case parcel.

City Official: _____

Partner(s): _____

APN: _____

Signature of Property Owner: Linda Ann Poole
Print Name: Linda Ann Poole

Subscribed and sworn before me

This 28TH day of JUNE, 2007

Linda Hartman-Maynard
Notary Public in and for said County and State



PLANNING & DEVELOPMENT DEPARTMENT

STATEMENT OF FINANCIAL INTEREST

Case Number: **SUP-22488** APN: 137-34-818002

Name of Property Owner: HOWARD HUGHES CORP.

Name of Applicant: MARK RICH & LINDA POOLIE

To the best of your knowledge, does the Mayor or any member of the City Council or Planning Commission have any financial interest in this or any other property with the property owner, applicant, the property owner or applicant's general or limited partners, or an officer of their corporation or limited liability company?

 Yes No

If yes, please indicate the member of the City Council or Planning Commission who is involved and list the name(s) of the person or persons with whom the City Official holds an interest. Also list the Assessor's Parcel Number if the property in which the interest is held is different from the case parcel.

City Official: _____

Partner(s): _____

APN: _____

Signature of Property Owner: [Handwritten Signature]

Print Name: Kevin T. Orrock

RECEIVED
JUL 3 10 05 AM '07
PLANNING & DEVELOPMENT

Subscribed and sworn before me

This 2nd day of July, 2007

Shirley Wing
Notary Public in and for said County and State





PLANNING & DEVELOPMENT DEPARTMENT

STATEMENT OF FINANCIAL INTEREST

Case Number: **SUP-22488** APN: 137-34-818-002

Name of Property Owner: _____

Name of Applicant: MARK RICH

Name of Representative: _____

To the best of your knowledge, does the Mayor or any member of the City Council or Planning Commission have any financial interest in this or any other property with the property owner, applicant, the property owner or applicant's general or limited partners, or an officer of their corporation or limited liability company?

_____ Yes X No

If yes, please indicate the member of the City Council or Planning Commission who is involved and list the name(s) of the person or persons with whom the City Official holds an interest. Also list the Assessor's Parcel Number if the property in which the interest is held is different from the case parcel.

City Official: _____

Partner(s): _____

APN: _____


Signature of Property Owner: [Handwritten Signature]

Print Name: Mark Rich

Subscribed and sworn before me

This 30th day of MAY, 2007

[Handwritten Signature]
Notary Public in and for said County and State

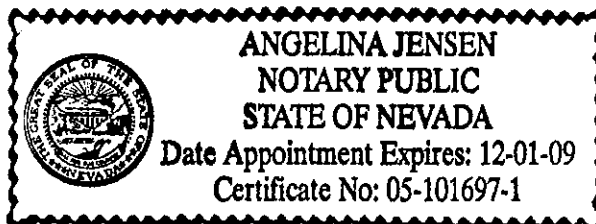

RECEIVED
JUN 08 7007

General Growth Properties, Inc.
110 North Wacker Drive
Chicago, Illinois 60606





VISTA COMMONS
ADDRESS
BLDG. NO. 111
DATE

WSP-1

SUP-22488
07/26/07 PC



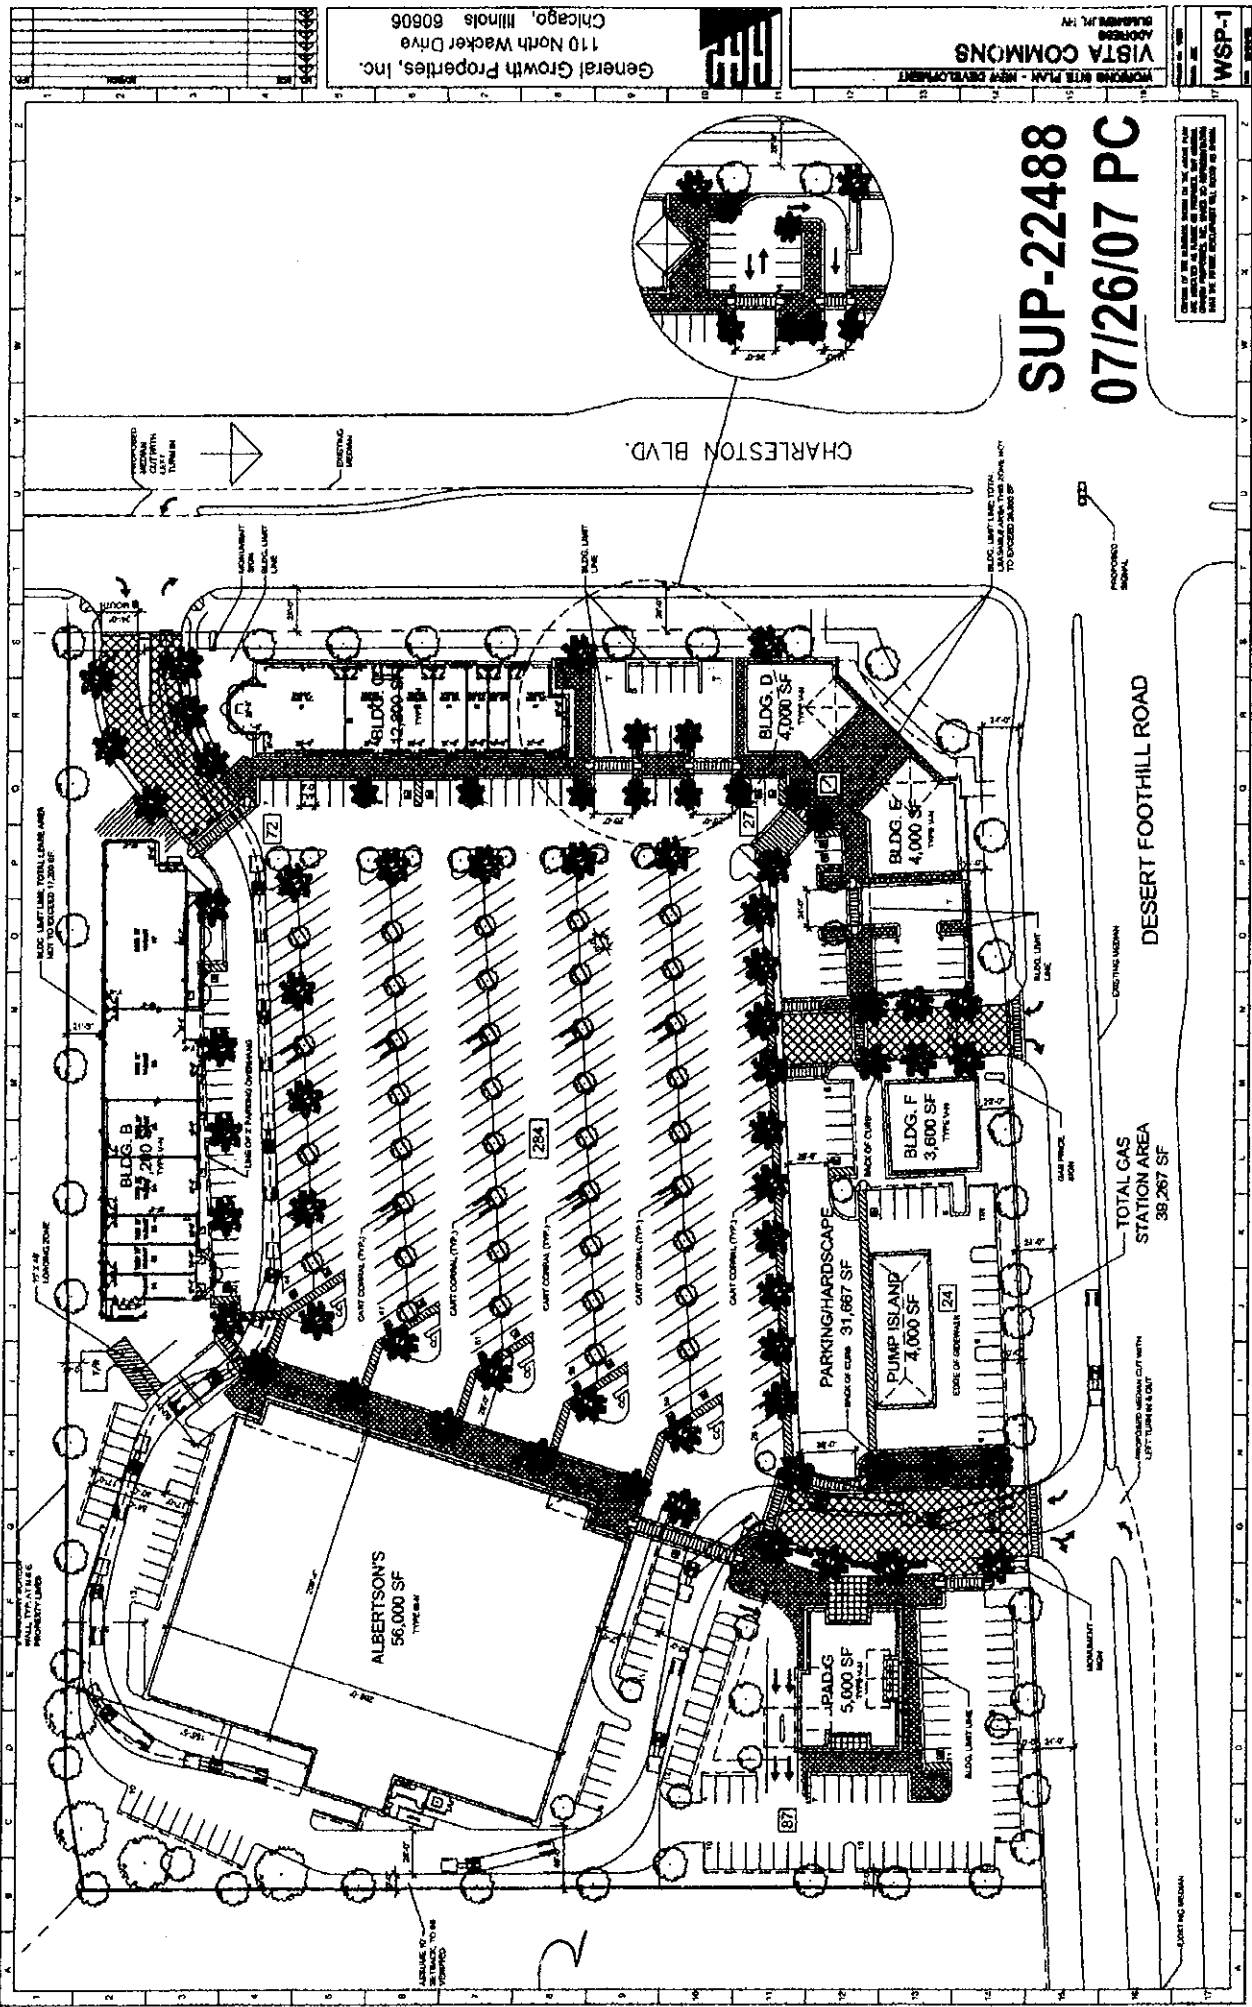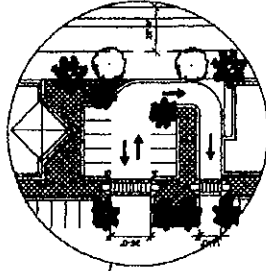

RECEIVED

JUN 08 2007

S
39'

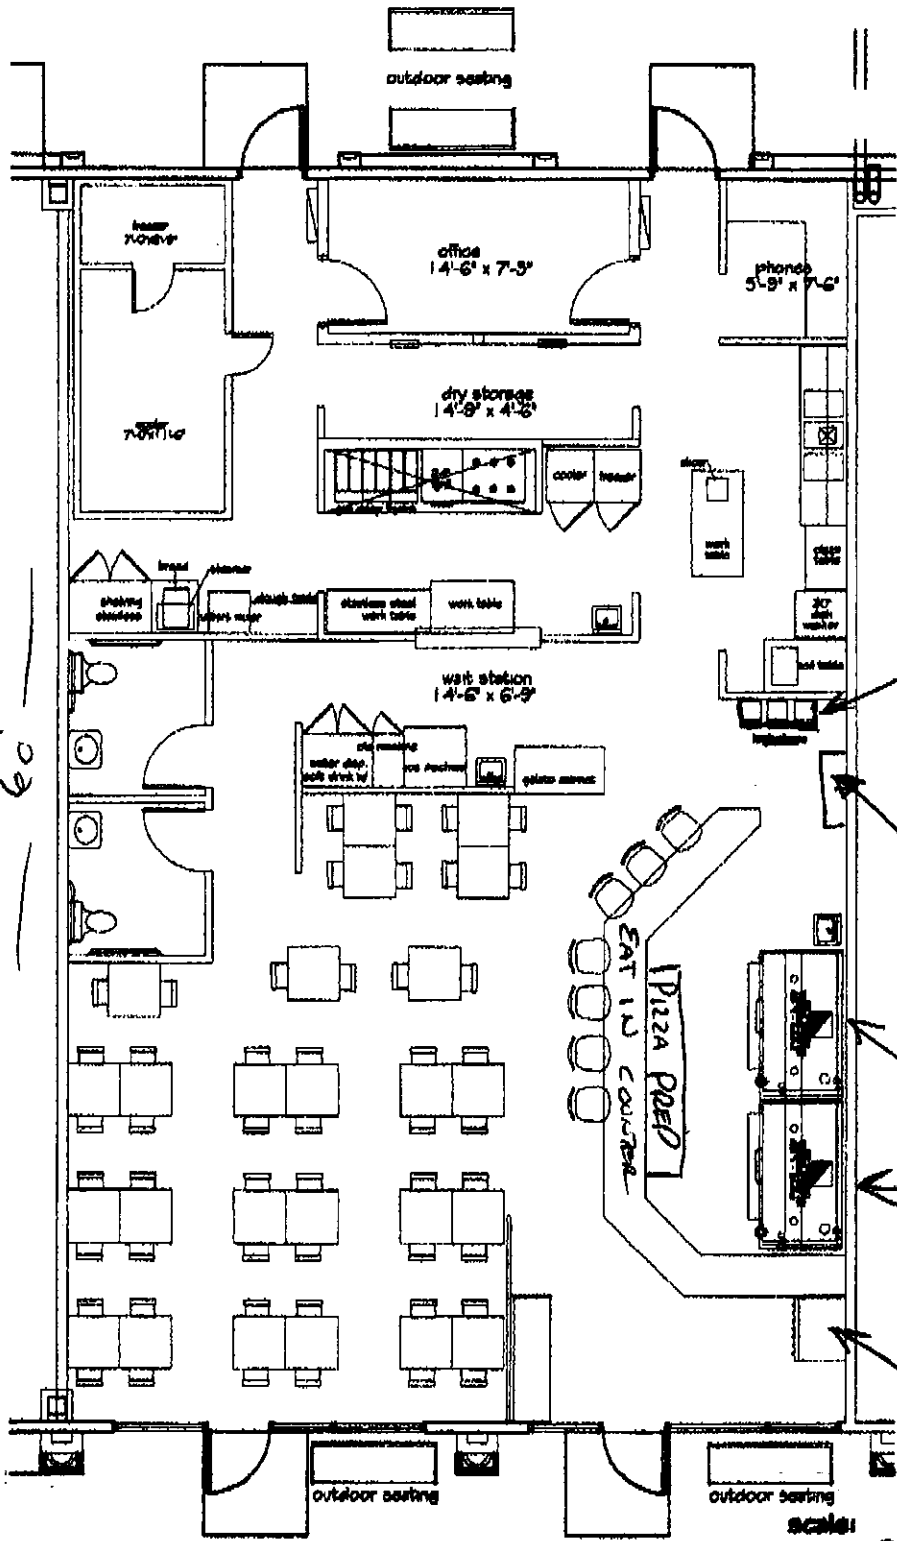

LOP 21"

BEER & WINE LAFS

PIZZA QUEUES

SODA

New York Pizza II

57- SIT DOWN

SUP-22488
REVISED
07/26/07 PC

N
JUN 17 2007

scale: 1/8"
date: 3.27.07
commercial design group