


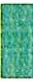










**MAP ELEVEN**  
**City of Las Vegas**  
**CENTENNIAL HILLS**  
**SECTOR**


Existing and Approved  
 Power Lines

-  Existing Power Lines
-  Existing Substations
-  Approved Power Lines
-  Approved Substations
-  Proposed Power Line
-  Proposed Substation
-  Existing Power Line to be removed
-  Proposed Substation to be removed

Adopted December 18, 1996 Bill Number 96-109

- Revised May 24, 1999 GPA-01-99
- Revised February 19, 2003 GPA-1392
- Revised May 19, 2004 GPA-4044
- Revised June 07, 2006 GPA-12339
- Revised June 21, 2006 GPA-12271

Source: Nevada Power Company as of May 26, 2004

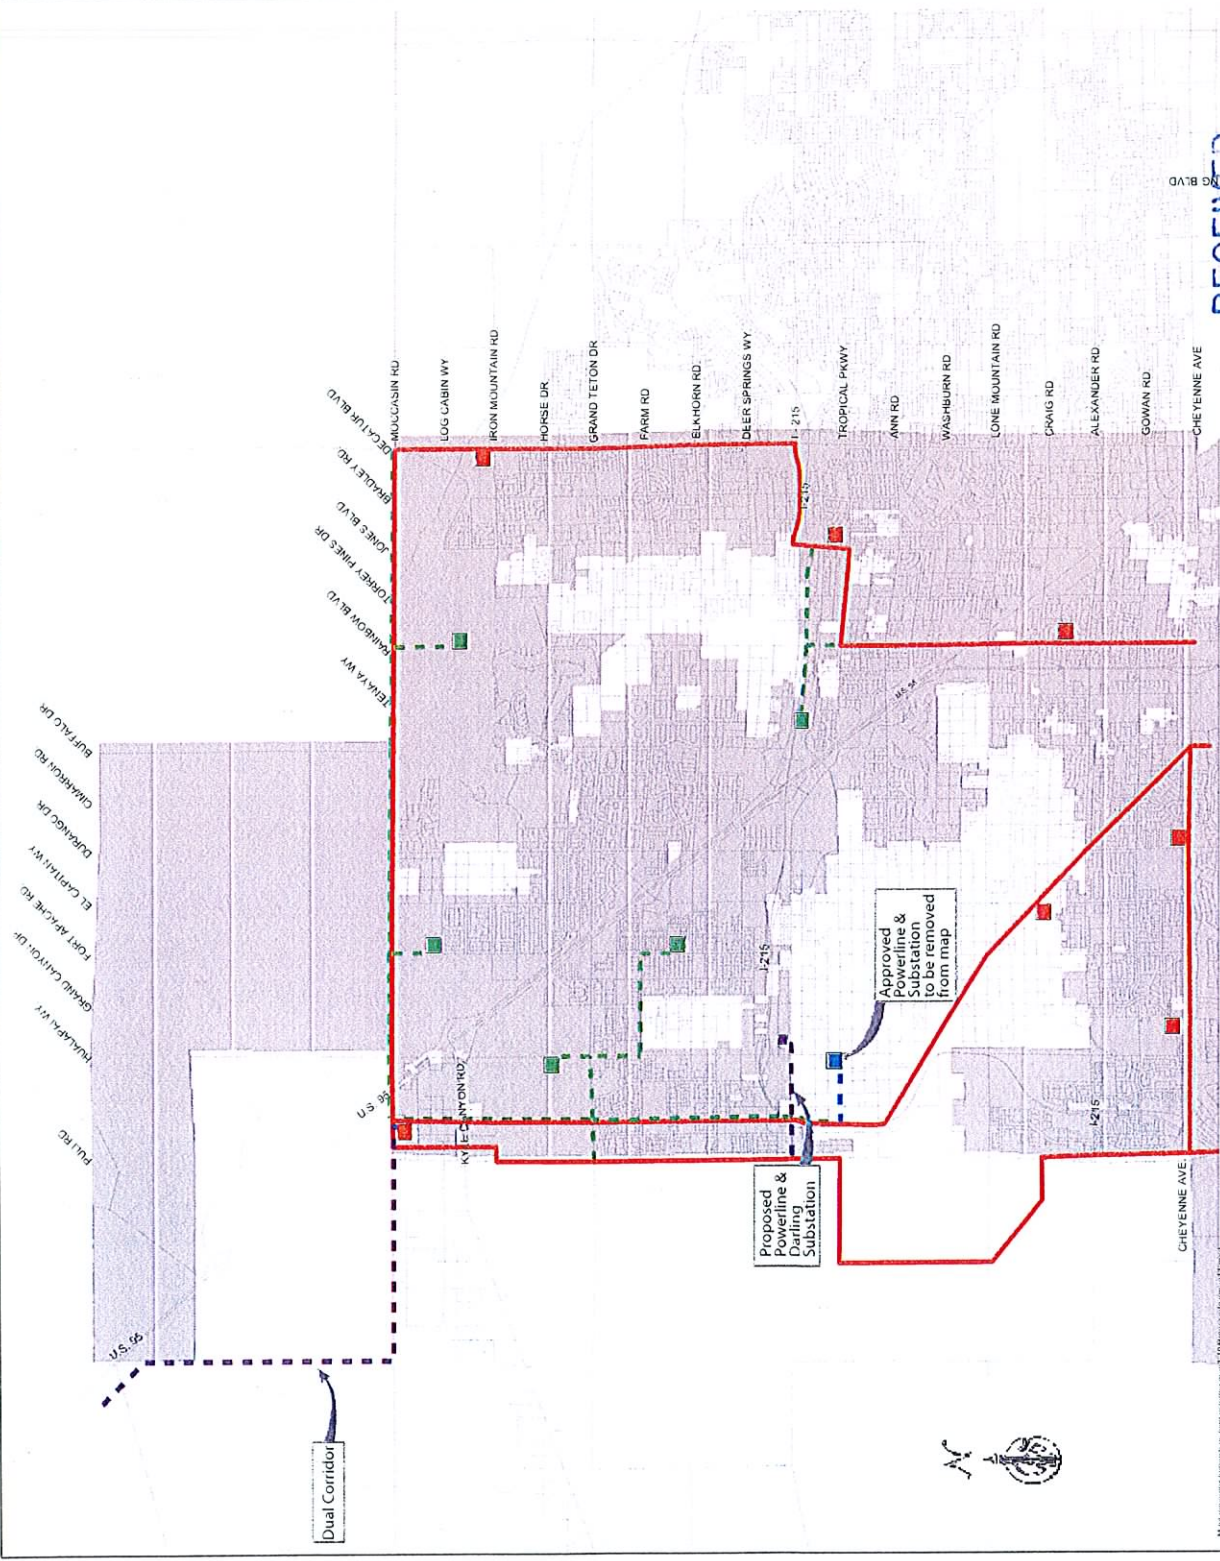

**RECEIVED**

JUN 08 2007

**GPA-22505**  
**07/26/07 PC**