




Case Number: **ZON-20482** APN: 139-32-501-001


First Christian

290819v1

APR 24 2007

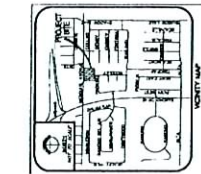

MESQUITE AVENUE

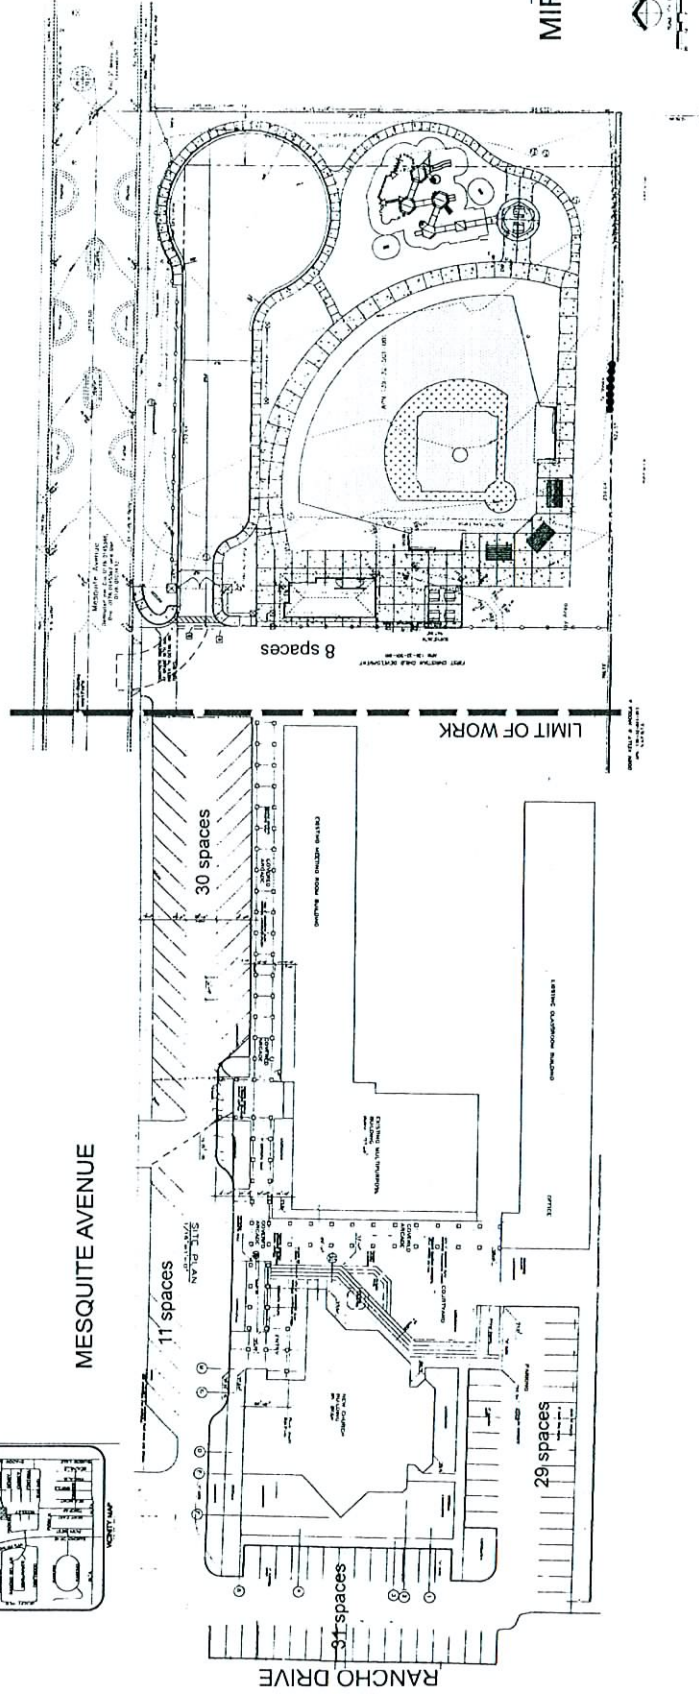



ENGINEER

CONSTRUCTION NOTES

AC CONCRETE SECTION

APN 139-32-301-001

MIRACLE LEAGUE

BALL PARK

APN 139-32-301-001

LC-EXHIBIT

Call

Overhead

Dig






GPA-20481 ZON-20482
SDR-20483 REVISED
05/10/07 PC

APR 30 2007



ZON-20482 SDR-20483
REVISED 05/10/07 PC