


[illegible]

Site Data

[illegible]

General Notes

1	CONTRACTOR TO FIELD VERIFY ALL CONDITIONS PRIOR TO CONSTRUCTION
2	ANY DISCREPANCY BETWEEN CIVIL DRAWINGS AND FIELD CONDITIONS OR ARCHITECTURAL SITE PLAN SHOULD BE BROUGHT TO THE ARCHITECT'S ATTENTION IMMEDIATELY.
3	REFER TO CIVIL FOR HORIZONTAL CONTROL.
4	REFER TO LANDSCAPE FOR PLANTING AND PLACING BEO
5	REFER TO CIVIL DRAWINGS FOR REIN AND ADDITIONAL REIN TO BE INSTALLED

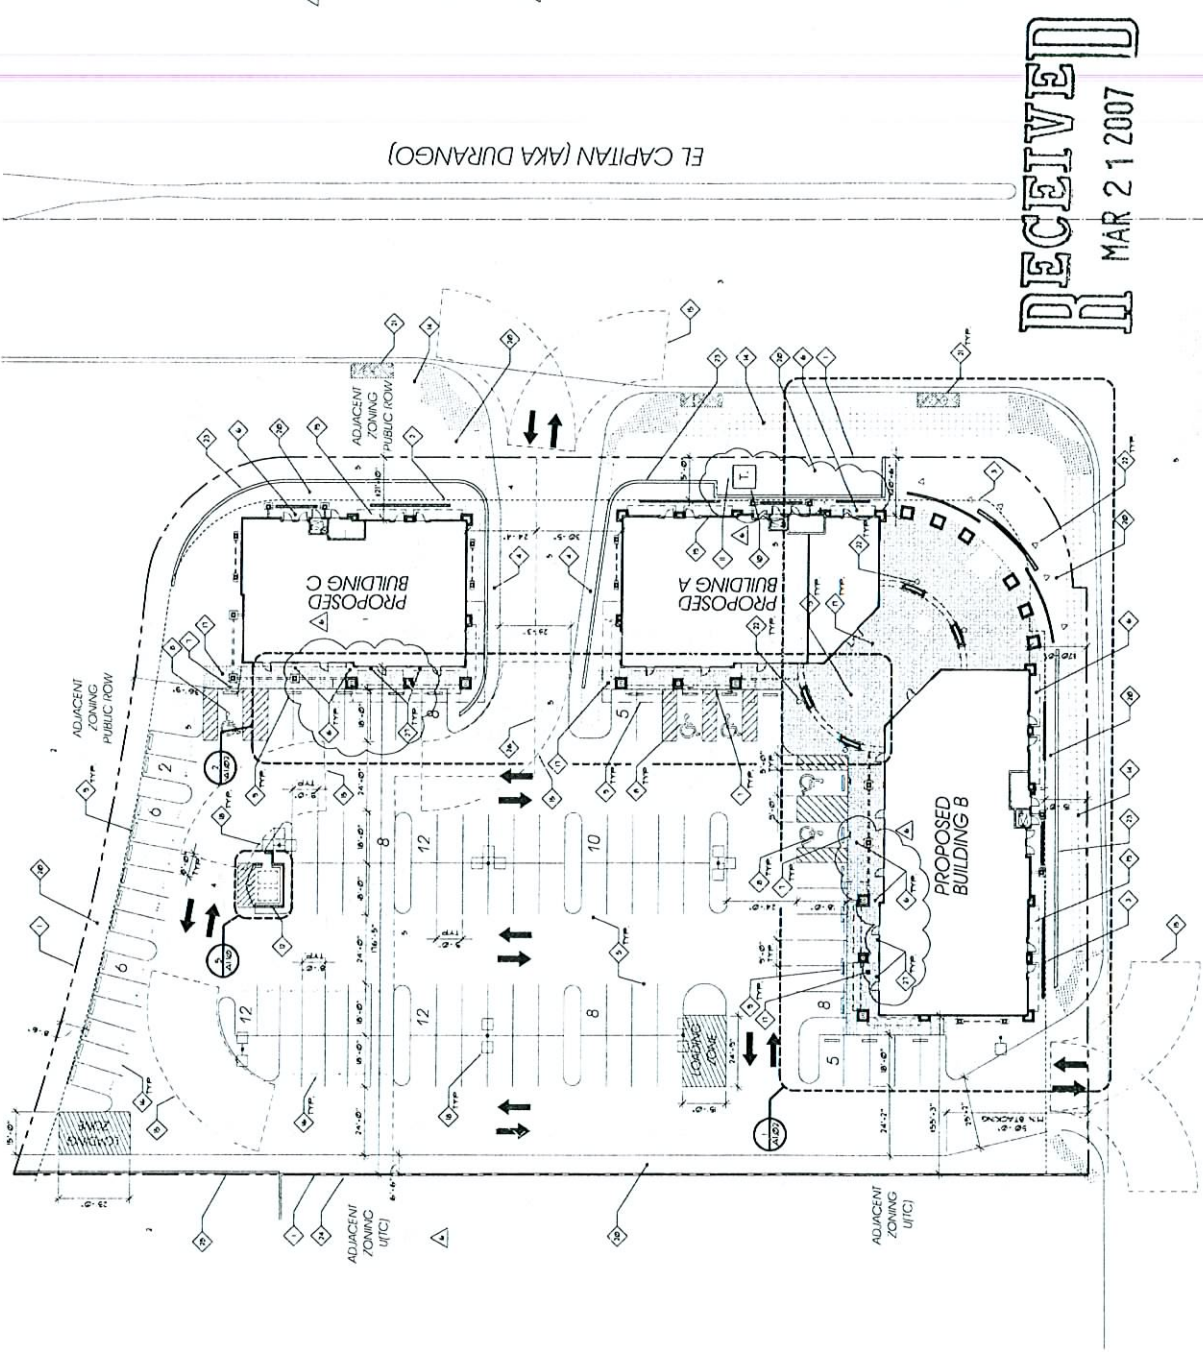

RECEIVED
MAR 21 2007

Architectural Site Plan

CENTENNIAL PARKWAY

SUP-20608
04/26/07 PC

Keynotes

1. THREE COAT EXTERIOR GROUT IN WATER AND PAINT OVER PAINTED SURFACE. LATH, PLASTER AND FINISH.
2. ROOF LINE DETAIL.
3. ROOF LINE DETAIL.
General Notes

1. ELEVATION REFERENCES TO NORTH, SOUTH, EAST, WEST, AND CENTER OF BUILDING.
2. SEE ADJUST FOR BUILDING ELEVATIONS.
3. SEE ADJUST FOR BUILDING ELEVATIONS.

Materials & Colors

DESIGNED IN SAND ON BUT NOT LIMITED TO BUILDING


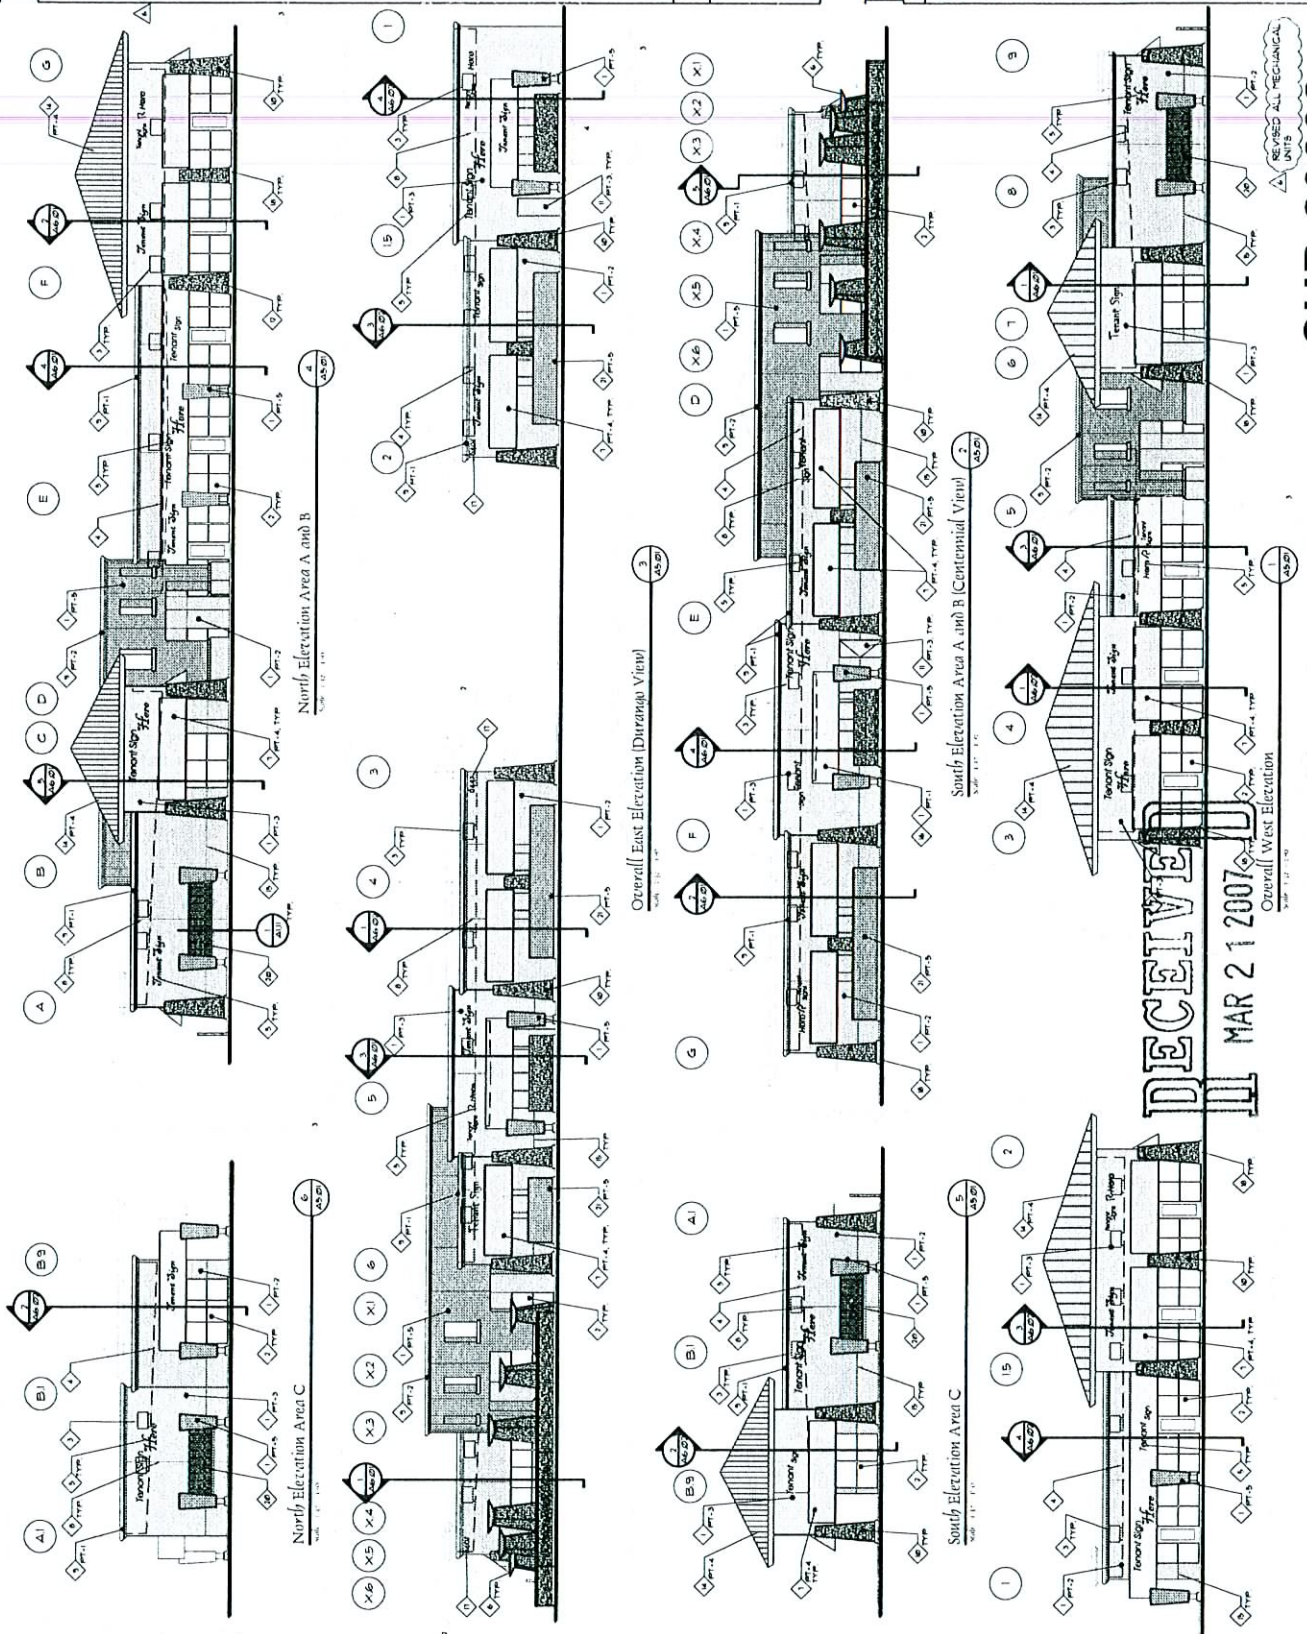

SUP-20608
04/26/07 PC




Overall Floor Plan

Durango and Centennial Center
El Capitan Way Durango at Centennial Parkway

Project No. 05-45
Construction Owner VE Change 02/15/07
Contract Change 12-12-07
Public Works Project Construction No. 05-45

Sheet No. A2.01
Date: February 23, 2008
By: A. Ford
Check: N/A

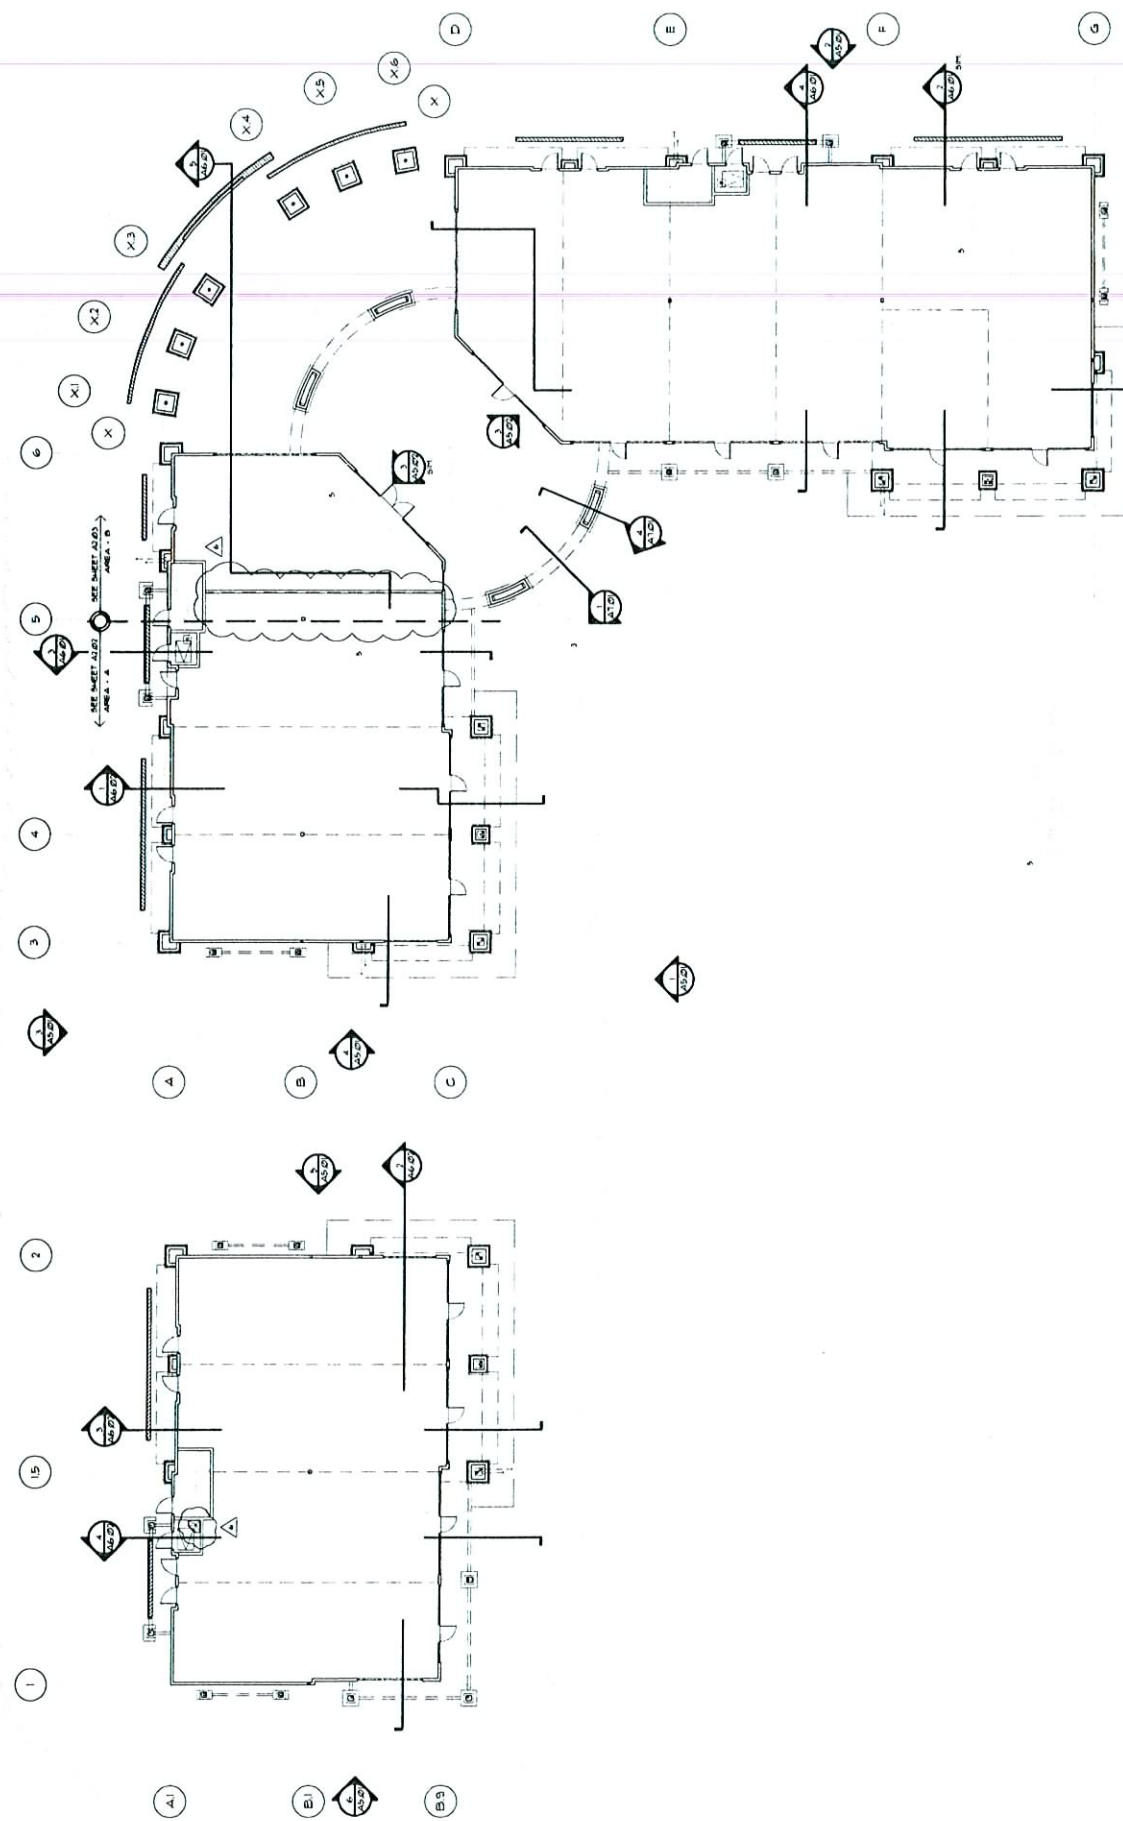

RECEIVED
MAR 21 2007

Overall Floor Plan

SUP-20608
04/26/07 PC



SUP-20608 - APPLICANT: CASHBACK - OWNER: DURANGO & CENTENNIAL, LLC
6441 NORTH DURANGO DRIVE, SUITE #120
APRIL 26, 2007 PLANNING COMMISSION

03/26/07



SUP-20608 - APPLICANT: CASHBACK - OWNER: DURANGO & CENTENNIAL, LLC
6441 NORTH DURANGO DRIVE, SUITE #120
APRIL 26, 2007 PLANNING COMMISSION

03/26/07